ROOF ASSEMBLIES

TYPE	ASSEMBLY	CONSTRUCTION	NOTES
R1	← SLOPE 2% MIN	**2-PLY** 2-PLY MOD-BIT ROOFING MEMBRANE 13mm COVER BOARD TAPERED INSULATION WHERE INDICATED ON ROOF PLAN 75mm POLYISOCYANURATE FOAM INSULATION BOARD 100mm POLYISOCYANURATE FOAM INSULATION BOARD PEEL & STICK VAPOUR BARRIER 75mm STRUCTURAL STEEL DECKING (REFER TO STRUCTURAL)	*ADD GREEN ROOF ASSEMBLY WHERE INDICATED ON ROOF PLAN
R2	SLOPE 2% MIN	**2-PLY (1-HR FRR):** 43mm WOOD DECK TILES ON PEDESTALS 2-PLY MOD-BIT ROOFING MEMBRANE 13mm COVER BOARD TAPERED INSULATION WHERE INDICATED ON ROOF PLAN 75mm POLYISOCYANURATE FOAM INSULATION BOARD 100mm POLYISOCYANURATE FOAM INSULATION BOARD PEEL & STICK VAPOUR BARRIER 165mm 90mm CONCRETE TOPPING ON 75mm STRUCTURAL STEEL DECKING (REFER TO STRUCTURAL)	*1 HR FRR REQUIRED 17
R3		**2-PLY AT CANOPY** 2-PLY MOD-BIT ROOFING MEMBRANE 19mm DECK SHEATHING STRUCTURAL STEEL DECKING (REFER TO STRUCTURAL)	

CEILING ASSEMBLIES

TYPE	ASSEMBLY	CONSTRUCTION	NOTES
CLG1	76	16mm GYPSUM BOARD 22mm METAL FURRING CHANNELS 38mm METAL CARRYING CHANNELS	REFER TO FINISH SCHEDULE FOR CEILINGS THAT RECEIVE PAINT FINISH AND WHICH ARE LEFT UNPAINTED
CLG2	17 79	19mm ACOUSTIC WOOD CEILING PANEL SYSTEM W/ CONCEALED FASTENING & T&G SYSTEM 75mm ACOUSTIC BATT INSULATION 22mm METAL HAT CHANNELS 38mm METAL CARRYING CHANNELS	REFER TO SPECIFICATIONS FOR ACOUSTIC PANEL PRODUCT AND MANUFACTURERS INSTALLATION REQUIREMENTS
CLG3	52	TILE SIZES VARY (1220 x 610mm TYPICAL) PREFINISHED ALUM TRIM EDGES AT ALL EDGES NOT SECURED TO WALLS	ACT.1, REFER TO SPECIFICATIONS AND RCP FOR APPROPRIATE LAYOUTS NRC: 0.95 CAC: 26
CLG4	92	2 - 16mm TYPE X GYPSUM BOARD 22mm METAL FURRING CHANNELS 38mm METAL CARRYING CHANNELS	THIS ASSEMBLY IS ASSIGNED A 1HR FIRE RESISTANCE BASED ON O.B.C 3.1.7.1 (2), SB-2 2.3.12
CLG5	17 226	19x150mm WOOD SLATS W/ CONCEALED FASTENING ASSEMBLY CONT. BLACK FABRIC BACKING 16mm WOOD BACKER ASSEMBLY 22mm METAL FURRING CHANNELS 38mm METAL CARRYING CHANNELS	INCL. SUSPENSION WIRE AND ACCESSORIES, SUPPORT CHANNELS TO BE PAINT FINISHED TO MATCH METAL DECK ABOVE WHERE EXPOSED PAINT PAINT FINISH ON ALL M&E SERVICES, STRUCTURAL ELEMENTS, DECK AND BEAMS, PERIMETER BULKHEADS, ALL SUPPORT FRAMING, STRUTS, WALLS ABOVE CEILING. ALL ELECT, SECURITY, DATA SERVICES PASSING THROUGH THIS AREA TO BE CONCEALED IN CONDUIT OR TRAYS. (TYPICAL ABOVE CLG5)
CLG6	200	200mm ACOUSTIC BAFFLES (13mm THICK) SUSPENDED CLIP SYSTEMS TO U/S STRUCTURE	REFER TO SPECIFICATIONS FOR ACOUSTIC PANEL PRODUCT AND MANUFACTURERS INSTALLATION REQUIREMENTS
CLG7	89	13mm ACOUSTIC TREATMENT PANELING 16mm GYPSUM BOARD 22mm METAL FURRING CHANNELS 38mm METAL CARRYING CHANNELS	REFER TO SPECIFICATIONS FOR ACOUSTIC TREATMENT LAMINATED TO GYPSUM BOARD

EXTERIOR SOFFIT ASSEMBLIES

TYPE	ASSEMBLY	CONSTRUCTION	NOTES
SF1	160	**WOOD FINISH INSULATED SOFFIT** 19mm CEDAR WOOD SOFFIT PANELS 25mm AIR SPACE 100mm RIGID INSULATION /THERMAL SPACERS CONTINUOUS AIR/VAPOUR BARRIER MEMBRANE 16mm EXTERIOR GYPSUM BOARD SHEATHING 102mm ENGINEERED STEEL STUDS	17
SF2	41	**WOOD FINISH SOFFIT** 19mm CEDAR WOOD SOFFIT PANELS 22mm FURRING/FRAMING CHANNELS (WHERE REQUIRED) 102mm ENGINEERED METAL STUDS	SECURED DIRECTLY TO STRUCTURAL STEEL AND ENGINEERED FRAMING, PERIMETER 50x50mm FINISHED CEDAR WOOD TRIM
SF3	160	**ALUMINUM FINISH INSULATED SOFFIT** 19mm ALUMINUM SOFFIT PANELS 25mm AIR SPACE 100mm RIGID INSULATION /THERMAL SPACERS CONTINUOUS AIR/VAPOUR BARRIER MEMBRANE 16mm EXTERIOR GYPSUM BOARD SHEATHING 102mm ENGINEERED STEEL STUDS	FINISH (PRINT) TO MATCH WOOD FINISH, REFER TO SPECIFICATIONS
SF4	143	**ALUMINUM FINISH SOFFIT** 19mm ALUMINUM SOFFIT PANELS 22mm FURRING/FRAMING CHANNELS 102mm ENGINEERED STEEL STUDS	FINISH (PRINT) TO MATCH WOOD FINISH, REFER TO SPECIFICATIONS

INTERIOR WALL ASSEMBLIES

TYPE	ASSEMBLY	CONSTRUCTION	NOTES
P1	140	140mm CONCRETE MASONRY UNIT WALL.	
P2	190	190mm CONCRETE MASONRY UNIT WALL.	
P3	240	240mm CONCRETE MASONRY UNIT WALL.	
P4	96	16mm GYPSUM WALL BOARD 64mm METAL STUDS @ 400mm O/C MAX. 16mm GYPSUM WALL BOARD	
P5	184	16mm GYPSUM WALL BOARD 152mm METAL STUDS @ 400mm O/C MAX. 16mm GYPSUM WALL BOARD	REFER TO ELEVATIONS AND FINISHES DRAWINGS FOR TILE TYPE
P6	235	16mm GYPSUM WALL BOARD 203mm METAL STUDS @ MAX. 600mm @ O.C. MAX. 152mm ACOUSTIC INSULATION 16mm GYPSUM WALL BOARD	REFER TO ELEVATIONS AND FINISHES DRAWINGS FOR TILE TYPE
P7	124	16mm GYPSUM WALL BOARD 92mm METAL STUDS @ 400mm O/C MAX. 92mm ACOUSTIC INSULATION 16mm GYPSUM WALL BOARD	REFER TO ELEVATIONS AND FINISHES DRAWINGS FOR TILE TYPE WHERE APPLICABLE PROVIDE TILE BACKER BOARD IN LIEU OF GYPSUM WALL BOARD IN AREAS TO RECEIVE A TILE FINISH
P8	184	16mm TYPE X GYPSUM WALL BOARD 152mm METAL STUDS @ 400mm O/C MAX. 152mm ACOUSTIC INSULATION 16mm TYPE X GYPSUM WALL BOARD	ULC DESIGN W407 1H FRR STC 56 PROVIDE TILE BACKER BOARD IN LIEU OF GYPSUM WALL BOARD IN AREAS TO RECEIVE A TILE FINISH
P9	100	90mm MASONRY VENEER 10mm MORTAR JOINT CONCRETE WALL (SEE STRUCTURAL)	PROVIDE DOVETAIL INSERTS / ANCHORS, COORDINATE WITH STRUCTURAL
P10		90mm MASONRY VENEER 10mm GAP 152mm ENGINEERED METAL STUD FRAMING ASSEMBLY C/W MASONRY ANCHOR TIES	
P10a		90mm MASONRY VENEER VARIES GAP 152mm ENGINEERED METAL STUD FRAMING ASSEMBLY C/W MASONRY ANCHOR TIES	
P11	168 + 168	16mm GYPSUM WALL BOARD 152mm METAL STUDS @ MAX. 600mm @ O.C. MAX. 152mm ACOUSTIC INSULATION *AIR SPACE AS REQUIRED 152mm METAL STUDS @ MAX. 600mm @ O.C. MAX. 16mm GYPSUM WALL BOARD	*OVERALL DEPTH OF WALL TO ALIGN WITH ADJACENT ASSEMBLIES PROVIDE TILE BACKER BOARD IN LIEU OF GYPSUM WALL BOARD IN AREAS TO RECEIVE A TILE FINISH
P12	124	16mm TYPE X GYPSUM WALL BOARD 92mm METAL STUDS @ 400mm O/C MAX. 92mm ACOUSTIC INSULATION 16mm TYPE X GYPSUM WALL BOARD	ULC DESIGN W407 1H FRR STC 51
P13	168+108	16mm GYPSUM WALL BOARD 152mm METAL STUDS @ MAX. 600mm @ O.C. MAX. 152mm ACOUSTIC INSULATION *AIR SPACE AS REQUIRED 92mm METAL STUDS @ MAX. 600mm @ O.C. MAX. 16mm GYPSUM WALL BOARD	*OVERALL DEPTH OF WALL TO ALIGN WITH ADJACENT ASSEMBLIES

FLOOR ASSEMBLIES

TYPE	ASSEMBLY	CONSTRUCTION	NOTES
FL1	200	**SLAB ON GRADE** FLOOR FINISH (REFER TO RFS) 125mm POURED IN PLACE CONCRETE SLAB ON GRADE (REFER TO STRUCTURAL) CONTINUOUS VAPOUR RETARDER 25mm RIGID INSULATION (R-5) CONT. BELOW SLAB ON GRADE INCREASE RIGID INSULATION ALONG THE EXTERIOR FOUNDATION WALL TO 75mm THICKNESS x 915mm (R-15)	
FL2	VARIES	**CONCRETE SLAB** FLOOR FINISH (REFER TO RFS) 200mm+ POURED IN PLACE SUSPENDED CONCRETE SLAB (THICKNESS VARIES, REFER TO STRUCTURAL)	PROVIDE 38mm SLAB DEPRESSION IN WASHROOMS AND WHERE CT FLOORING IS SCHEDULED
	1.5% MIN AWAY FROM ENTRANCE	**FROST SLAB ON GRADE** 200mm SLOPING POURED IN PLACE CONCRETE SLAB ON GRADE (REFER TO STRUCTURAL) 100mm RIGID INSULATION (R-20) CONT. BELOW SLAB ON GRADE	REFER TO FROST SLAB DETAILS FOR APPLICABLE INFORMATION

EXTERIOR WALL ASSEMBLIES

TYPE	ASSEMBLY	CONSTRUCTION	NOTES
EW1	[Interior] 503 [Exterior]	90mm MASONRY VENEER 25mm AIR CAVITY 152mm SEMI RIGID INSULATION CONTINUOUS AIR/ VAPOUR BARRIER MEMBRANE 16mm EXTERIOR GYPSUM SHEATHING 204mm GALVANIZED ENGINEERED METAL STUDS 16mm GYPSUM WALL BOARD	
EW2	[Interior] 503 [Exterior]	90mm MASONRY VENEER 25mm AIR CAVITY 152mm SEMI RIGID INSULATION CONTINUOUS AIR/ VAPOUR BARRIER MEMBRANE 16mm EXTERIOR GYPSUM SHEATHING 204mm GALVANIZED ENGINEERED METAL STUDS 16mm TYPE X GYPSUM WALL BOARD	1HR FRR ASSEMBLY
EW3	[Interior] 453 [Exterior]	40mm METAL SIDING 25mm AIR / Z-GIRTS 152mm SEMI RIGID INSULATION, THERMAL CLIPS CONTINUOUS AIR/ VAPOUR BARRIER MEMBRANE 16mm EXTERIOR GYPSUM SHEATHING 204mm GALVANIZED ENGINEERED METAL STUDS 16mm TYPE X GYPSUM WALL BOARD	1HR FRR ASSEMBLY
EW4	[Interior] 217 [Exterior]	40mm METAL SIDING 25mm AIR / Z-GIRTS 152mm SEMI RIGID INSULATION, THERMAL CLIPS CONTINUOUS AIR/ VAPOUR BARRIER MEMBRANE VARIES CONCRETE WALL (SEE STRUCTURAL)	1HR FRR ASSEMBLY
EW5	[Interior] 267 [Exterior]	90mm MASONRY VENEER 25mm AIR CAVITY 152mm SEMI RIGID INSULATION CONTINUOUS AIR/ VAPOUR BARRIER MEMBRANE VARIES CONCRETE WALL (SEE STRUCTURAL)	1HR FRR ASSEMBLY
EW6	[Interior] 518 [Exterior]	90mm MASONRY VENEER 25mm AIR CAVITY 152mm SEMI RIGID INSULATION CONTINUOUS AIR/ VAPOUR BARRIER MEMBRANE 16mm EXTERIOR GYPSUM SHEATHING 203mm GALVANIZED ENGINEERED METAL STUDS 16mm TYPE X GYPSUM WALL BOARD 16mm TYPE X GYPSUM WALL BOARD	1HR FRR ASSEMBLY

PARAPET WALL ASSEMBLIES

TYPE	ASSEMBLY	CONSTRUCTION	NOTES
PW1	[EW Assembly not present] [Roofing side]	16mm EXTERIOR GYPSUM SHEATHING BOARD CONTINUOUS AIR/VAPOUR BARRIER MEMBRANE 89mm 38 X 89mm WOOD BLOCKING W/ MINERAL WOOL IN CAVITY 16mm EXTERIOR GYPSUM SHEATHING BOARD ROOF MEMBRANE FLASHING PREFINISHED METAL COUNTER FLASHING	
PW2	[EW Assembly not present] [Roofing side]	16mm EXTERIOR GYPSUM SHEATHING BOARD CONTINUOUS AIR/ VAPOUR BARRIER MEMBRANE 140mm 38x140mm WOOD BLOCKING W/ MINERAL WOOL IN CAVITY 16mm EXTERIOR GYPSUM SHEATHING BOARD ROOF MEMBRANE FLASHING PREFINISHED METAL COUNTER FLASHING (PROVIDE ADDITIONAL WOOD BLOCKING TO SUIT)	17 AGAINST EXISTING WALLS
PW3	[EW Assembly not present] [Roofing side]	152mm METAL STUD W/ MINERAL WOOL IN CAVITY 16mm EXTERIOR GYPSUM SHEATHING BOARD 89mm 38x89mm WOOD BLOCKING W/ MINERAL WOOL IN CAVITY 16mm EXTERIOR GYPSUM SHEATHING BOARD ROOF MEMBRANE FLASHING PREFINISHED METAL COUNTER FLASHING (PROVIDE ADDITIONAL WOOD BLOCKING TO SUIT)	AGAINST EXISTING WALLS AND EXPANSION JOINT
PW4	[Interior] [Exterior]	PREFINISHED METAL COUNTER FLASHING ROOFING MEMBRANE FLASHING 190mm CONCRETE MASONRY UNIT GROUTED SOLID 10mm GROUT 150mm SEMI RIGID INSULATION CONTINUOUS AIR/ VAPOUR BARRIER MEMBRANE 16mm EXTERIOR GYPSUM SHEATHING 203mm GALVANIZED ENGINEERED METAL STUDS 16mm TYPE X GYPSUM WALL BOARD	CURB AT ROOF ROOF TERRACE
PW5	[Interior] [Exterior]	PREFINISHED METAL COUNTER FLASHING ROOFING MEMBRANE FLASHING 190mm CONCRETE MASONRY UNIT GROUTED SOLID 10mm GROUT 150mm SEMI RIGID INSULATION CONTINUOUS AIR/ VAPOUR BARRIER MEMBRANE 190mm CONCRETE MASONRY UNIT (SOLID)	CURB UNDER CURTAIN WALL AT ROOF TERRACE

INTERIOR FURRING WALL ASSEMBLIES

TYPE	ASSEMBLY	CONSTRUCTION	NOTES
F1	38	16mm GYPSUM WALL BOARD 22mm FURRING CHANNEL @ 400mm O/C MAX.	
F2	57	16mm GYPSUM WALL BOARD 41mm METAL STUDS @ 400mm O/C MAX.	REFER TO ELEVATIONS AND FINISHES DRAWINGS FOR TILE TYPE WHERE APPLICABLE
F3	73	16mm GYPSUM WALL BOARD 16mm GYPSUM WALL BOARD 41mm METAL STUDS @ 400mm O/C MAX.	
F4	108	16mm GYPSUM WALL BOARD 92mm METAL STUDS @ 400mm O/C MAX.	REFER TO ELEVATIONS AND FINISHES DRAWINGS FOR TILE TYPE WHERE APPLICABLE PROVIDE TILE BACKER BOARD IN LIEU OF GYPSUM WALL BOARD IN AREAS TO RECEIVE A TILE FINISH
F5	168	16mm GYPSUM WALL BOARD 152mm METAL STUDS @ 400mm O/C MAX.	REFER TO ELEVATIONS AND FINISHES DRAWINGS FOR TILE TYPE WHERE APPLICABLE PROVIDE TILE BACKER BOARD IN LIEU OF GYPSUM WALL BOARD IN AREAS TO RECEIVE A TILE FINISH
F6	168	16mm TILE BACKER WALL BOARD 152mm ENGINEERED STEEL STUDS EXTENDED STEEL STUDS TO U/S OF STRUCTURE ABOVE. C/W SOLID WOOD BLOCKING (150mm ABOVE CEILING) AT ADULT CHANGE TABLE.	REFER TO ELEVATIONS AND FINISHES DRAWINGS FOR TILE TYPE WHERE APPLICABLE

Key to Detail Location

NO. / NO. — Detail Number / Drawing Number

If this sheet is not 46 7/8" x 33 1/8" (1189 x 841 mm) it is a reduced print - Read dwg. accordingly.

Contractors must check and verify all dimensions on the job and report any discrepancies to the Architect before proceeding with the work.

All prints and specifications are the property of the Architect and must be returned at the completion of the work.

Drawings should not be scaled.

No	Date	Revision/Issued
9	2025 12 15	30% CD FOR CLIENT REVIEW
10	2026 03 13	ISSUED FOR PERMIT
11	2026 04 10	75% CD FOR CLIENT REVIEW
12	2026 04 22	ISSUED FOR PERMIT COMMENTS 1
14	2026 05 15	90% CD FOR CLIENT REVIEW
15	2026 07 08	ISSUED FOR TENDER
16	2026 07 17	ISSUED FOR ADDENDA 1
17	2026 07 27	ISSUED FOR ADDENDA 3

consultants

architect — CS&P Architects Inc.
2345 Yonge St., Suite 200
Toronto, ON, M4P 2E5
Phone.416.482.5002
Fax.416.482.5040

civil engineer — SCS Consulting Group Ltd.
30 Centurian Drive, Suite 100
Markham, ON, L3R 8B8
Phone.905.475.1900
Fax.905.8335

structural engineer — LEA Consulting Ltd.
40 University Ave, Suite 503
Toronto, ON, M5J 1T1
Phone.905.470.0015

mechanical engineer — Smith + Andersen
4211 Yonge Street
Toronto, ON, M2P 2A9
Phone.416.487.8151

electrical engineer — Smith + Andersen
4211 Yonge Street
Toronto, ON, M2P 2A9
Phone.416.487.8151

landscape architect — Quinn Design Associates Inc.
180 John Street
Toronto, ON, M5T 1X5
Phone.416.962.8700

PROJECT NORTH N

SHS CS&P Architects

THE STERLING HALL SCHOOL

99 Cartwright Avenue, Toronto, ON M6A 1V4

ASSEMBLIES LEGEND

scale:	1 : 20
date:	05/21/24
drawn:	CS&P
checked by:	CA
project number:	21032
drawing number:	A0.11
	Revision: 17

A0

FILENAME: Autodesk Docs://21032 Sterling Hall/21032_SHS-A-MAIN-25.rvt

DRAWING LAST EDITED: 2026-07-27 4:45:01 PM

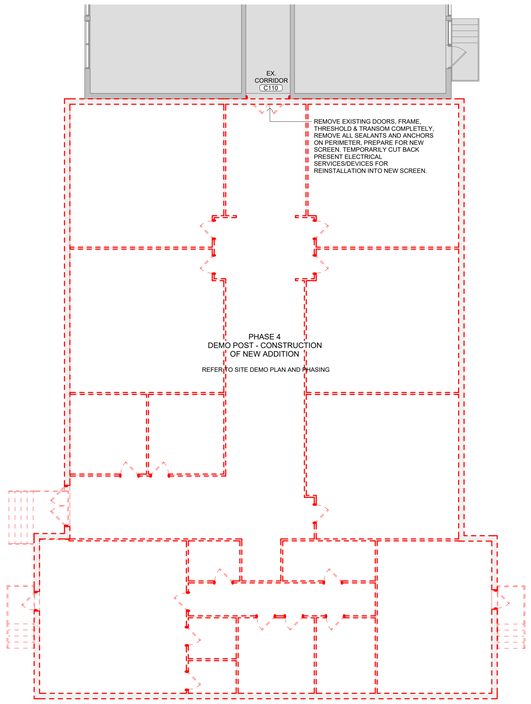

4 D2.00 GROUND FLOOR DEMOLITION PLAN - EAST PORTABLE PHASE 4
1 : 100

DEMOLITION NOTES

- D1 REMOVE PORTION OF EXISTING EXTERIOR WALL, BRICK VENEER, STEEL STUDS, INSULATION, MEMBRANES AND FINISHES, FULL HEIGHT, DOORS & FRAMES INCLUDED. ROOF STRUCTURE AND PARAPET CAP, ROOFING TO REMAIN. SEE ALSO D13.
- D2 REMOVE EXISTING SOFFIT ABOVE, FRAMING AND M&E DEVICES. REMOVE EXISTING CONCRETE SLAB AND CURB
- D3 CUT AND REMOVE PORTION OF EXISTING CONCRETE FLOOR
- D4 REMOVE EXISTING DOOR, FRAME, AND HARDWARE
- D5 REMOVE EXISTING CEILING INCLUDING MECH/ELECT FIXTURES/DEVICES AND FLOOR FINISHES, EXTENTS SHOWN IN RED HATCH
- D6 EXISTING MECH/ ELEC FIXTURES/EQUIPMENT TO BE REMOVED AND RELOCATED FOR NEW LAYOUT
- D7 REMOVE EXISTING SCREEN, DOORS, WINDOWS, PANELS COMPLETELY, FULL HEIGHT, CLEAN AND REMOVE SEALANTS AND ANCHORS, TAKE PRECAUTIONS NOT TO DAMAGE EXISTING AVB, PREPARE OPENING FOR NEW WORK. ELECTRICAL DEVICES TO BE REMOVED & REINSTALLED TO SUIT NEW WORK
- D8 CUT AND REMOVE EXISTING MASONRY INSULATED CAVITY WALL, INCLUDING DOOR AND FRAME WHERE PRESENT. NEEDLE SHORE WALL, INSTALL NEW LINTEL, PATCH AND REPAIR CMU AND MAKE GOOD. TOOTH IN RECLAIMED BRICK AT NEW LINTEL ABOVE AND AT JAMBS FULL HEIGHT. PREPARE TOP OF EXISTING CMU FOUNDATION WALL FOR NEW WORK, CUT REBAR AND ANCHORS, GROUT SOLID VOIDS AND MAKE SMOOTH. INCLUDE REMOVAL AND RELOCATION OF ELECTRICAL DEVICES AFFECTED BY DEMOLITION
- D9 REMOVE EXISTING BRICK FACADE ABOVE SOFFIT, INCLUDING TIES, SUPPORT LINTEL, HANGERS AND BRACKETS, CUT FLUSH WITH U/S ROOF BEAM.
- D10 EXISTING COLUMN TO REMAIN, FILL HOLES AND PREPARE FOR NEW PAINT FINISH
- D11 REMOVE EXISTING ADD AND INTERCOM FOR RE-INSTALLATION (SEE PLANS FOR LOCATION)
- D12 REMOVE EXISTING INTERIOR PARTITION, DOORS AND GLAZED SCREENS INCLUDED - FULL HEIGHT
- D13 REMOVE EXISTING PARAPET CAP FLASHING, TAKE PRECAUTIONS TO NOT DAMAGE EXISTING ROOF MEMBRANE, TO FULL EXTENT OF NEW ADDITION AND TO NEAREST JOINT. SALVAGE A PORTION OF FLASHING FOR REPAIR AT NEW TRANSITION AND MAKE GOOD
- D14 REMOVE EXISTING BRICK VENEER, CAVITY WALL INSULATION, SPRAY FOAM INSULATION, WHERE PRESENT, CUT OFF AND REMOVE ALL PROTRUDING BRICK VENEER TIES FLUSH WITH FACE OF EXISTING AVB/SHEATHING
- D15 REMOVE EXISTING SOFFIT CLADDING, UPPER AND LOWER, INCLUDING FASCIA BETWEEN, FRAMING, MECH/ELECT FIXTURES TO REMAIN
- D16 REMOVE EXISTING PARAPET CAP FLASHING, CLADDING AND DOFFIT, C/W ALL SUPPORT SHEATHING & FRAMING AS WELL AS ASSOCIATED MECH/ELECT SERVICES
- D17 SAWCUT & REMOVE PORTION OF EXISTING CONCRETE SLAB ON GRADE, C/W TOP OF EXISTING FOUNDATION WALL AT PERIMETER OF EXISTING VESTIBULE
- D18 REMOVE EXISTING VESTIBULE SCREENS IN THEIR ENTIRETY C/W ALL ASSOCIATED ELECTRICAL DEVICES, CUT BACK TO NEAREST JUNCTION BOX AND MAKE SAFE
- D19 CUT DOWN AND REMOVE TOP OF EXISTING CONCRETE FOUNDATION WALL TO MIN 200mm BELOW TOP OF SLAB ON GRADE. PROVIDE ADDITIONAL REMOVAL TO SUIT NEW BURIED SERVICES PASSING THROUGH. COORDINATE EXTENTS WITH NEW WORK
- D20 REMOVE EXISTING FLOOR FINISHES, PREPARE TO RECEIVE NEW

SALVAGE NOTES

- S1 SALVAGE EXISTING LOCKERS TO BE REINSTALLED IN NEW LOCATION
- S2 SALVAGE EXISTING DOOR TO BE REINSTALLED IN NEW LOCATION. REFER TO PLANS AND DOOR SCHEDULE
- S3 SALVAGE EXISTING BRICKS (BRICKS AT GYM, AND BRICKS AT CLASSROOM CONNECTION) TO BE REINSTALLED FOR FINISH AND PATCH WORK TO EXPOSED EXISTING, AND TURNED OVER TO OWNER
- S4 SALVAGE SUFFICIENT FLOOR FINISH TO REPAIR AND MAKE GOOD FLOOR FINISH IN EXISTING ROOMS TO REMAIN

GENERAL NOTES - DEMOLITION

1. DASHED LINES ON DEMOLITION PLANS REPRESENT EXISTING TO BE REMOVED UNLESS OTHERWISE NOTED.
2. DEMOLITION DRAWINGS ARE PROVIDED FOR THE CONTRACTOR'S CONVENIENCE TO INDICATE THE GENERAL EXTENT OF DEMOLITION WORK AND AS SUCH DO NOT NECESSARILY INDICATE THE ENTIRE SCOPE OF THE WORK. THE EXTENT OF THE DEMOLITION WORK WILL BE THAT WHICH IS NECESSARY TO COMPLETE THE WORK AS DESCRIBED BY THE CONTRACT DOCUMENTS. IT IS THE CONTRACTOR'S RESPONSIBILITY TO INSPECT AND ASSESS EACH AREA AND TO FULFILL THE INTENT OF THE DESIGN INDICATED BY THE CONTRACT DOCUMENTS.
3. INFORMATION SHOWN ON THE DEMOLITION DRAWINGS IS TO BE COORDINATED AND READ IN CONJUNCTION WITH THE ARCHITECTURAL, STRUCTURAL, MECHANICAL, ELECTRICAL, CIVIL AND LANDSCAPE DRAWINGS.
4. FOR ALL SURFACES TO REMAIN, PATCH AND MAKE GOOD SURFACES DISTURBED BY DEMOLITION OR REMOVAL EQUIPMENT OR UTILITIES.
5. DEMOLITION OF EXISTING WALLS AND PARTITIONS TO INCLUDE REMOVAL OF ALL MECH, PLUMBING AND ELECTRICAL SERVICES WITHIN WALL, REMOVE BACK TO SOURCE, CAP AND MAKE SAFE.
6. PROVIDE PROTECTION AGAINST THE WEATHER AT ALL OPENINGS.
7. SALVAGE AT MIN 50 SQM OF THE BEST QUALITY EXISTING BRICK VENEER FROM DEMOLITION OPERATIONS AT THE GYM AND AT THE CLASSROOM ADDITION/ADDITION. CLEAN OLD MORTAR FROM BRICK. STACK AND STORE FOR USE IN REMEDIAL WORK AS NOTED ON DRAWINGS AND TURN OVER TO OWNER AS PART OF THE ATTIC STOCK.
8. PRIOR TO ANY DEMOLITION, THE CONTRACTOR SHALL COORDINATE THE BRACING AND MAINTAIN THE STRUCTURAL INTEGRITY OF THE REMAINING ELEMENTS OF THE BUILDING AND ITS SYSTEMS AS REQUIRED. THE CONTRACTOR SHALL BE RESPONSIBLE FOR THE SUPPORT OF ADJACENT STRUCTURE DURING DEMOLITIN AND NEW CONSTRUCTION WORK. THE CONTRACTOR SHALL PROVIDE ALL TEMPORARY SHORING, SCAFFOLDING, ETC., WHICH ARE NECESSARY TO PREVENT COLLAPSE, SUBSIDENCE, DEFLECTION OR ANY OTHER TYPE OF DAMAGE. REFER TO AND COORDINATE WITH STRUCTURAL DRAWINGS.
9. REFER TO AND REVIEW CIVIL DRAWINGS AND UTILITY MAP TO ENSURE ANY PIPES OR SERVICES BEYOND THE FOOTPRINT OF THE BUILDING THAT NEEDS TO REMAIN AND BE PROTECTED.
10. REFER ALSO TO ELECTRICAL AND MECHANICAL SPECIFICATONS AND DRAWINGS FOR SCOPE AND COORDINATION.
11. EXISTING ENTRANCE ROOF/CANOPY: GENERAL CONTRACTOR TO INSPECT AND ASSESS THE CONDITION OF EXISTING GEOTEXTILE FABRIC, INSULATION, UNDERLYING MEMBRANE, AND ANY OTHER ROOF ASSEMBLY COMPONENTS PRIOR TO REMOVAL TO DETERMINE IF ITS SALVAGABLE.
12. TOOTH-IN REQUIRED FOR ALL NEW OPENING IN EXISTING MASONRY WALLS TO KEY-IN NEW MASONRY WALLS TO ELIMINATE CUT JOINTS.
13. DEMOLITION TO INCLUDE PREPARATION OF SITE, INFILL OF TRENCHES RESULTING FROM REMOVALS TO SUIT NEW WORK.
14. THE SITE DEMOLITION PLAN MAY NOT IDENTIFY ALL ITEMS LOCATED ON THE SITE, AND IT IS WITH THE UNDERSTANDING THAT APPLICABLE DEMOLITION IS PERFORMED IN ORDER TO DO THE NEW WORK.
15. PATCH SURFACES TO COMPLY WITH FIRE RATINGS, SMOKE SEALS.
16. FOR ITEMS TO BE SALVAGED OR RE-INSTALLED, REFER TO ARCHITECTURAL, MECHANICAL, AND ELECTRICAL CONTRACT DOCUMENTS AND SPECIFICATIONS.

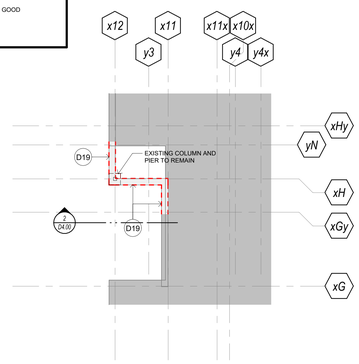

3 D2.00 GROUND FLOOR DEMOLITION PLAN - FOUNDATIONS
1 : 100

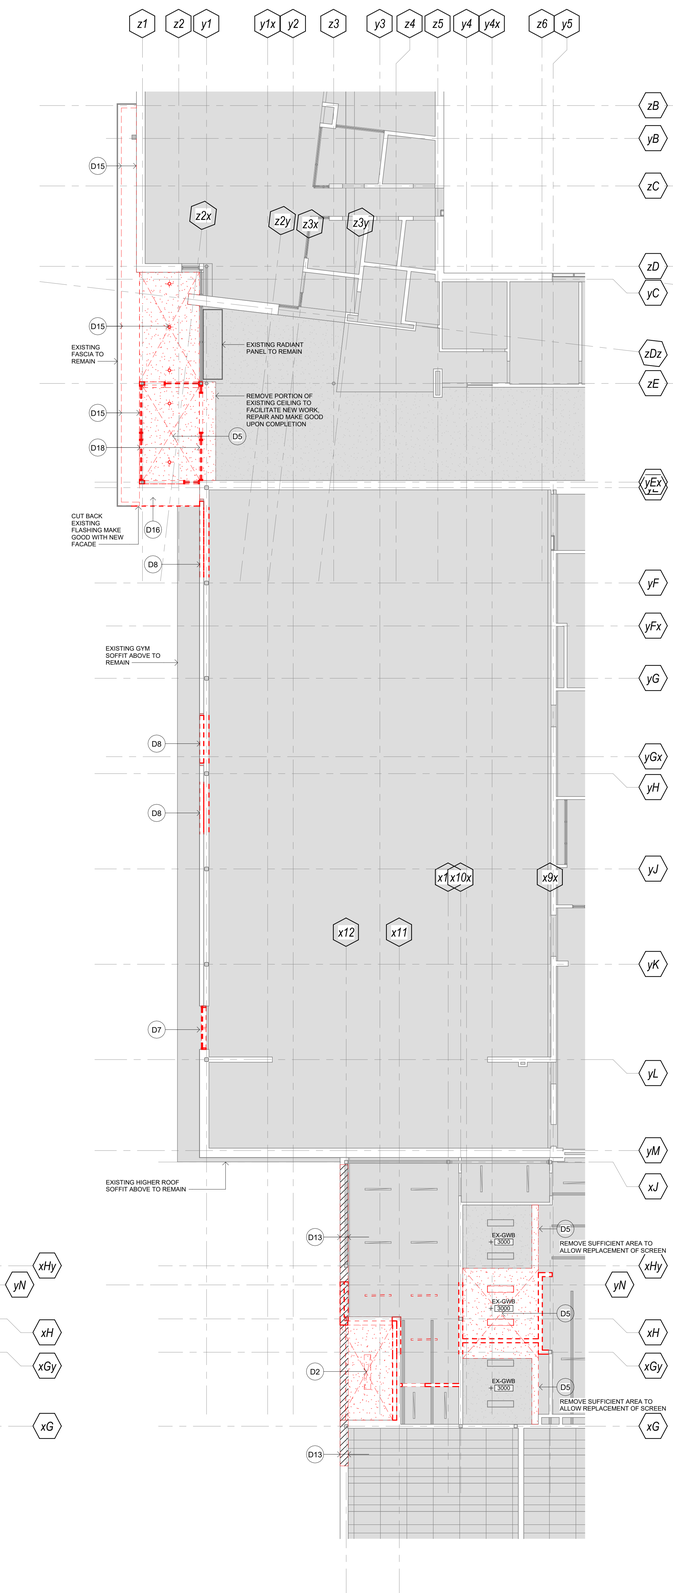

2 D2.00 GROUND FLOOR DEMOLITION - CEILING AND ROOF
1 : 100

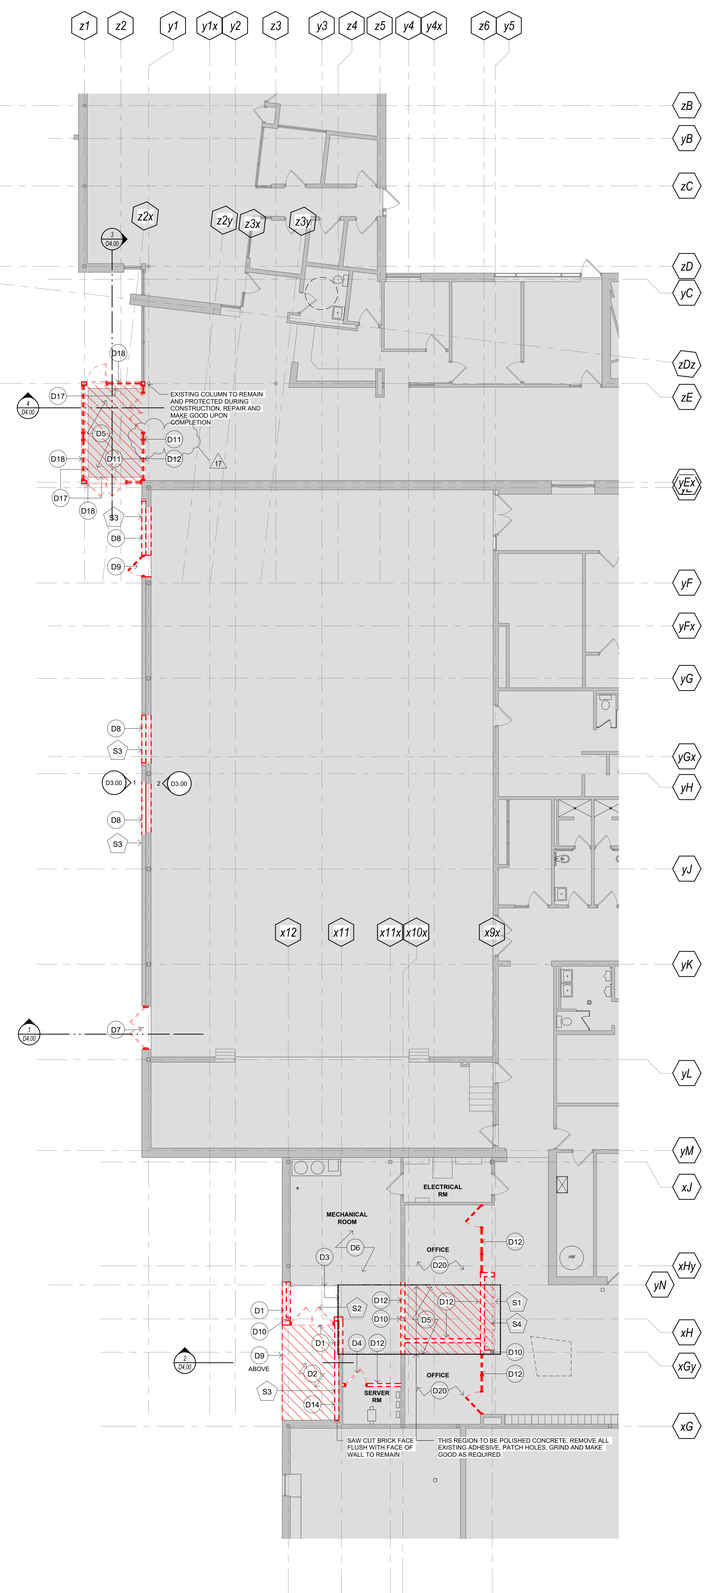

1 D2.00 GROUND FLOOR DEMOLITION PLAN - FLOOR PLAN
1 : 100

Key to Detail Location

NO. / NO. — Detail Number / Drawing Number

If this sheet is not 46 7/8" x 33 1/8" (1189 x 841 mm) it is a reduced print - Read dwg. accordingly.

Contractors must check and verify all dimensions on the job and report any discrepancies to the Architect before proceeding with the work.

All prints and specifications are the property of the Architect and must be returned at the completion of the work.

Drawings should not be scaled.

No	Date	Revision/Issued
8	2025 11 05	15% CD FOR CLIENT REVIEW
9	2025 12 15	30% CD FOR CLIENT REVIEW
10	2026 03 13	ISSUED FOR PERMIT
11	2026 04 10	75% CD FOR CLIENT REVIEW
13	2026 04 28	ISSUED FOR PERMIT COMMENTS 1
14	2026 05 15	90% CD FOR CLIENT REVIEW
15	2026 07 08	ISSUED FOR TENDER
16	2026 07 17	ISSUED FOR ADDENDA 1
17	2026 07 27	ISSUED FOR ADDENDA 3

consultants

architect — CS&P Architects Inc., 2345 Yonge St., Suite 200, Toronto, ON, M4P 2E5, Phone.416.482.5002, Fax.416.482.5040

civil engineer — SCS Consulting Group Ltd., 30 Centurian Drive, Suite 100, Markham, ON, L3R 8B8, Phone.905.475.1900, Fax:905.475.8035

structural engineer — LEA Consulting Ltd., 40 University Ave, Suite 503, Toronto, ON, M5J 1T1, Phone.905.470.0015

mechanical engineer — Smith + Andersen, 4211 Yonge Street, Toronto, ON, M2P 2A9, Phone.416.487.8151

electrical engineer — Smith + Andersen, 4211 Yonge Street, Toronto, ON, M2P 2A9, Phone.416.487.8151

landscape architect — Quinn Design Associates Inc., 180 John Street, Toronto, ON, M5T 1X5, Phone.416.962.8700

PROJECT NORTH

SHS CS&P Architects

THE STERLING HALL SCHOOL

99 Cartwright Avenue, Toronto, ON M6A 1V4

DEMOLITION PLAN & RCP - GROUND LEVEL

scale:	As indicated
date:	03/04/26
drawn:	CS&P
checked by:	CA
project number:	21032
drawing number:	D2.00
Revision:	17

A0

FILENAME: Autodesk Docs://21032 Sterling Hall/21032_SHS-A-MAIN-25.rvt

DRAWING LAST EDITED: 2026-07-27 4:45:06 PM

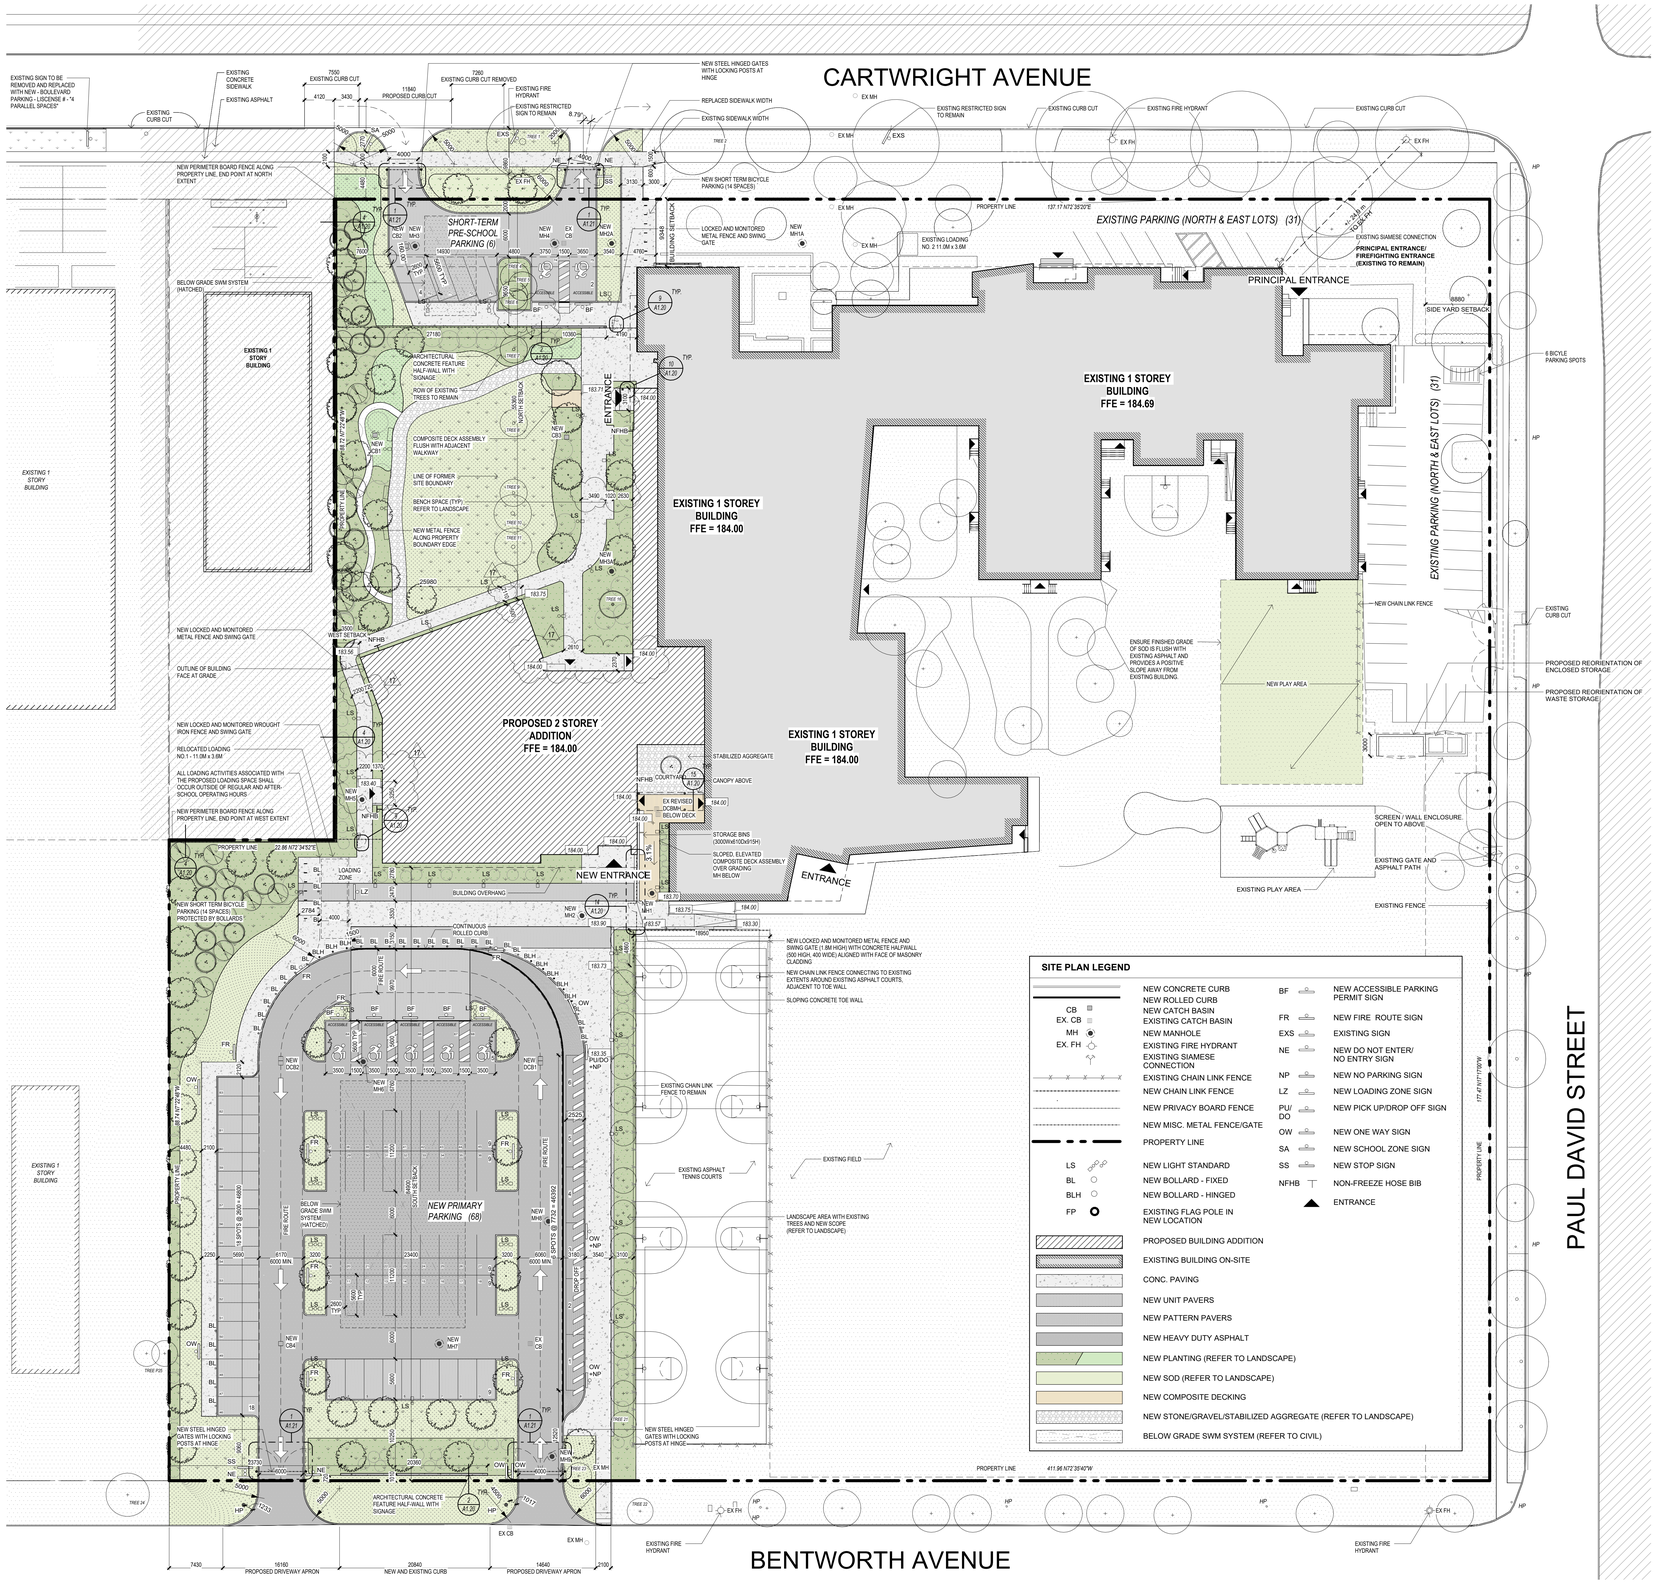

1 A1.00 SITE PLAN
1 : 300

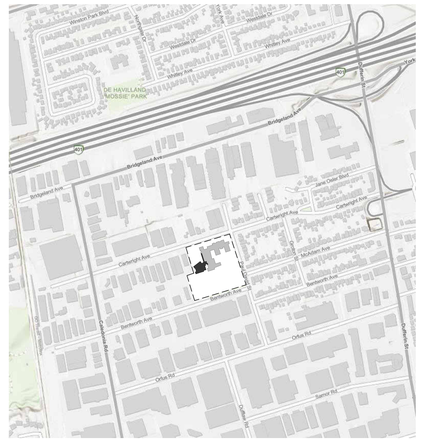

2 A1.00 CONTEXT PLAN - NTS
1 : 7500

SITE STATISTICS

SITE PLAN APPLICATION 25 173222 NNY 08 SA

PROJECT DATA

NEW 2 STOREY ADDITION TO EXISTING ELEMENTARY INDEPENDENT BOYS SCHOOL

BUILDING CLASSIFICATION

OCCUPANCY:	*ASSEMBLY (A) DIVISION 2*
BUILDING HEIGHT:	*UP TO 6 STOREYS, ANY AREA (SPRINKLERED) – NEW CONSTRUCTION [(O.B.C.) CLAUSE 3.2.2.24]*

BUILDING DESCRIPTION – INDEPENDENT ELEMENTARY SCHOOL

• *PROPOSED BUILDING HEIGHT:*	*2 STOREY*
• *NON-COMBUSTIBLE CONSTRUCTION*	
• *NEW ADDITION SPRINKLERED WITH SUPERVISED FIRE ALARM*	
• *BUILDING FACING EXISTING PLAY FIELD AND EXISTING WEST SIDE PARKING*	
• *BUILDING FOOTPRINT AREA:*	*5893.36 m²*
• *FLOOR ASSEMBLIES:*	*1-HR FRR (PARTIAL BASEMENT)*
• *ROOF ASSEMBLY:*	*NOT RATED (SPRINKLERED)*

SITE STATISTICS

ADDRESS:	*99 CARTWRIGHT AVENUE, 109 CARTWRIGHT AVENUE, 130 BENTWORTH AVE*
ZONING:	*M1 [ZONING BY-LAW 1211-2024]*
SITE AREA:	*30366.87 m²*
EXISTING BUILDING FOOTPRINT:	*6099.00 m²*
AREA TO BE DEMOLISHED:	*1494.01 m²*
PROPOSED ADDITION FOOTPRINT:	*1288.37 m²*
NEW TOTAL FOOTPRINT AREA:	*5893.36 m²*
TOTAL EXISTING GROSS FLOOR AREA ON SITE:	*6099.00 m²*
AREA TO BE DEMOLISHED:	*1494.01 m²*
NEW CONSTRUCTION GROSS FLOOR AREA:	*2440.63 m²*
NEW TOTAL G.F.A. ON SITE:	*7045.62 m²*
EXISTING BUILDING COVERAGE RATIO:	*20.08%*
PROPOSED BUILDING COVERAGE RATIO:	*19.19%*
EXISTING SOFT LANDSCAPE AREA (40.7% OF SITE):	*11197.20 m²*
REVISED SOFT LANDSCAPE AREA:	*16576.75 m²*
NEW TOTAL LANDSCAPE RATIO:	*54.39%*
BUILDING HEIGHT ALLOWABLE:	*15.0M*
BUILDING HEIGHT PROPOSED:	*15.0M*

PARKING EXISTING

PARKING REQUIRED EXISTING BUILDING:	*N/A*
BEFORE FEB. 1996: (1 carrlea. Classroom, office) 1 X 17 = 17 Parking Spaces	*17*
AFTER FEB. 1996: (1.5 carrlea. Classroom, Office) 1.5 X 28 = 42 Parking Spaces	*42*
EXISTING TOTAL PARKING REQUIRED:	*59*
NEW BLDG. REQ. PARKING: (59 Exist. Parking - (1.5 X 6 Classroom, Office) + (1.5 X 10 Classroom, Office)	*61.5*
TOTAL PARKING SPACES 2014:	*62*
EXISTING PARKING 130 BENTWORTH:	*30*
EXISTING PARKING 109 CARTWRIGHT:	*5*
EXISTING PARKING TOTAL:	*96*

PARKING PROPOSED (TOTALS)

EXISTING TO REMAIN:	*31*
NEW PARKING SPACES:	*74 (INCLUDING 7 ACCESSIBLE PARKING SPOTS)*
TOTAL PARKING SPACES:	*105 (INCLUDING 7 ACCESSIBLE PARKING SPOTS)*
BICYCLE PARKING:	*34 SPOTS (6 EXISTING, 24 SHORT-TERM AND 4 LONG-TERM)*

LOADING

LOADING REQUIRED:	*(OVER 2350 m²) = 1 LOADING SPACES @ 11.0 X 3.6m WIDE.*
LOADING SPACE PROVIDED:	*2 SPACES (1 RELOCATED)*

SITE STATISTICS

ADDRESS:	*99 CARTWRIGHT AVENUE*
ZONING:	*M1*
SITE AREA:	*24340 m²*
EXISTING BUILDING FOOTPRINT:	*5138.00 m²*
AREA TO BE DEMOLISHED:	*533.01 m²*
PROPOSED ADDITION FOOTPRINT:	*796.79 m²*
NEW TOTAL FOOTPRINT AREA:	*5934.79 m²*
TOTAL EXISTING G.F.A. ON SITE:	*5138.00 m²*
AREA TO BE DEMOLISHED:	*533.01 m²*
NEW CONSTRUCTION GROSS FLOOR AREA:	*1233.63 m²*
NEW TOTAL G.F.A. ON SITE:	*5838.62 m²*
EXISTING BUILDING COVERAGE RATIO:	*21.11%*
PROPOSED BUILDING COVERAGE RATIO:	*23.99%*
EXISTING SOFT LANDSCAPE AREA (45.18% OF SITE):	*10997.20 m²*
REVISED SOFT LANDSCAPE AREA:	*14131.23 m²*
NEW TOTAL LANDSCAPE RATIO:	*58.06% OF SITE*
BUILDING HEIGHT ALLOWABLE:	*15.0M*
BUILDING HEIGHT PROPOSED:	*15.0M*

SITE STATISTICS

ADDRESS:	*109 CARTWRIGHT AVENUE*
ZONING:	*M1*
SITE AREA:	*1998.91 m²*
EXISTING BUILDING FOOTPRINT:	*961.00 m²*
AREA TO BE DEMOLISHED:	*961.00 m²*
PROPOSED ADDITION FOOTPRINT:	*44.97 m²*
NEW TOTAL FOOTPRINT AREA:	*44.97 m²*
TOTAL EXISTING G.F.A. ON SITE:	*961.00 m²*
AREA TO BE DEMOLISHED:	*961.00 m²*
NEW CONSTRUCTION GROSS FLOOR AREA:	*1030.46 m²*
NEW TOTAL G.F.A. ON SITE:	*1030.46 m²*
EXISTING BUILDING COVERAGE RATIO:	*48.08%*
PROPOSED BUILDING COVERAGE RATIO:	*51.55%*
EXISTING SOFT LANDSCAPE AREA (0% OF SITE):	*0 m²*
REVISED SOFT LANDSCAPE AREA:	*1218.74 m²*
NEW TOTAL LANDSCAPE RATIO:	*60.97% OF SITE*
BUILDING HEIGHT ALLOWABLE:	*15.0M*
BUILDING HEIGHT PROPOSED:	*15.0M*

SITE STATISTICS

ADDRESS:	*130 BENTWORTH AVENUE*
ZONING:	*M1*
SITE AREA:	*4027.96 m²*
EXISTING BUILDING FOOTPRINT:	*0 m²*
AREA TO BE DEMOLISHED:	*0 m²*
PROPOSED ADDITION FOOTPRINT:	*46.61 m²*
NEW TOTAL FOOTPRINT AREA:	*46.61 m²*
TOTAL EXISTING G.F.A. ON SITE:	*0 m²*
AREA TO BE DEMOLISHED:	*0 m²*
NEW CONSTRUCTION GROSS FLOOR AREA:	*176.54 m²*
NEW TOTAL G.F.A. ON SITE:	*176.54 m²*
EXISTING BUILDING COVERAGE RATIO:	*0.00%*
PROPOSED BUILDING COVERAGE RATIO:	*4.26%*
EXISTING SOFT LANDSCAPE AREA (43% OF SITE):	*200 m²*
REVISED SOFT LANDSCAPE AREA:	*1226.81 m²*
NEW TOTAL LANDSCAPE RATIO:	*29.63% OF SITE*
BUILDING HEIGHT ALLOWABLE:	*15.0M*
BUILDING HEIGHT PROPOSED:	*15.0M*

Key to Detail Location

NO. / NO. — Detail Number / Drawing Number

If this sheet is not 46.7/8" x 33.1/8" (1189 x 841 mm) it is a reduced print - Read dwg. accordingly.

Contractors must check and verify all dimensions on the job and report any discrepancies to the Architect before proceeding with the work.

All prints and specifications are the property of the Architect and must be returned at the completion of the work.

Drawings should not be scaled.

No	Date	Revision/Issued
1	2023.05.19	ISSUED FOR ZBA
2	2024.06.27	RE-ISSUED FOR ZBA RESUBMISSION
3	2024.09.19	RE-ISSUED FOR ZBA RESUBMISSION
4	2024.12.17	DRAFT SPA FOR CLIENT REVIEW
5	2025.04.08	100% DESIGN DEVELOPMENT FOR CLIENT
6	2025.06.02	ISSUED FOR SPA
7	2025.09.15	ISSUED FOR SPA RESUBMISSION
8	2025.11.05	15% CD FOR CLIENT REVIEW
9	2025.12.15	30% CD FOR CLIENT REVIEW
10	2026.03.13	ISSUED FOR PERMIT
11	2026.04.10	75% CD FOR CLIENT REVIEW
14	2026.05.15	90% CD FOR CLIENT REVIEW
15	2026.07.08	ISSUED FOR TENDER
16	2026.07.17	ISSUED FOR ADDENDA 1
17	2026.07.27	ISSUED FOR ADDENDA 3

consultants

architect — CS&P Architects Inc., 2345 Yonge St., Suite 200, Toronto, ON, M4P 2E5, Phone.416.482.5002, Fax.416.482.5040

civil engineer — SCS Consulting Group Ltd., 30 Centurian Drive, Suite 100, Markham, ON, L3R 8B8, Phone.905.475.1900, Fax.905.475.8335

structural engineer — LEA Consulting Ltd., 40 University Ave, Suite 503, Toronto, ON, M5J 1T1, Phone.905.470.0015

mechanical engineer — Smith + Andersen, 4211 Yonge Street, Toronto, ON, M2P 2A9, Phone.416.487.8151

electrical engineer — Smith + Andersen, 4211 Yonge Street, Toronto, ON, M2P 2A9, Phone.416.487.8151

landscape architect — Quinn Design Associates Inc., 180 John Street, Toronto, ON, M5T 1X5, Phone.416.962.8700

PROJECT NORTH

SHS CS&P Architects

THE STERLING HALL SCHOOL

99 Cartwright Avenue, Toronto, ON M6A 1V4

SITE PLAN

scale:	As indicated
date:	06/19/24
drawn:	CS&P
checked by:	CA
project number:	21032
drawing number:	A1.00
Revision:	17

A0

FILENAME: Autodesk Docs://21032 Sterling Hall/21032_SHS-A-MAIN-25.rvt

DRAWING LAST EDITED: 2026-07-27 4:45:18 PM

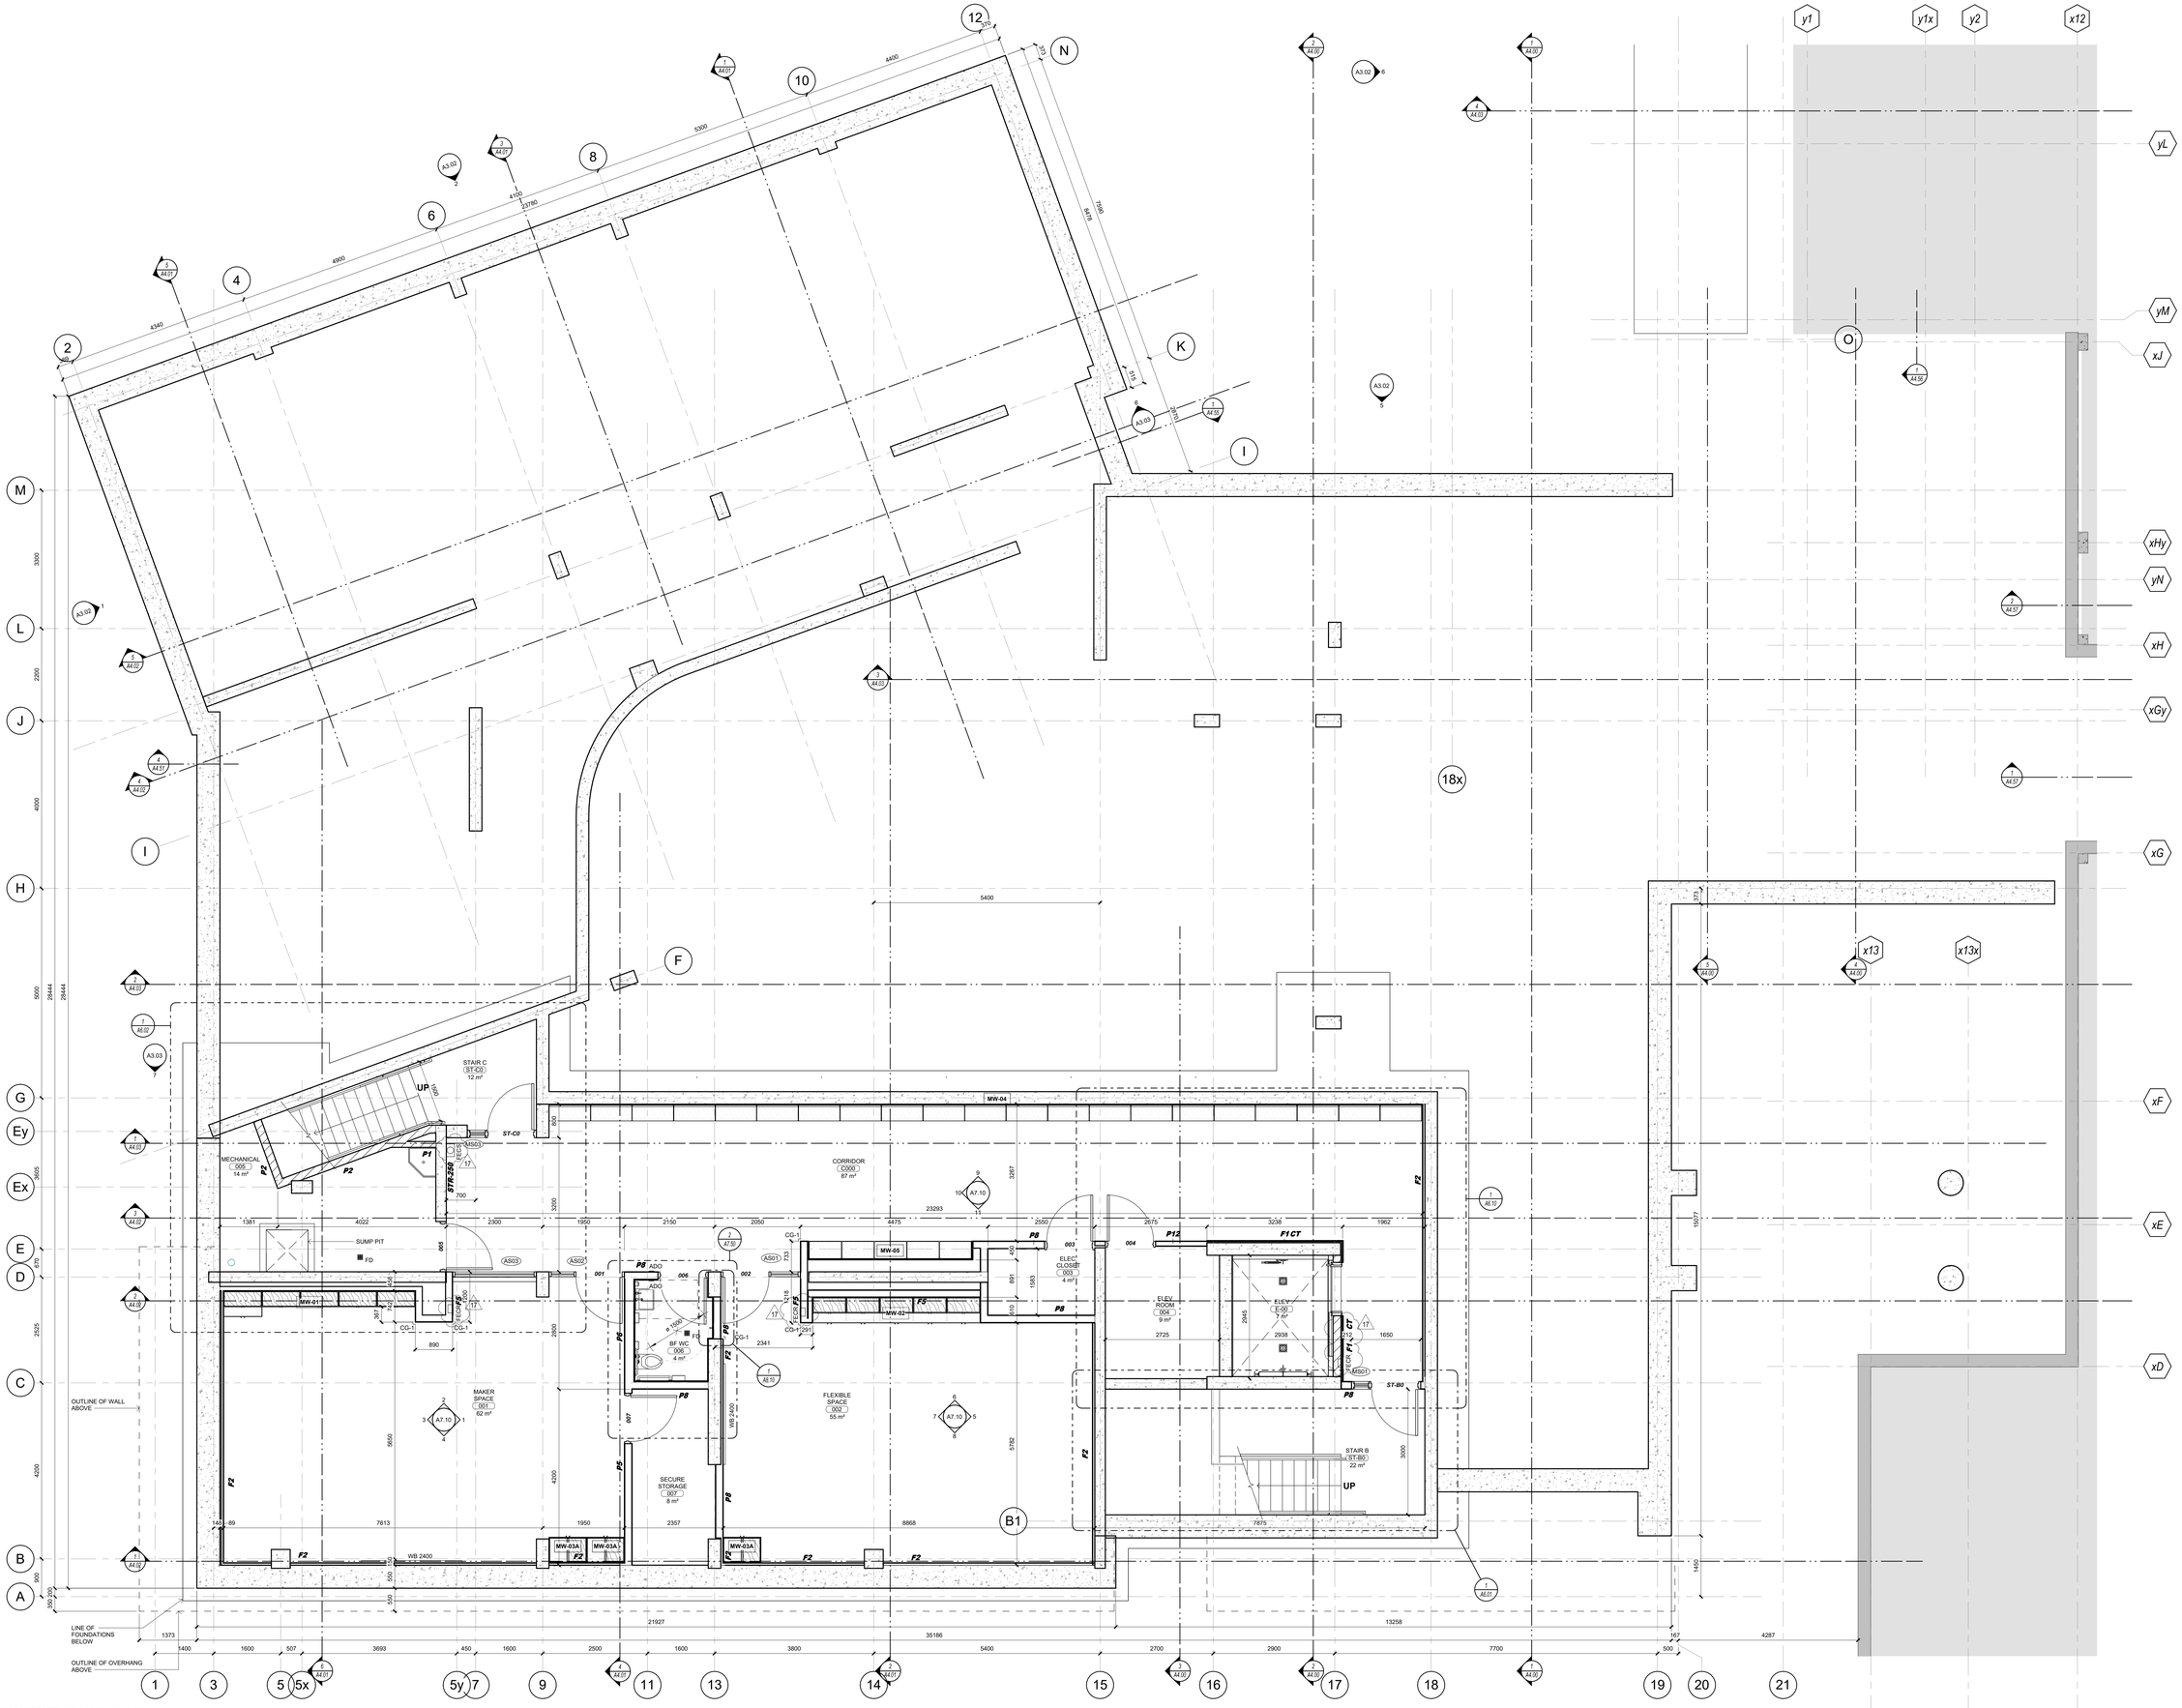

Key to Detail Location

NO. — Detail Number
NO. — Drawing Number

If this sheet is not 46 7/8" x 33 1/8" (1189 x 841 mm) it is a reduced print - Read dwg. accordingly.

Contractors must check and verify all dimensions on the job and report any discrepancies to the Architect before proceeding with the work.

All prints and specifications are the property of the Architect and must be returned at the completion of the work.

Drawings should not be scaled.

No	Date	Revision/Issued
1	2023 05 19	ISSUED FOR ZBA
2	2024 06 27	RE-ISSUED FOR ZBA RESUBMISSION
3	2024 09 19	RE-ISSUED FOR ZBA RESUBMISSION
4	2024 12 17	DRAFT SPA FOR CLIENT REVIEW
5	2025 04 08	100% DESIGN DEVELOPMENT FOR CLIENT
6	2025 06 02	ISSUED FOR SPA
7	2025 09 15	ISSUED FOR SPA RESUBMISSION
8	2025 11 05	15% CD FOR CLIENT REVIEW
9	2025 12 15	30% CD FOR CLIENT REVIEW
10	2026 03 13	ISSUED FOR PERMIT
11	2026 04 10	75% CD FOR CLIENT REVIEW
14	2026 05 15	90% CD FOR CLIENT REVIEW
15	2026 07 08	ISSUED FOR TENDER
16	2026 07 17	ISSUED FOR ADDENDA 1
17	2026 07 27	ISSUED FOR ADDENDA 3

consultants

architect — CS&P Architects Inc.
2345 Yonge St., Suite 200
Toronto, ON, M4P 2E5
Phone.416.482.5002
Fax.416.482.5040

civil engineer — SCS Consulting Group Ltd.
30 Centurian Drive, Suite 100
Markham, ON, L3R 8B8
Phone.905.475.1900
Fax.905.475.8335

structural engineer — LEA Consulting Ltd.
40 University Ave, Suite 503
Toronto, ON, M5J 1T1
Phone.905.470.0015

mechanical engineer — Smith + Andersen
4211 Yonge Street
Toronto, ON, M2P 2A9
Phone.416.487.8151

electrical engineer — Smith + Andersen
4211 Yonge Street
Toronto, ON, M2P 2A9
Phone.416.487.8151

landscape architect — Quinn Design Associates Inc.
180 John Street
Toronto, ON, M5T 1X5
Phone.416.962.8700

PROJECT NORTH

CS&P Architects

THE STERLING HALL SCHOOL

99 Cartwright Avenue, Toronto, ON M6A 1V4

FLOOR PLAN - LOWER LEVEL

scale:	1 : 50
date:	06/19/24
drawn:	CS&P
checked by:	CA
project number:	21032
drawing number:	A2.10
	Revision: 17

A0

FILENAME: Autodesk Docs://21032 Sterling Hall/21032_SHS-A-MAIN-25.rvt

DRAWING LAST EDITED: 2026-07-27 4:45:25 PM

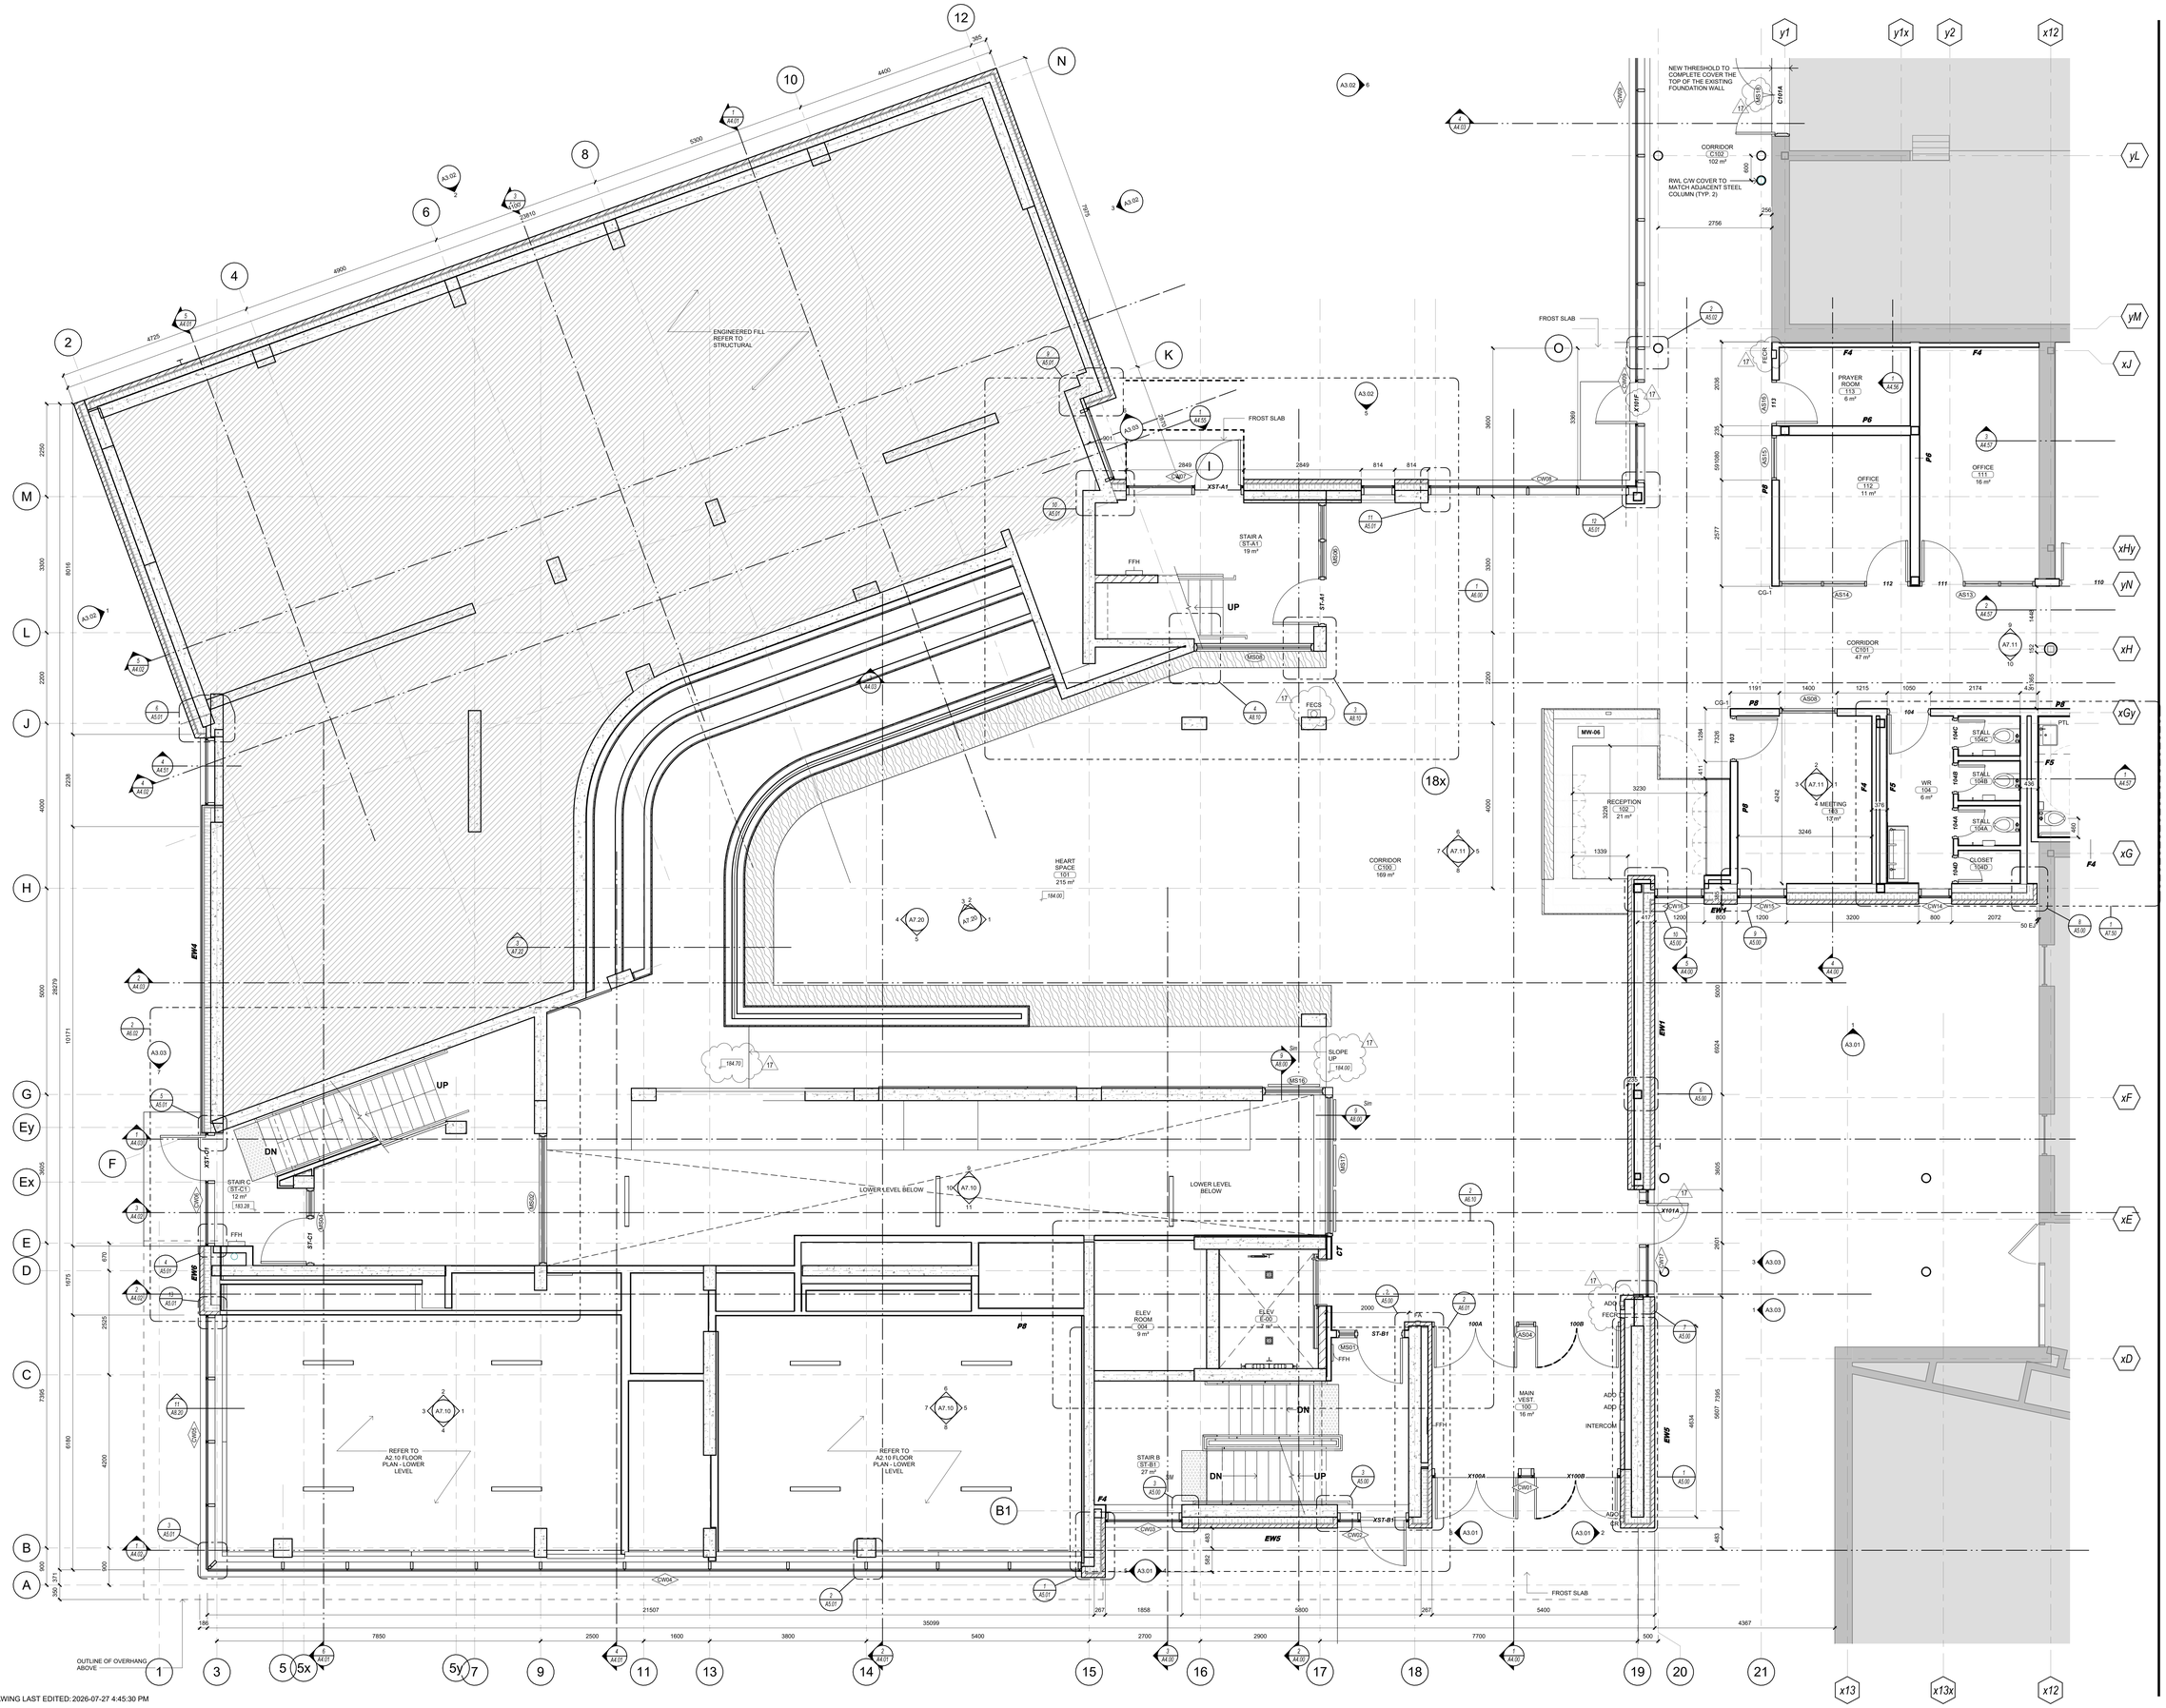

Key to Detail Location

NO. / NO. — Detail Number / Drawing Number

If this sheet is not 46 7/8" x 33 1/8" (1189 x 841 mm) it is a reduced print - Read dwg. accordingly.

Contractors must check and verify all dimensions on the job and report any discrepancies to the Architect before proceeding with the work.

All prints and specifications are the property of the Architect and must be returned at the completion of the work.

Drawings should not be scaled.

No	Date	Revision/Issued
1	2023 05 19	ISSUED FOR ZBA
2	2024 06 27	RE-ISSUED FOR ZBA RESUBMISSION
3	2024 09 19	RE-ISSUED FOR ZBA RESUBMISSION
4	2024 12 17	DRAFT SPA FOR CLIENT REVIEW
5	2025 04 08	100% DESIGN DEVELOPMENT FOR CLIENT
6	2025 06 02	ISSUED FOR SPA
7	2025 09 15	ISSUED FOR SPA RESUBMISSION
8	2025 11 05	15% CD FOR CLIENT REVIEW
9	2025 12 15	30% CD FOR CLIENT REVIEW
10	2026 03 13	ISSUED FOR PERMIT
11	2026 04 10	75% CD FOR CLIENT REVIEW
14	2026 05 15	90% CD FOR CLIENT REVIEW
15	2026 07 08	ISSUED FOR TENDER
16	2026 07 17	ISSUED FOR ADDENDA 1
17	2026 07 27	ISSUED FOR ADDENDA 3

consultants

architect	CS&P Architects Inc. 2345 Yonge St., Suite 200 Toronto, ON, M4P 2E5 Phone.416.482.5002 Fax.416.482.5040
civil engineer	SCS Consulting Group Ltd. 30 Centurian Drive, Suite 100 Markham, ON, L3R 8B8 Phone.905.475.1900 Fax.905.475.8335
structural engineer	LEA Consulting Ltd. 40 University Ave, Suite 503 Toronto, ON, M5J 1T1 Phone.905.470.0015
mechanical engineer	Smith + Andersen 4211 Yonge Street Toronto, ON, M2P 2A9 Phone.416.487.8151
electrical engineer	Smith + Andersen 4211 Yonge Street Toronto, ON, M2P 2A9 Phone.416.487.8151
landscape architect	Quinn Design Associates Inc. 180 John Street Toronto, ON, M5T 1X5 Phone.416.962.8700

PROJECT NORTH

SHS CS&P Architects

THE STERLING HALL SCHOOL

99 Cartwright Avenue, Toronto, ON M6A 1V4

FLOOR PLAN - GROUND LEVEL PART A

scale:	1 : 50
date:	06/19/24
drawn:	CS&P
checked by:	CA
project number:	21032
drawing number:	A2.11
	Revision: 17

A0

FILENAME: Autodesk Docs://21032 Sterling Hall/21032_SHS-A-MAIN-25.rvt

DRAWING LAST EDITED: 2026-07-27 4:45:30 PM

1. REFER TO CONSULTANTS DRAWINGS FOR EXISTING AND NEW SCOPE OF WORK WITHIN SPACE.
2. PLAN PROVIDED FOR REFERENCE SCOPE ONLY AND GENERAL FIRE EXTINGUISHER LOCATIONS.

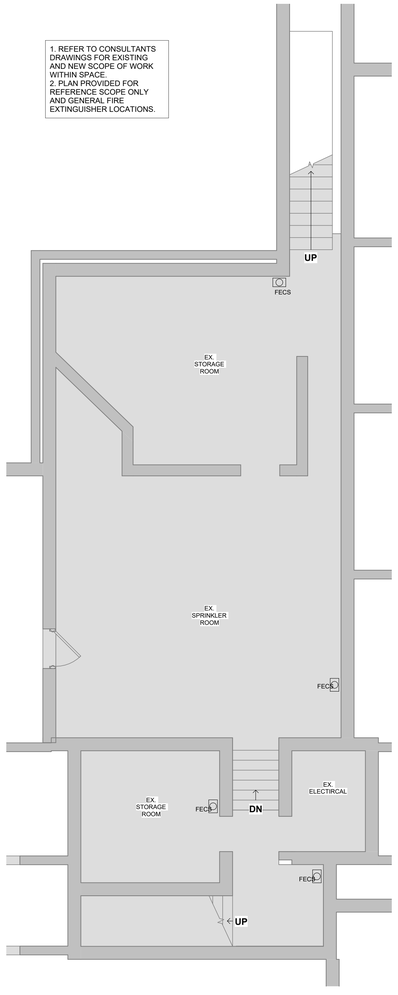

4 A2.12 00 LOWER LEVEL - EXISTING MECHANICAL
1 : 50

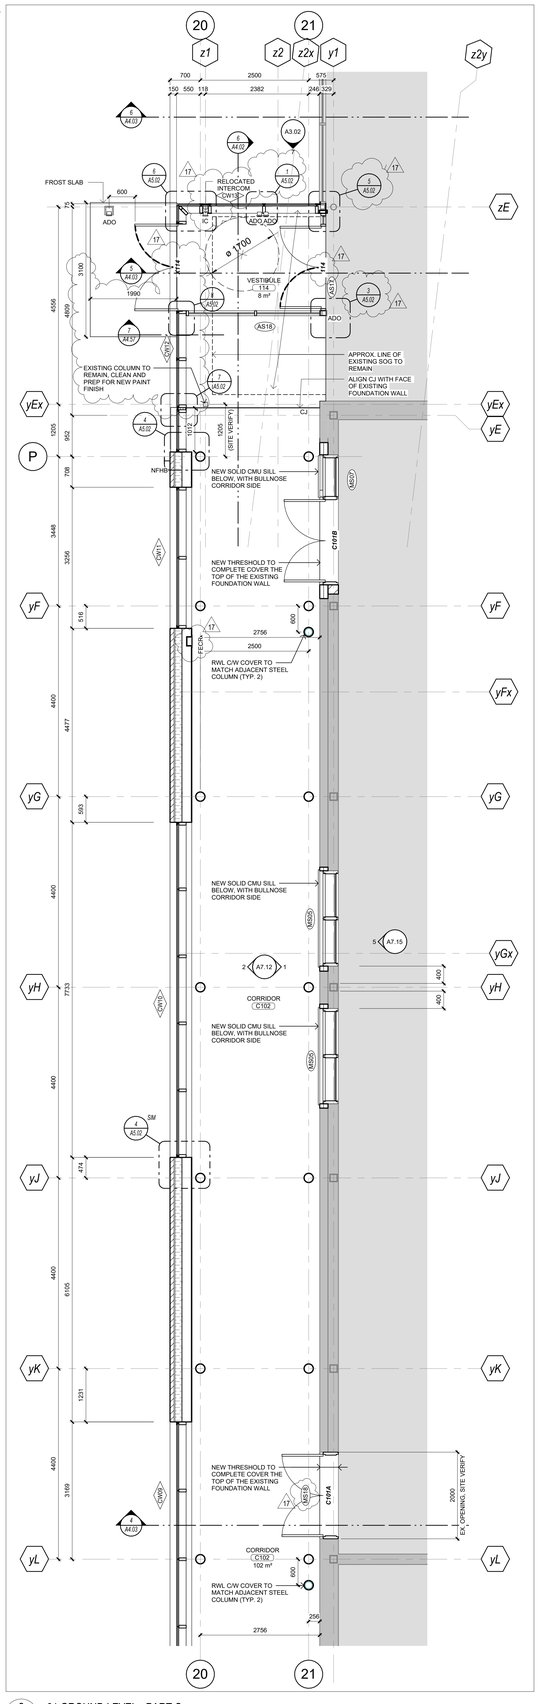

2 A2.12 01 GROUND LEVEL - PART C
1 : 50

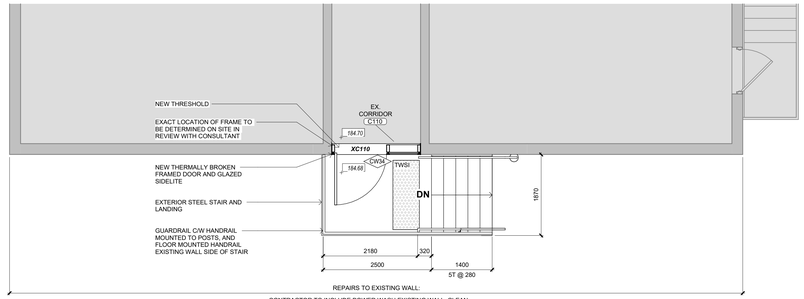

3 A2.12 01 GROUND LEVEL - PART D
1 : 50

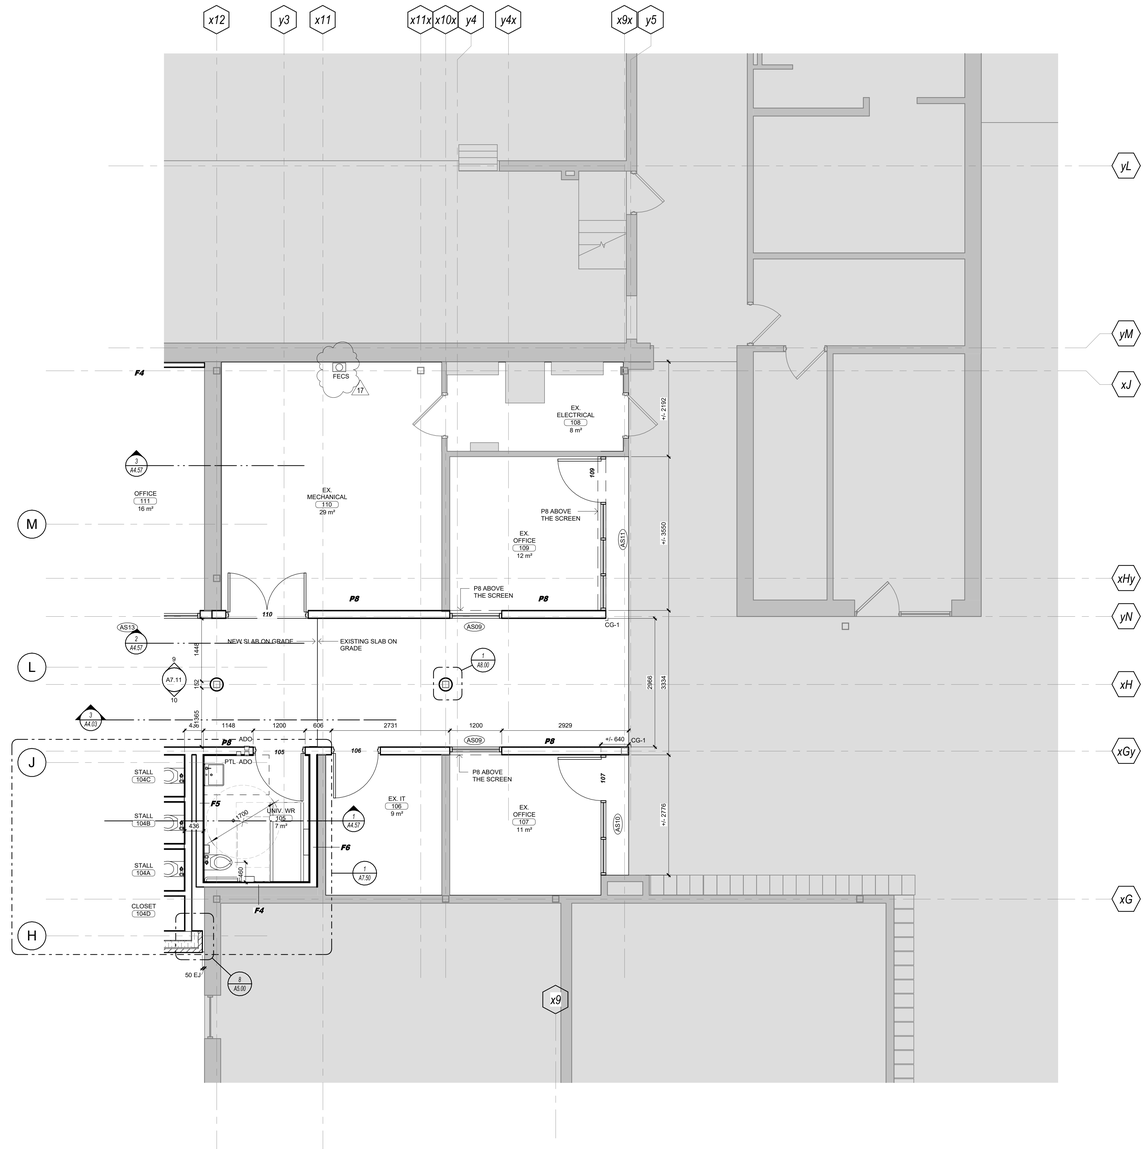

1 A2.12 01 GROUND LEVEL - PART B
1 : 50

Key to Detail Location

NO. Detail Number
NO. Drawing Number

If this sheet is not 46 7/8" x 33 1/8" (1189 x 841 mm) it is a reduced print - Read dwg. accordingly.

Contractors must check and verify all dimensions on the job and report any discrepancies to the Architect before proceeding with the work.

All prints and specifications are the property of the Architect and must be returned at the completion of the work.

Drawings should not be scaled.

No	Date	Revision/Issued
10	2026 03 13	ISSUED FOR PERMIT
11	2026 04 10	75% CD FOR CLIENT REVIEW
14	2026 05 15	90% CD FOR CLIENT REVIEW
15	2026 07 08	ISSUED FOR TENDER
16	2026 07 17	ISSUED FOR ADDENDA 1
17	2026 07 27	ISSUED FOR ADDENDA 3

consultants

architect CS&P Architects Inc.
2345 Yonge St., Suite 200
Toronto, ON, M4P 2E5
Phone.416.482.5002
Fax.416.482.5040

civil engineer SCS Consulting Group Ltd.
30 Centurian Drive, Suite 100
Markham, ON, L3R 8B8
Phone.905.475.1900
Fax.905.475.8335

structural engineer LEA Consulting Ltd.
40 University Ave, Suite 503
Toronto, ON, M5J 1T1
Phone.905.470.0015

mechanical engineer Smith + Andersen
4211 Yonge Street
Toronto, ON, M2P 2A9
Phone.416.487.8151

electrical engineer Smith + Andersen
4211 Yonge Street
Toronto, ON, M2P 2A9
Phone.416.487.8151

landscape architect Quinn Design Associates Inc.
180 John Street
Toronto, ON, M5T 1X5
Phone.416.962.8700

PROJECT NORTH N

SHS CS&P Architects

THE STERLING HALL SCHOOL

99 Cartwright Avenue, Toronto, ON M6A 1V4

FLOOR PLANS - GROUND LEVEL PARTS B, C, D, & EX. LOWER LEVEL

scale: 1 : 50
date: 01/23/26
drawn: CS&P
checked by: CA
project number: 21032
drawing number: A2.12
Revision: 17

A0

FILENAME: Autodesk Docs://21032 Sterling Hall/21032_SHS-A-MAIN-25.rvt
DRAWING LAST EDITED: 2026-07-27 4:45:33 PM

Key to Detail Location

NO. / NO. — Detail Number / Drawing Number

If this sheet is not 46 7/8" x 33 1/8" (1189 x 841 mm) it is a reduced print - Read dwg. accordingly.

Contractors must check and verify all dimensions on the job and report any discrepancies to the Architect before proceeding with the work.

All prints and specifications are the property of the Architect and must be returned at the completion of the work.

Drawings should not be scaled.

No	Date	Revision/Issued
1	2023 05 19	ISSUED FOR ZBA
2	2024 06 27	RE-ISSUED FOR ZBA RESUBMISSION
3	2024 09 19	RE-ISSUED FOR ZBA RESUBMISSION
4	2024 12 17	DRAFT SPA FOR CLIENT REVIEW
5	2025 04 08	100% DESIGN DEVELOPMENT FOR CLIENT
6	2025 06 02	ISSUED FOR SPA
7	2025 09 15	ISSUED FOR SPA RESUBMISSION
8	2025 11 05	15% CD FOR CLIENT REVIEW
9	2025 12 15	30% CD FOR CLIENT REVIEW
10	2026 03 13	ISSUED FOR PERMIT
11	2026 04 10	75% CD FOR CLIENT REVIEW
12	2026 04 22	ISSUED FOR PERMIT COMMENTS 1
14	2026 05 15	90% CD FOR CLIENT REVIEW
15	2026 07 08	ISSUED FOR TENDER
16	2026 07 17	ISSUED FOR ADDENDA 1
17	2026 07 27	ISSUED FOR ADDENDA 3

consultants

architect — CS&P Architects Inc., 2345 Yonge St., Suite 200, Toronto, ON, M4P 2E5, Phone.416.482.5002, Fax.416.482.5040

civil engineer — SCS Consulting Group Ltd., 30 Centurian Drive, Suite 100, Markham, ON, L3R 8B8, Phone.905.475.1900, Fax.905.475.8335

structural engineer — LEA Consulting Ltd., 40 University Ave, Suite 503, Toronto, ON, M5J 1T1, Phone.905.470.0015

mechanical engineer — Smith + Andersen, 4211 Yonge Street, Toronto, ON, M2P 2A9, Phone.416.487.8151

electrical engineer — Smith + Andersen, 4211 Yonge Street, Toronto, ON, M2P 2A9, Phone.416.487.8151

landscape architect — Quinn Design Associates Inc., 180 John Street, Toronto, ON, M5T 1X5, Phone.416.962.8700

PROJECT NORTH / N

SHS CS&P Architects

THE STERLING HALL SCHOOL

99 Cartwright Avenue, Toronto, ON M6A 1V4

FLOOR PLAN - UPPER GROUND LEVEL

scale:	1 : 50
date:	06/25/24
drawn:	CS&P
checked by:	CA
project number:	21032
drawing number:	A2.13
	Revision: 17

A0

FILENAME: Autodesk Docs://21032 Sterling Hall/21032_SHS-A-MAIN-25.rvt

DRAWING LAST EDITED: 2026-07-27 4:45:39 PM

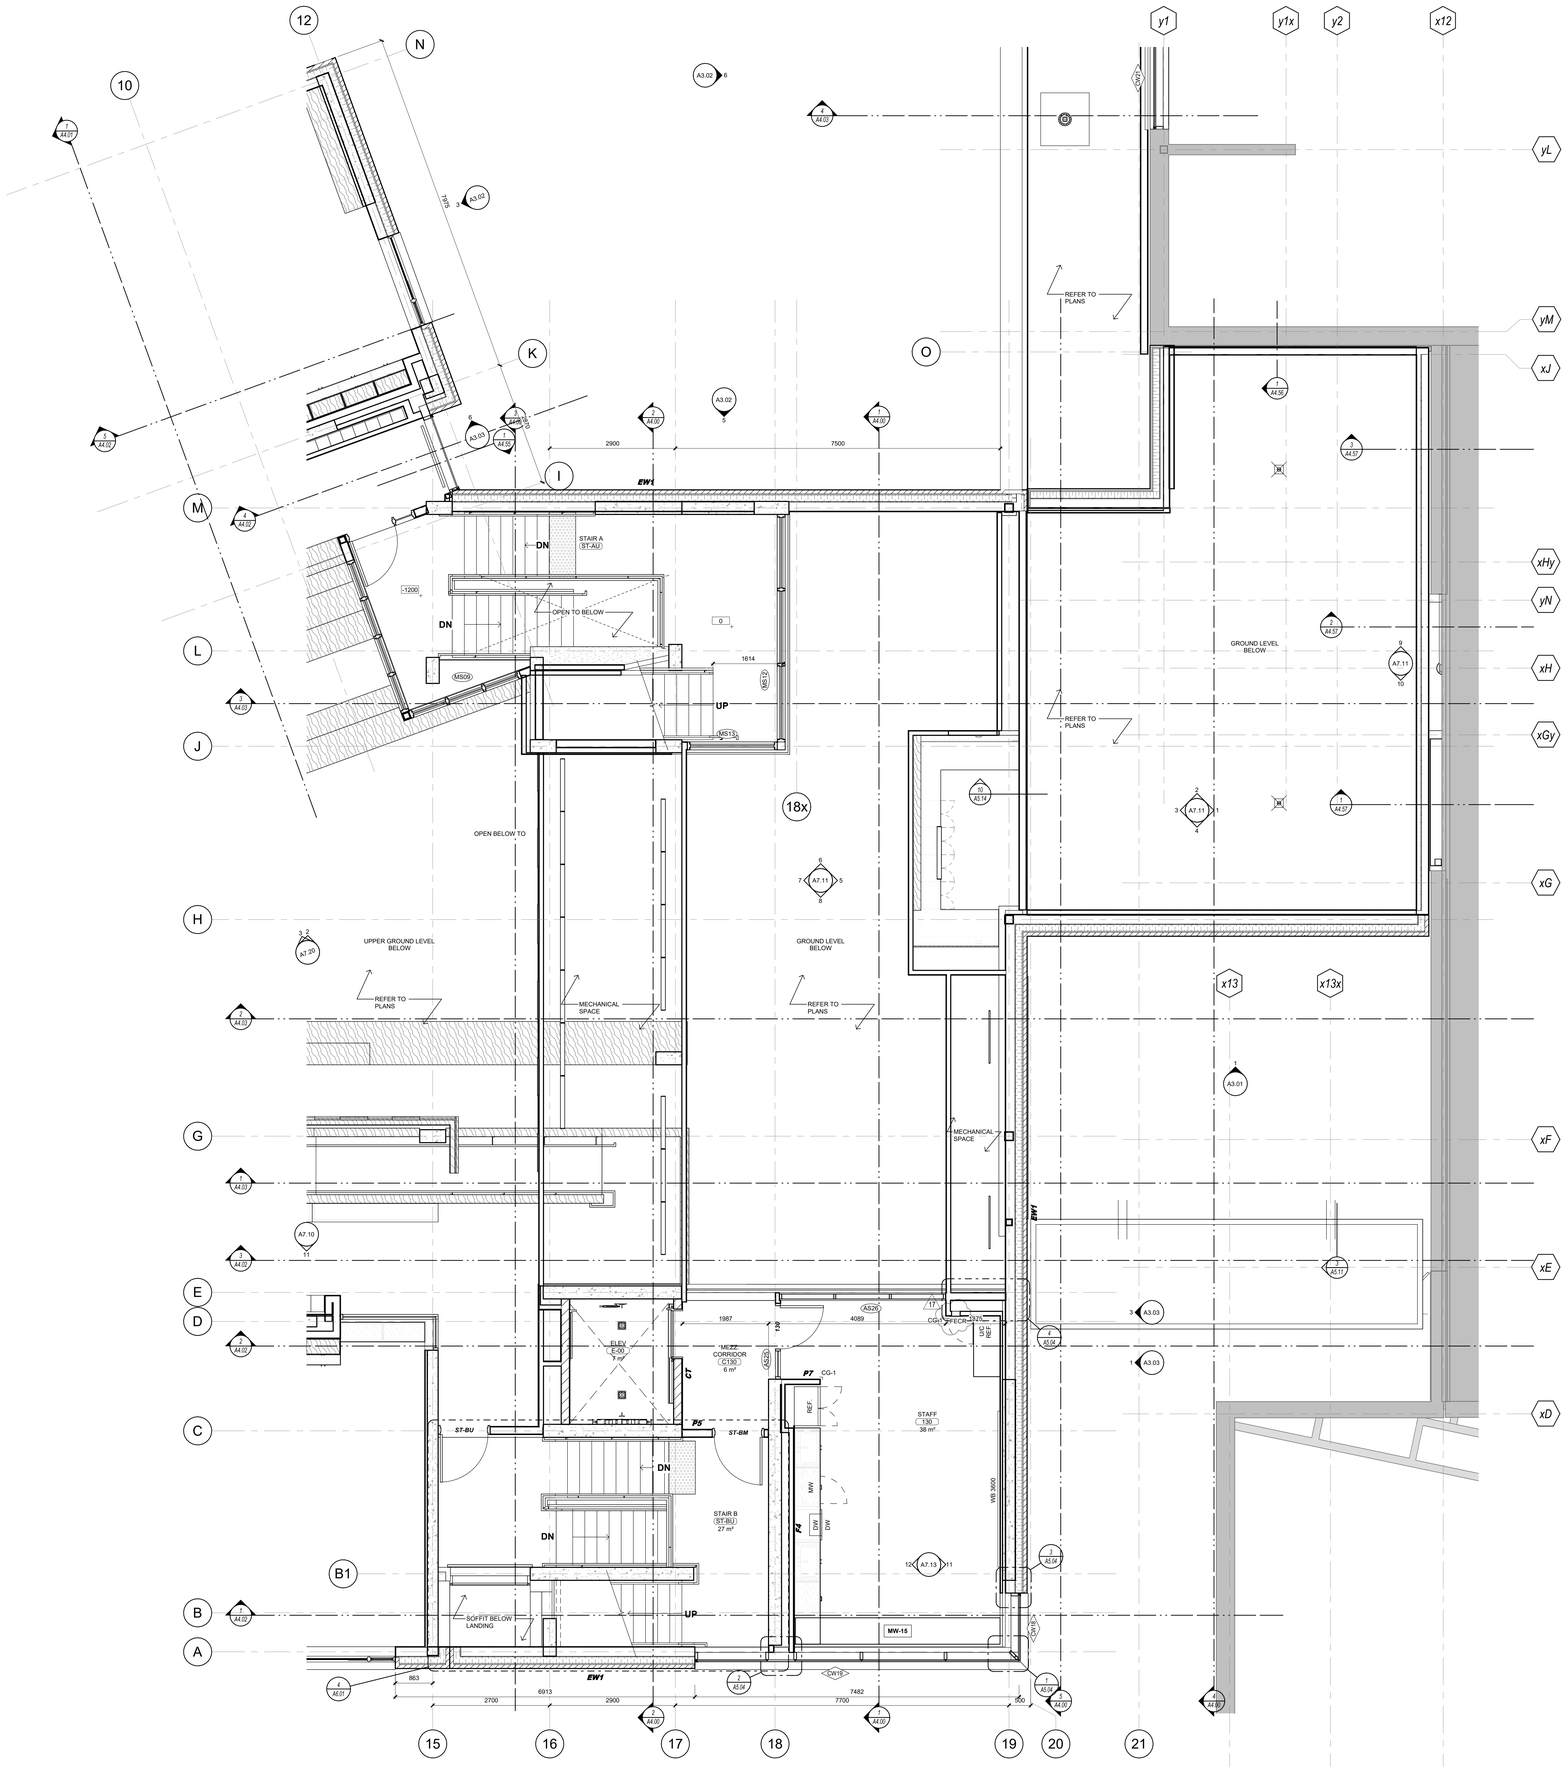

Key to Detail Location

NO. — Detail Number
NO. — Drawing Number

If this sheet is not 46 7/8" x 33 1/8" (1189 x 841 mm) it is a reduced print - Read dwg. accordingly.

Contractors must check and verify all dimensions on the job and report any discrepancies to the Architect before proceeding with the work.

All prints and specifications are the property of the Architect and must be returned at the completion of the work.

Drawings should not be scaled.

No	Date	Revision/Issued
10	2026 03 13	ISSUED FOR PERMIT
11	2026 04 10	75% CD FOR CLIENT REVIEW
12	2026 04 22	ISSUED FOR PERMIT COMMENTS 1
14	2026 05 15	90% CD FOR CLIENT REVIEW
15	2026 07 08	ISSUED FOR TENDER
16	2026 07 17	ISSUED FOR ADDENDA 1
17	2026 07 27	ISSUED FOR ADDENDA 3

consultants

architect — CS&P Architects Inc.
2345 Yonge St., Suite 200
Toronto, ON, M4P 2E5
Phone.416.482.5002
Fax.416.482.5040

civil engineer — SCS Consulting Group Ltd.
30 Centurian Drive, Suite 100
Markham, ON, L3R 8B8
Phone.905.475.1900
Fax.905.475.8335

structural engineer — LEA Consulting Ltd.
40 University Ave, Suite 503
Toronto, ON, M5J 1T1
Phone.905.470.0015

mechanical engineer — Smith + Andersen
4211 Yonge Street
Toronto, ON, M2P 2A9
Phone.416.487.8151

electrical engineer — Smith + Andersen
4211 Yonge Street
Toronto, ON, M2P 2A9
Phone.416.487.8151

landscape architect — Quinn Design Associates Inc.
160 John Street
Toronto, ON, M5T 1X5
Phone.416.962.8700

PROJECT NORTH

CS&P Architects

THE STERLING HALL SCHOOL

99 Cartwright Avenue, Toronto, ON M6A 1V4

FLOOR PLAN - MEZZANINE LEVEL

scale:	1 : 50
date:	01/23/26
drawn:	CS&P
checked by:	CA
project number:	21032
drawing number:	A2.14
	Revision: 17

A0

FILENAME: Autodesk Docs://21032 Sterling Hall/21032_SHS-A-MAIN-25.rvt

DRAWING LAST EDITED: 2026-07-27 4:45:42 PM

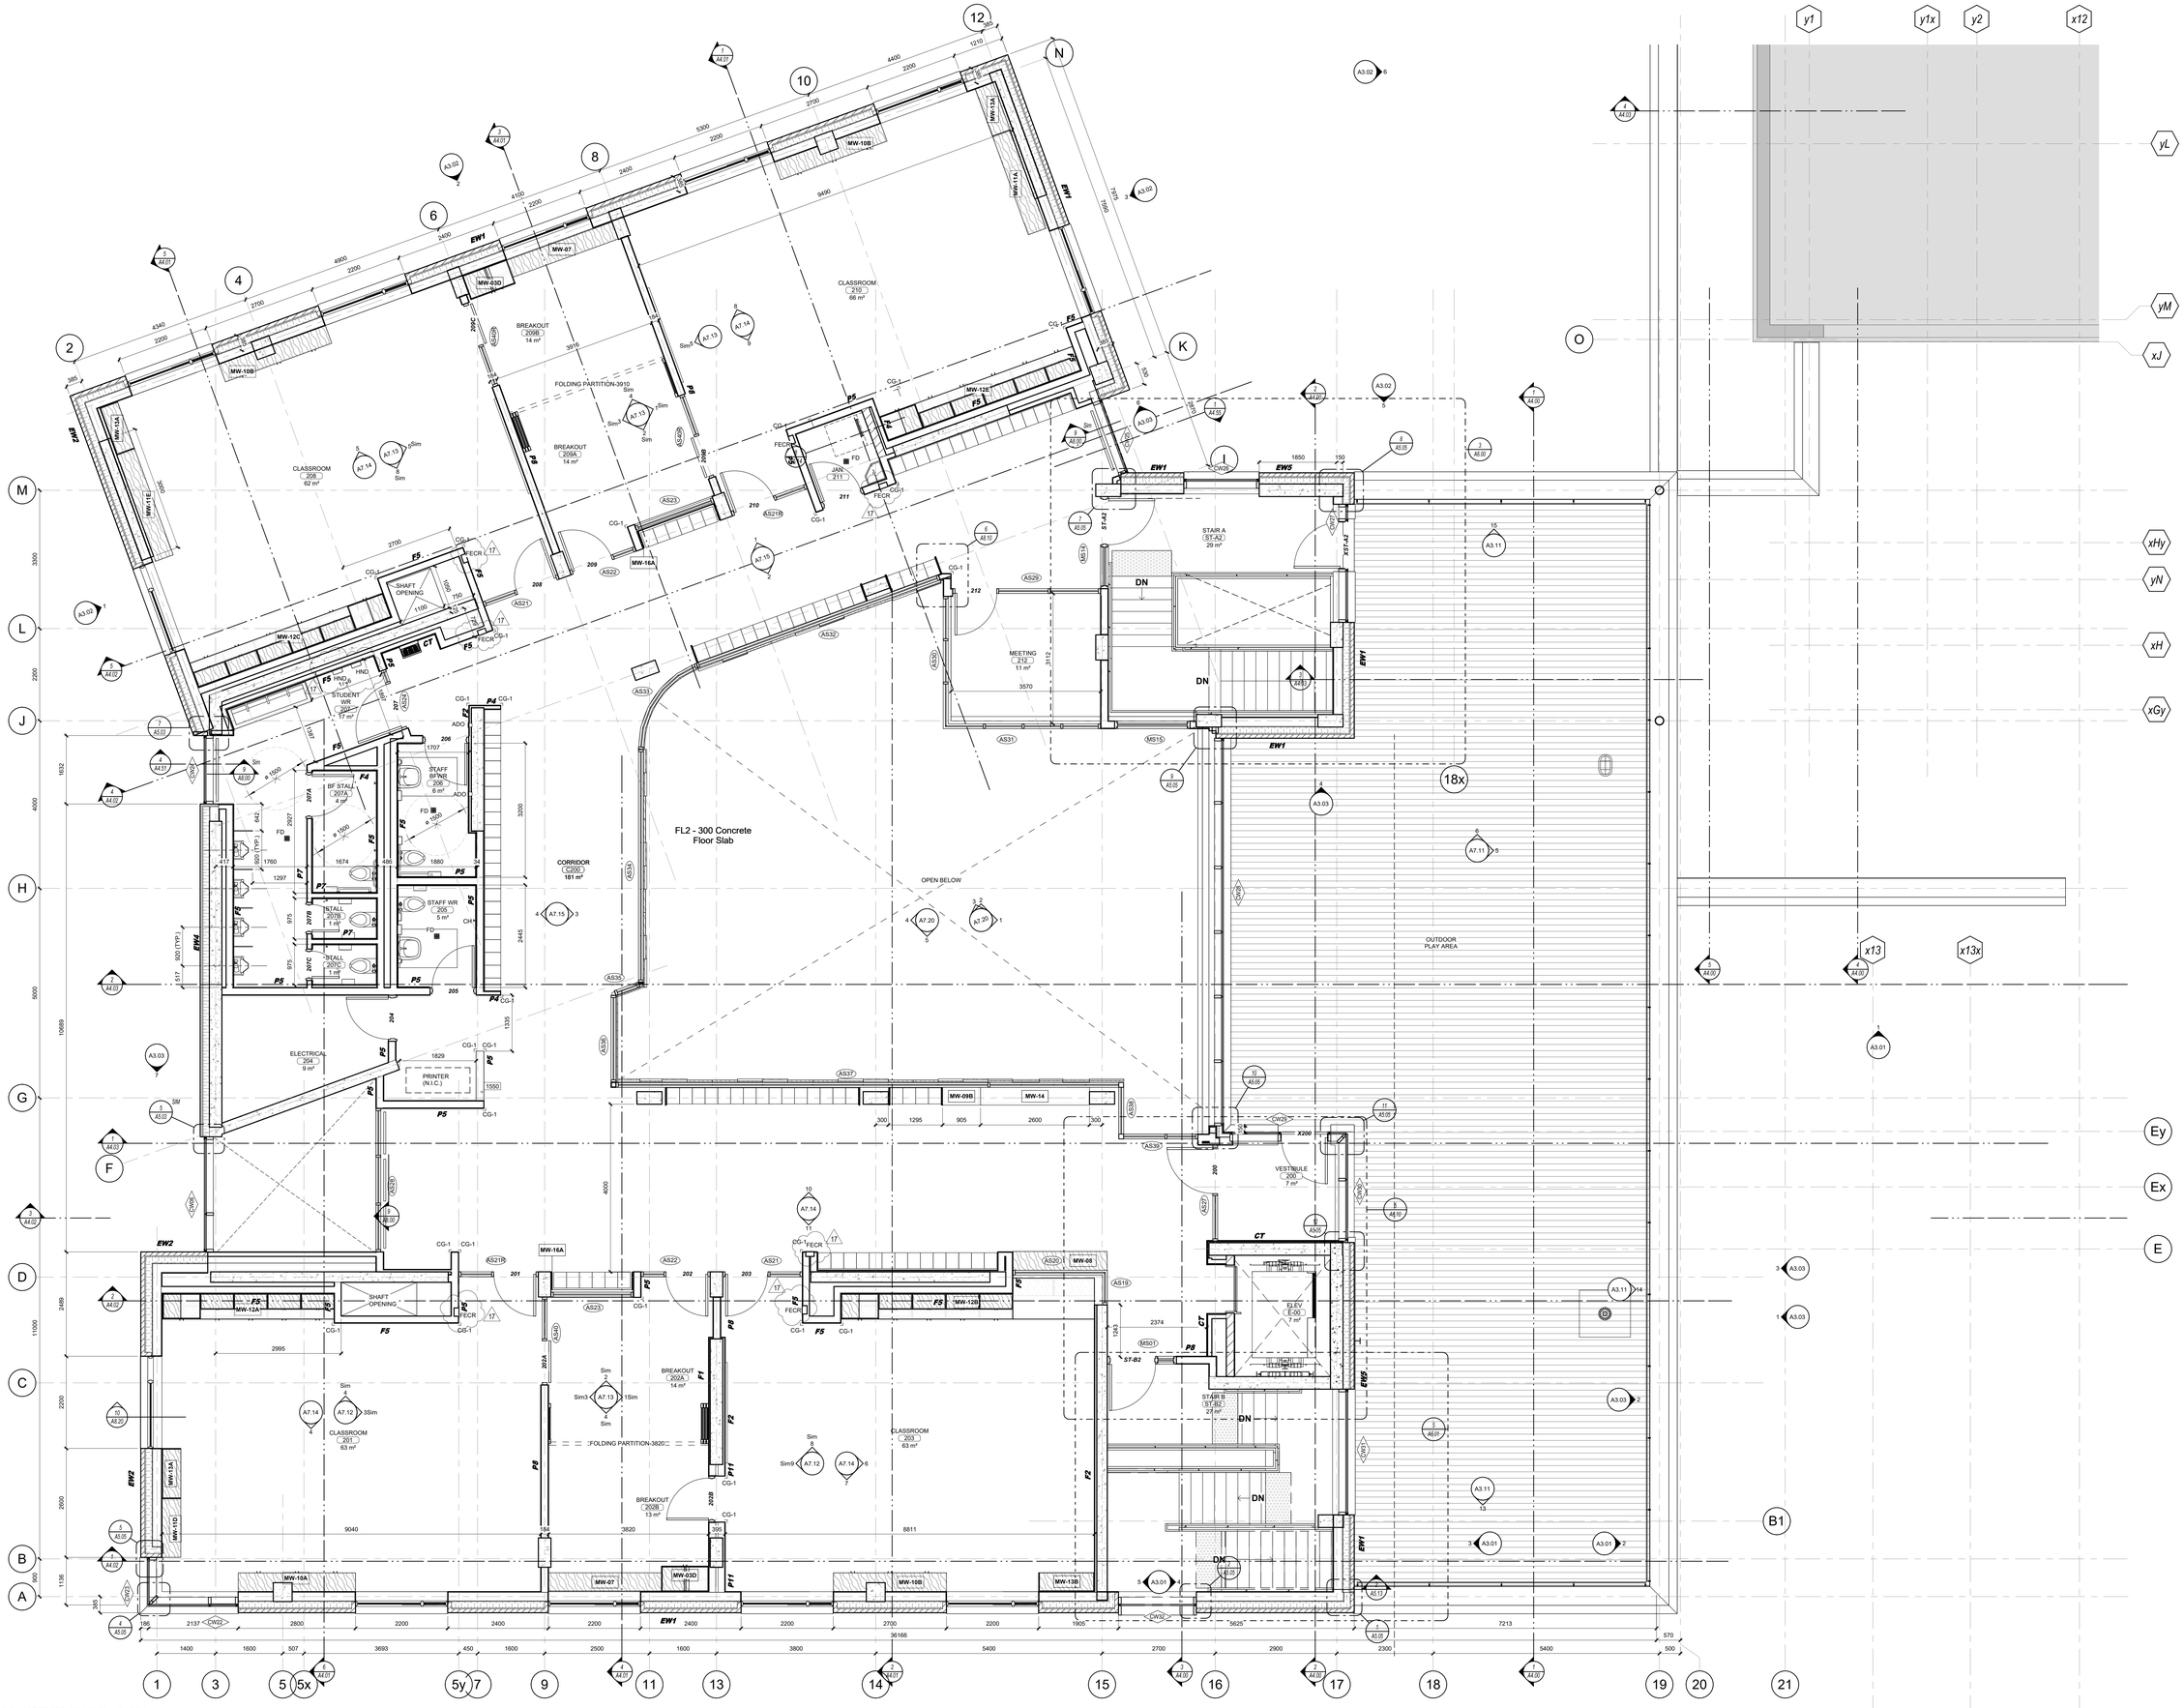
FL2 - 300 Concrete Floor Slab
CLASSROOM 208 62 m²
CLASSROOM 201 63 m²
CLASSROOM 203 63 m²
BREAKOUT 209B 14 m²
BREAKOUT 209A 14 m²
FOLDING PARTITION-3910
FOLDING PARTITION-3820
SHAFT OPENING
STAIR A ST-A2 29 m²
STAIR B ST-B2 27 m²
MEETING 212 11 m²
CORRIDOR 200 181 m²
BREAKOUT 202A 14 m²
BREAKOUT 202B 13 m²
STUDENT WR 207 17 m²
STAFF BFNR 206 6 m²
STAFF WR 205 5 m²
1 BF STALL 207A 4 m²
1 STALL 207B 1 m²
1 STALL 207C 1 m²
ELECTRICAL 204 9 m²
PRINTER (N.I.C.)
VESTIBULE 200 7 m²
ELEV. E-00 7 m²
OUTDOOR PLAY AREA
OPEN BELOW
DN
CT
MW-10A
MW-10B
MW-11D
MW-12A
MW-12B
MW-12C
MW-13A
MW-13B
MW-14
MW-16A
EW1
EW2
EW5
X200
ST-A2
ST-B2
FECR
JAN
FD
ADO
CHR
HND
SHR
CG-1
F1
F2
F4
F5
F6
F7
P1
P2
P4
P5
P6
P7
P8
P11
AS15
AS16
AS17
AS18
AS19
AS20
AS21
AS21B
AS22
AS23
AS24
AS25
AS26
AS27
AS28
AS29
AS30
AS31
AS32
AS33
AS34
AS35
AS36
AS37
AS38
AS39
MS01
MS15
MS16

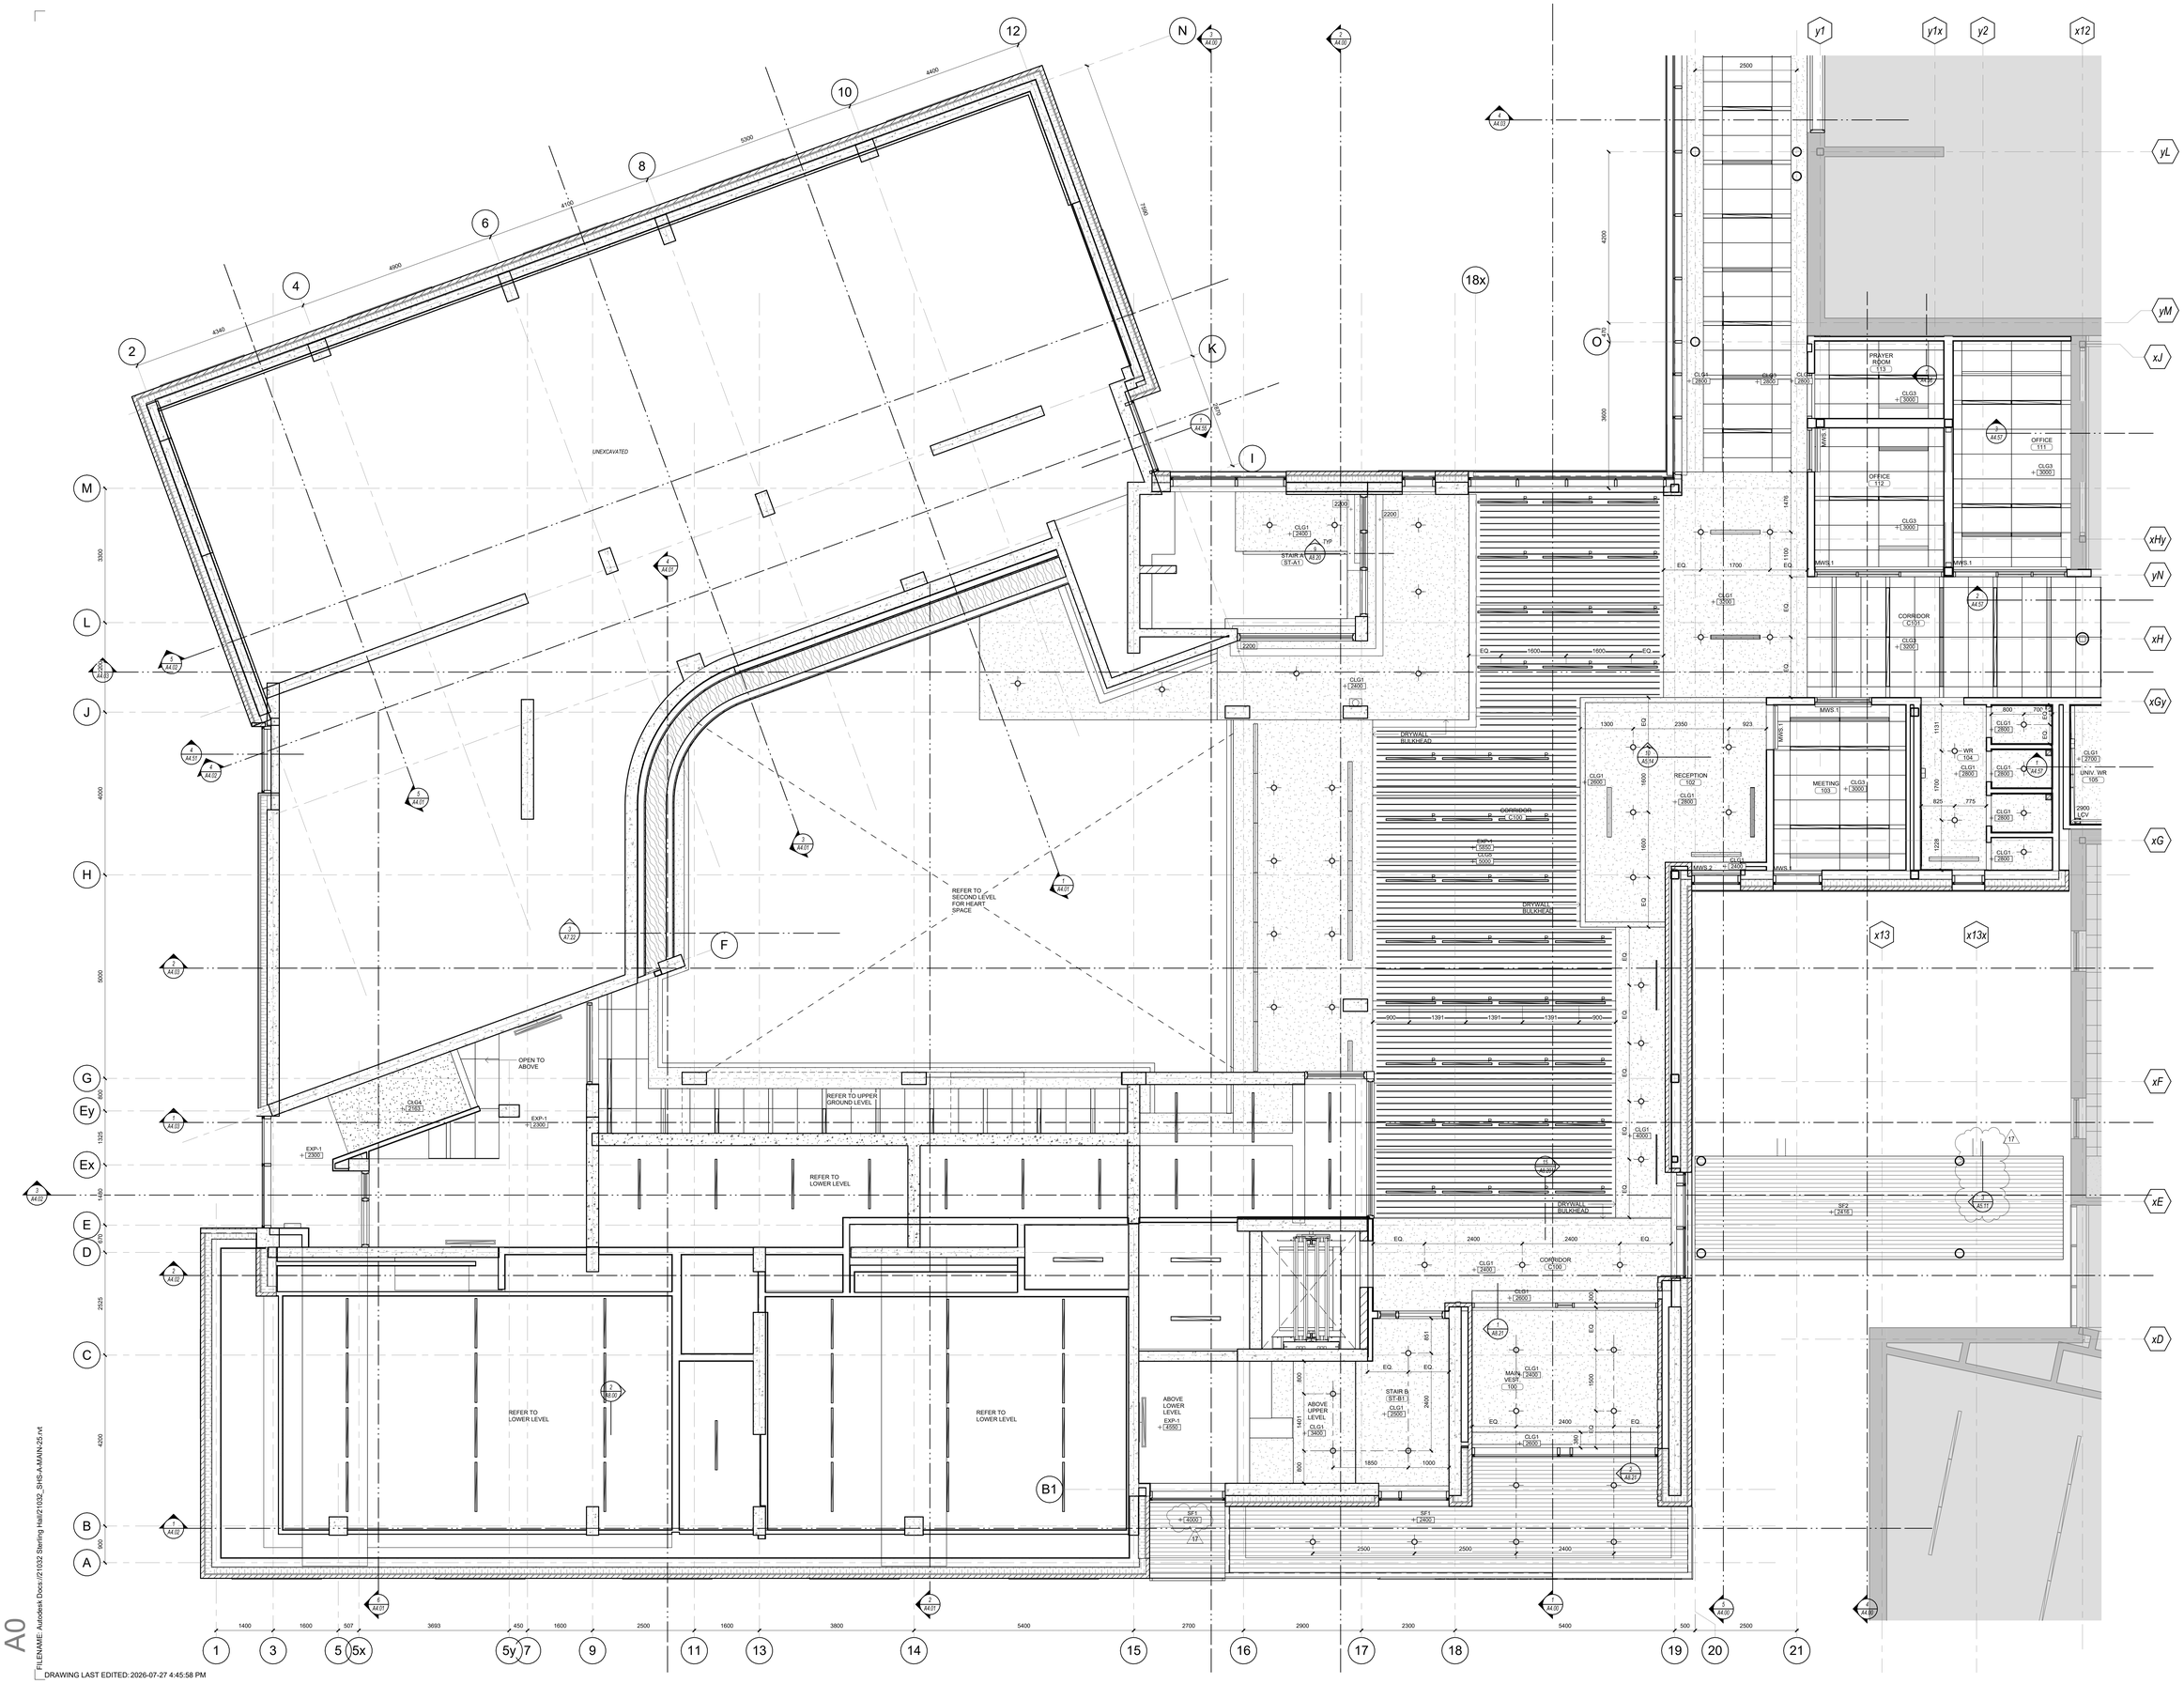

Key to Detail Location

NO. — Detail Number
NO. — Drawing Number

If this sheet is not 46 7/8" x 33 1/8" (1189 x 841 mm) it is a reduced print - Read dwg. accordingly.

Contractors must check and verify all dimensions on the job and report any discrepancies to the Architect before proceeding with the work.

All prints and specifications are the property of the Architect and must be returned at the completion of the work.

Drawings should not be scaled.

No	Date	Revision/Issued
1	2023 05 19	ISSUED FOR ZBA
2	2024 06 27	RE-ISSUED FOR ZBA RESUBMISSION
3	2024 09 19	RE-ISSUED FOR ZBA RESUBMISSION
4	2024 12 17	DRAFT SPA FOR CLIENT REVIEW
5	2025 04 08	100% DESIGN DEVELOPMENT FOR CLIENT
6	2025 06 02	ISSUED FOR SPA
7	2025 09 15	ISSUED FOR SPA RESUBMISSION
8	2025 11 05	15% CD FOR CLIENT REVIEW
9	2025 12 15	30% CD FOR CLIENT REVIEW
10	2026 03 13	ISSUED FOR PERMIT
11	2026 04 10	75% CD FOR CLIENT REVIEW
14	2026 05 15	90% CD FOR CLIENT REVIEW
15	2026 07 08	ISSUED FOR TENDER
16	2026 07 17	ISSUED FOR ADDENDA 1
17	2026 07 27	ISSUED FOR ADDENDA 3

consultants

architect — CS&P Architects Inc.
2345 Yonge St., Suite 200
Toronto, ON, M4P 2E5
Phone.416.482.5002
Fax.416.482.5040

civil engineer — SCS Consulting Group Ltd.
30 Centurian Drive, Suite 100
Markham, ON, L3R 8B8
Phone.905.475.1900
Fax.905.475.8335

structural engineer — LEA Consulting Ltd.
40 University Ave, Suite 503
Toronto, ON, M5J 1T1
Phone.905.470.0015

mechanical engineer — Smith + Andersen
4211 Yonge Street
Toronto, ON, M2P 2A9
Phone.416.487.8151

electrical engineer — Smith + Andersen
4211 Yonge Street
Toronto, ON, M2P 2A9
Phone.416.487.8151

landscape architect — Quinn Design Associates Inc.
180 John Street
Toronto, ON, M5T 1X5
Phone.416.962.8700

PROJECT NORTH

CS&PArchitects

THE STERLING HALL SCHOOL

99 Cartwright Avenue, Toronto, ON M6A 1V4

REFLECTED CEILING PLAN - GROUND LEVEL PART A

scale:	1 : 50
date:	06/25/24
drawn:	CS&P
checked by:	CA
project number:	21032
drawing number:	A2.31
	Revision: 17

A0

FILENAME: Autodesk Docs://21032 Sterling Hall/21032_SHS-A-MAIN-25.rvt

DRAWING LAST EDITED: 2026-07-27 4:45:58 PM

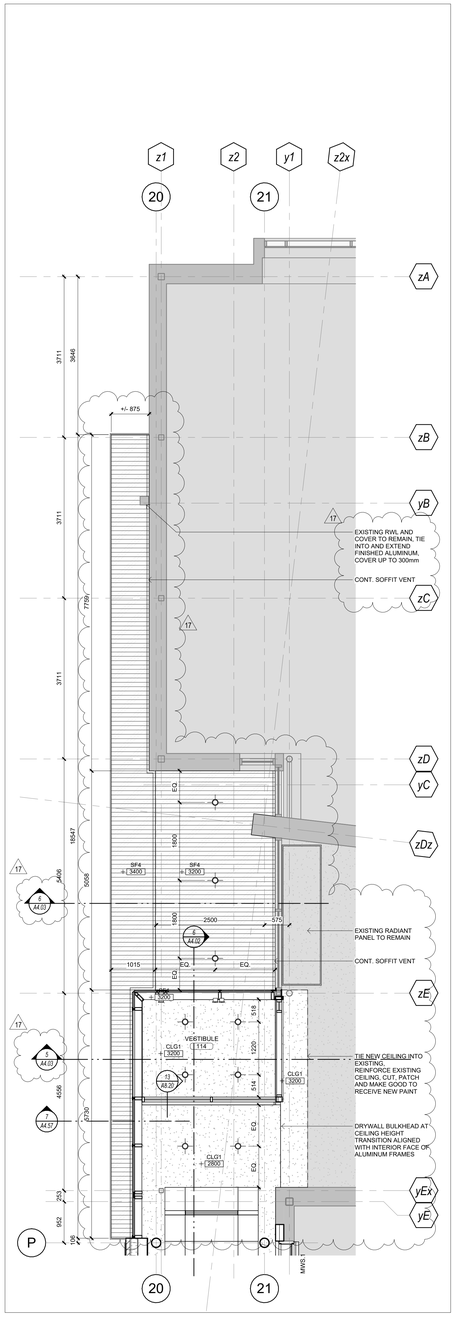

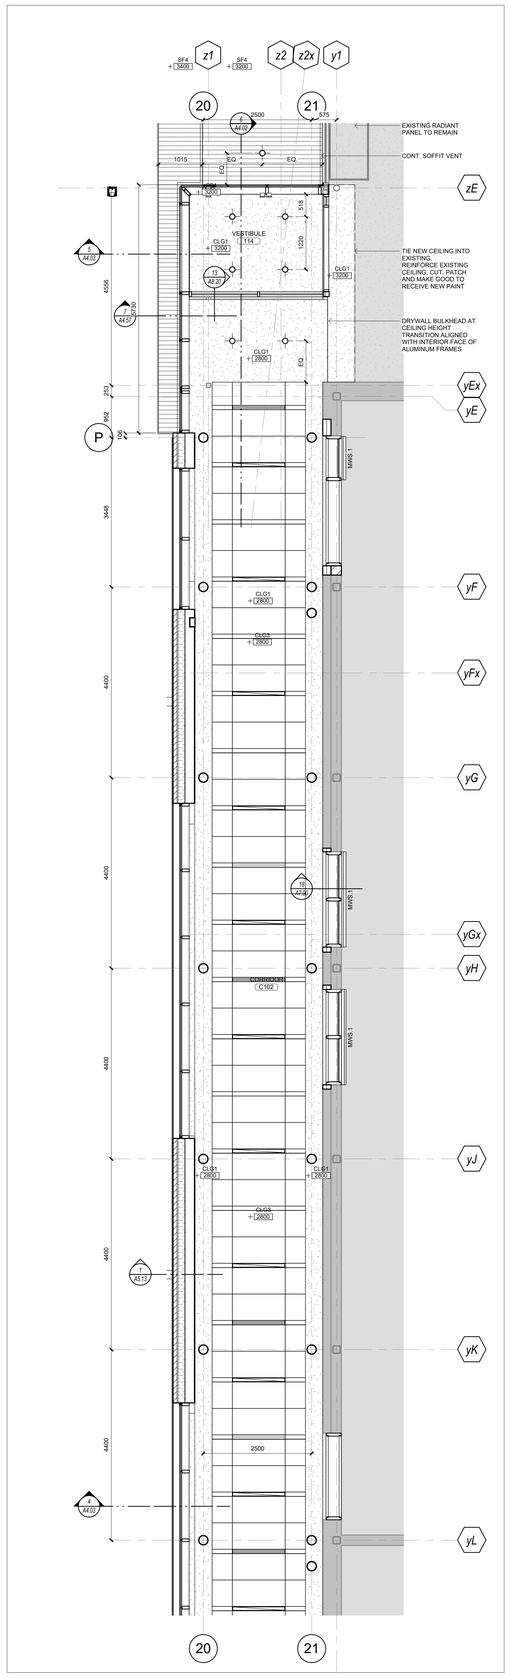

2 A2.32 01 GROUND LEVEL - PART C
1 : 50

1 A2.32 01 GROUND LEVEL - PART B
1 : 50

Key to Detail Location

NO. Detail Number
NO. Drawing Number

If this sheet is not 46 7/8" x 33 1/8" (1189 x 841 mm) it is a reduced print - Read dwg. accordingly.

Contractors must check and verify all dimensions on the job and report any discrepancies to the Architect before proceeding with the work.

All prints and specifications are the property of the Architect and must be returned at the completion of the work.

Drawings should not be scaled.

No	Date	Revision/Issued
10	2026 03 13	ISSUED FOR PERMIT
11	2026 04 10	75% CD FOR CLIENT REVIEW
14	2026 05 15	90% CD FOR CLIENT REVIEW
15	2026 07 08	ISSUED FOR TENDER
16	2026 07 17	ISSUED FOR ADDENDA 1
17	2026 07 27	ISSUED FOR ADDENDA 3

consultants

architect
CS&P Architects Inc.
2345 Yonge St., Suite 200
Toronto, ON, M4P 2E5
Phone.416.482.5002
Fax.416.482.5040

civil engineer
SCS Consulting Group Ltd.
30 Centurian Drive, Suite 100
Markham, ON, L3R 8B8
Phone.905.475.1900
Fax.905.475.8335

structural engineer
LEA Consulting Ltd.
40 University Ave, Suite 503
Toronto, ON, M5J 1T1
Phone.905.470.0015

mechanical engineer
Smith + Andersen
4211 Yonge Street
Toronto, ON, M2P 2A9
Phone.416.487.8151

electrical engineer
Smith + Andersen
4211 Yonge Street
Toronto, ON, M2P 2A9
Phone.416.487.8151

landscape architect
Quinn Design Associates Inc.
180 John Street
Toronto, ON, M5T 1X5
Phone.416.962.8700

PROJECT NORTH

CS&P Architects

THE STERLING HALL SCHOOL

99 Cartwright Avenue, Toronto, ON M6A 1V4

REFLECTED CEILING PLAN - GROUND LEVEL PARTS B, C & D

scale: 1 : 50
date: 02/10/26
drawn: CS&P
checked by: CA
project number: 21032
drawing number: A2.32
Revision: 17

A0

FILENAME: Autodesk Docs://21032 Sterling Hall/21032_SHS-A-MAIN-25.rvt

DRAWING LAST EDITED: 2026-07-27 4:46:02 PM

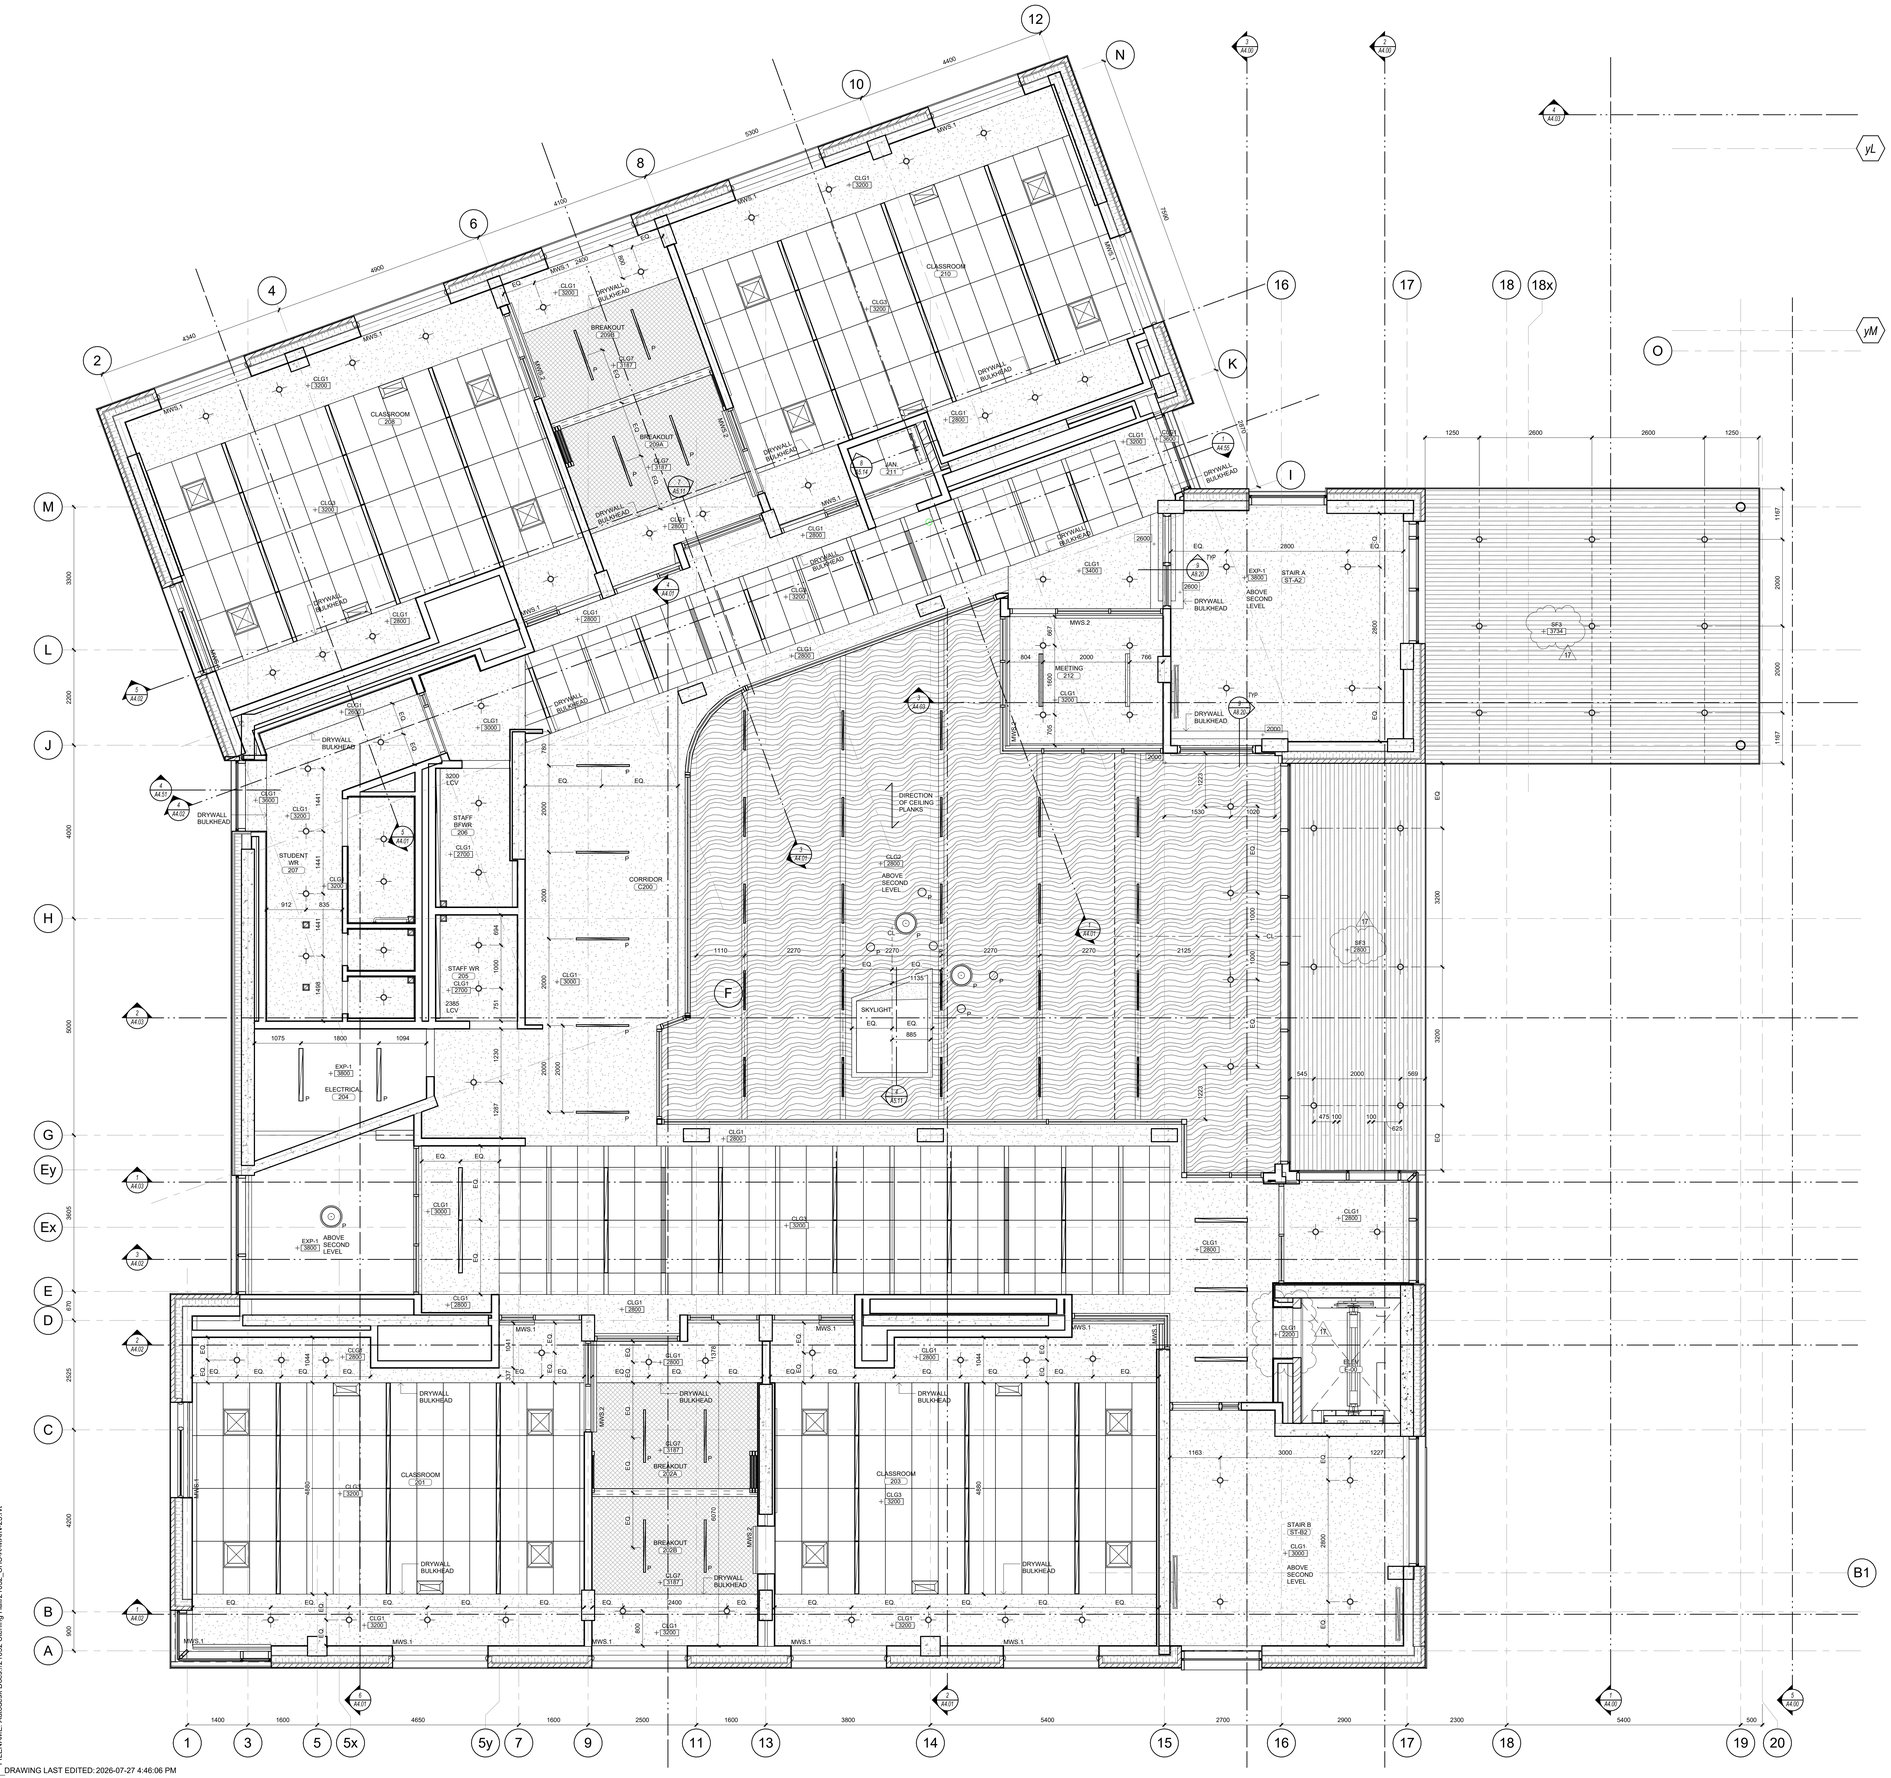

Key to Detail Location

NO. / NO. — Detail Number / Drawing Number

If this sheet is not 46 7/8" x 33 1/8" (1189 x 841 mm) It is a reduced print - Read dwg. accordingly.

Contractors must check and verify all dimensions on the job and report any discrepancies to the Architect before proceeding with the work.

All prints and specifications are the property of the Architect and must be returned at the completion of the work.

Drawings should not be scaled.

No	Date	Revision/Issued
1	2023 05 19	ISSUED FOR ZBA
2	2024 06 27	RE-ISSUED FOR ZBA RESUBMISSION
3	2024 09 19	RE-ISSUED FOR ZBA RESUBMISSION
4	2024 12 17	DRAFT SPA FOR CLIENT REVIEW
5	2025 04 08	100% DESIGN DEVELOPMENT FOR CLIENT
6	2025 06 02	ISSUED FOR SPA
7	2025 09 15	ISSUED FOR SPA RESUBMISSION
8	2025 11 05	15% CD FOR CLIENT REVIEW
9	2025 12 15	30% CD FOR CLIENT REVIEW
10	2026 03 13	ISSUED FOR PERMIT
11	2026 04 10	75% CD FOR CLIENT REVIEW
14	2026 05 15	90% CD FOR CLIENT REVIEW
15	2026 07 08	ISSUED FOR TENDER
16	2026 07 17	ISSUED FOR ADDENDA 1
17	2026 07 27	ISSUED FOR ADDENDA 3

consultants

architect — CS&P Architects Inc., 2345 Yonge St., Suite 200, Toronto, ON, M4P 2E5, Phone.416.482.5002, Fax.416.482.5040

civil engineer — SCS Consulting Group Ltd., 30 Centurian Drive, Suite 100, Markham, ON, L3R 8B8, Phone.905.475.1900, Fax.905.475.8335

structural engineer — LEA Consulting Ltd., 40 University Ave, Suite 503, Toronto, ON, M5J 1T1, Phone.905.470.0015

mechanical engineer — Smith + Andersen, 4211 Yonge Street, Toronto, ON, M2P 2A9, Phone.416.487.8151

electrical engineer — Smith + Andersen, 4211 Yonge Street, Toronto, ON, M2P 2A9, Phone.416.487.8151

landscape architect — Quinn Design Associates Inc., 180 John Street, Toronto, ON, M5T 1X5, Phone.416.962.8700

PROJECT NORTH

SHS CS&P Architects

THE STERLING HALL SCHOOL

99 Cartwright Avenue, Toronto, ON M6A 1V4

REFLECTED CEILING PLAN - SECOND LEVEL

scale:	1 : 50
date:	06/25/24
drawn:	CS&P
checked by:	CA
project number:	21032
drawing number:	A2.34
	Revision: 17

A0

FILENAME: Autodesk Docs://21032 Sterling Hall/21032_SHS-A-MAIN-25.rvt

DRAWING LAST EDITED: 2026-07-27 4:46:06 PM

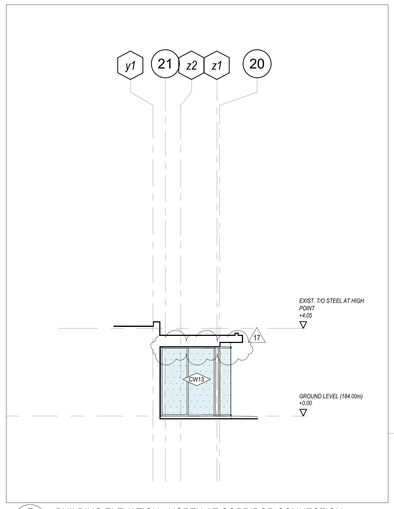

7 A3.02 BUILDING ELEVATION - NORTH AT CORRIDOR CONNECTION
1 : 100

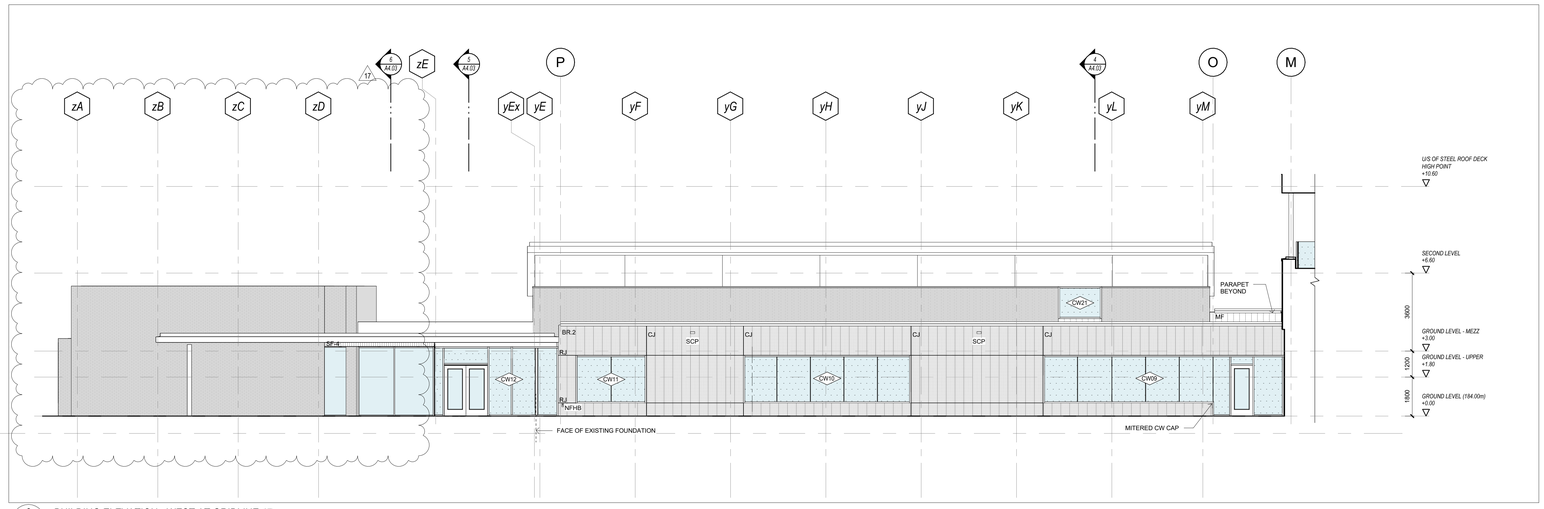

6 A3.02 BUILDING ELEVATION - WEST AT GRIDLINE 17
1 : 100

MATERIAL LEGEND

- BR.1 — ARCHITECTURAL MASONRY (BR.1) RED CLAY
- BR.2 — ARCHITECTURAL MASONRY (BR.2) GREY BLOCK
- BR.3 — ARCHITECTURAL MASONRY (BR.3) BLUE GLAZED
- SHADOW BOX (GL-1 + METAL SPANDREL) <METAL COLOUR TBD>
- CLEAR VISION GLASS (GL-1)
- CLEAR VISION GLASS WITH SURFACE PATTERN (GL-2)
- CAST-IN-PLACE CONCRETE
- MF — PREFINISHED METAL FLASHING <COLOUR TBD>
- PREFINISHED METAL PANEL <COLOUR TBD>
- EXISTING BUILDING BRICK
- WINDOWS PROTECTED BY ULC LISTED INTERIOR SPRINKLER SYSTEM
- ROOF SCREEN PREFINISHED PERFORATED METAL <COLOUR TBD>

CJ - CONTROL JOINT
RJ - REVEAL JOINT (RAKED)

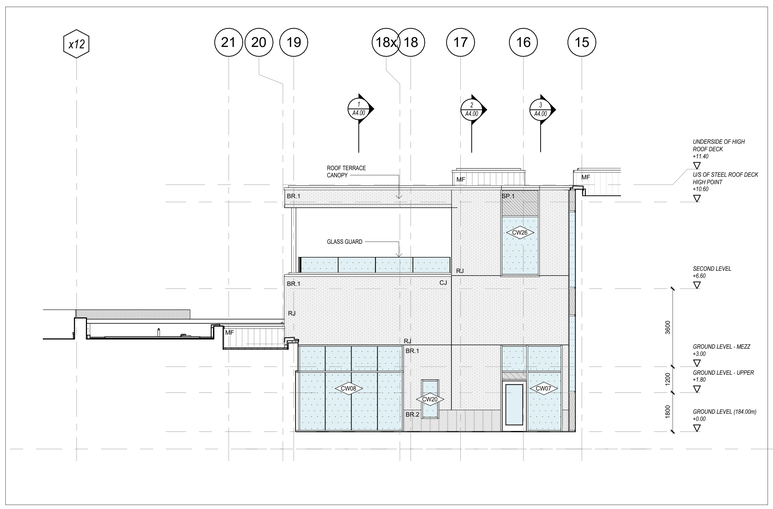

5 A3.02 BUILDING ELEVATION - NORTH
1 : 100

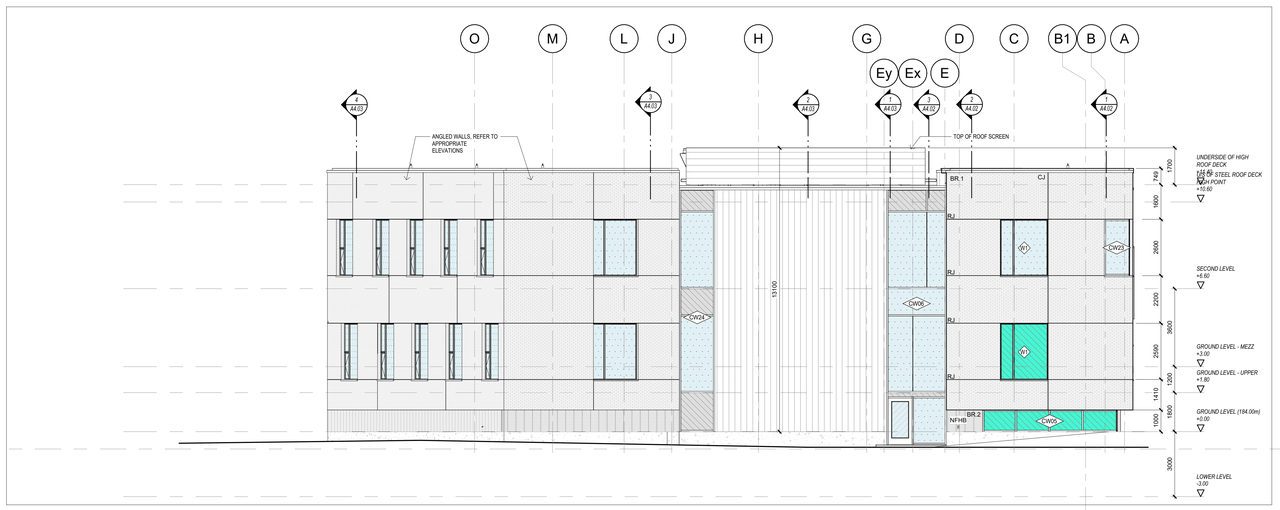

4 A3.02 BUILDING ELEVATION - WEST
1 : 100

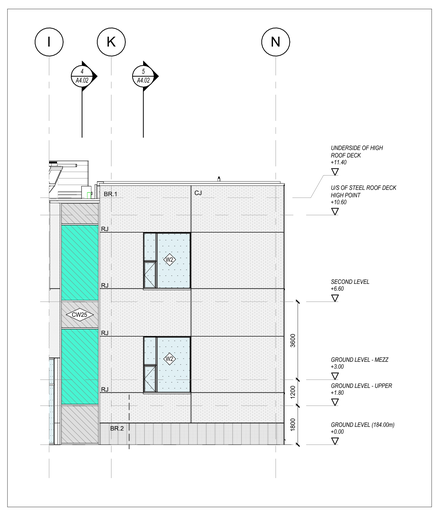

3 A3.02 BUILDING ELEVATION - NORTH EAST
1 : 100

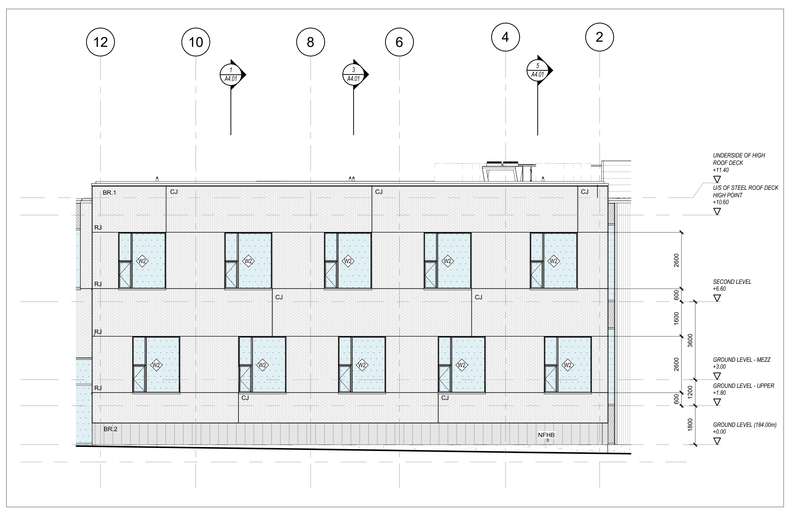

2 A3.02 BUILDING ELEVATION - NORTH WEST
1 : 100

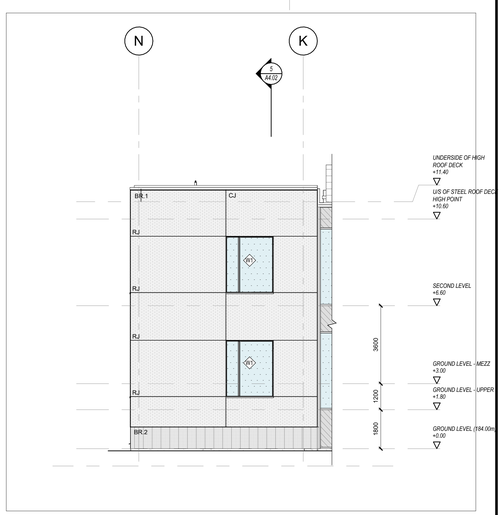

1 A3.02 BUILDING ELEVATION - NORTH WEST
1 : 100

Key to Detail Location

NO. — Detail Number
NO. — Drawing Number

If this sheet is not 46 7/8" x 33 1/8" (1189 x 841 mm) it is a reduced print - Read dwg. accordingly.

Contractors must check and verify all dimensions on the job and report any discrepancies to the Architect before proceeding with the work.

All prints and specifications are the property of the Architect and must be returned at the completion of the work.

Drawings should not be scaled.

No	Date	Revision/Issued
2	2024 06 27	RE-ISSUED FOR ZBA RESUBMISSION
3	2024 09 19	RE-ISSUED FOR ZBA RESUBMISSION
4	2024 12 17	DRAFT SPA FOR CLIENT REVIEW
5	2025 04 08	100% DESIGN DEVELOPMENT FOR CLIENT
6	2025 06 02	ISSUED FOR SPA
7	2025 09 15	ISSUED FOR SPA RESUBMISSION
8	2025 11 05	15% CD FOR CLIENT REVIEW
9	2025 12 15	30% CD FOR CLIENT REVIEW
10	2026 03 13	ISSUED FOR PERMIT
11	2026 04 10	75% CD FOR CLIENT REVIEW
14	2026 05 15	90% CD FOR CLIENT REVIEW
15	2026 07 08	ISSUED FOR TENDER
16	2026 07 17	ISSUED FOR ADDENDA 1
17	2026 07 27	ISSUED FOR ADDENDA 3

consultants

architect — CS&P Architects Inc.
2345 Yonge St., Suite 200
Toronto, ON, M4P 2E5
Phone.416.482.5002
Fax.416.482.5040

civil engineer — SCS Consulting Group Ltd.
30 Centurian Drive, Suite 100
Markham, ON, L3R 8B8
Phone.905.475.1900
Fax.905.475.8335

structural engineer — LEA Consulting Ltd.
40 University Ave, Suite 503
Toronto, ON, M5J 1T1
Phone.905.470.0015

mechanical engineer — Smith + Andersen
4211 Yonge Street
Toronto, ON, M2P 2A9
Phone.416.487.8151

electrical engineer — Smith + Andersen
4211 Yonge Street
Toronto, ON, M2P 2A9
Phone.416.487.8151

landscape architect — Quinn Design Associates Inc.
180 John Street
Toronto, ON, M5T 1X5
Phone.416.962.8700

PROJECT NORTH

SHS CS&P Architects

THE STERLING HALL SCHOOL

99 Cartwright Avenue, Toronto, ON M6A 1V4

EXTERIOR ELEVATIONS

scale:	1 : 100
date:	06/19/24
drawn:	CS&P
checked by:	CA
project number:	21032
drawing number:	A3.02
Revision:	17

A0

FILENAME: Autodesk Docs://21032 Sterling Hall/21032_SHS-A-MAIN-25.rvt

DRAWING LAST EDITED: 2026-07-27 4:46:21 PM

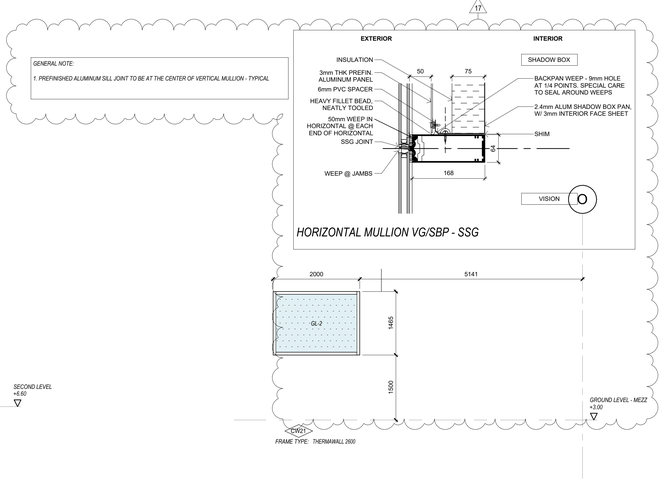

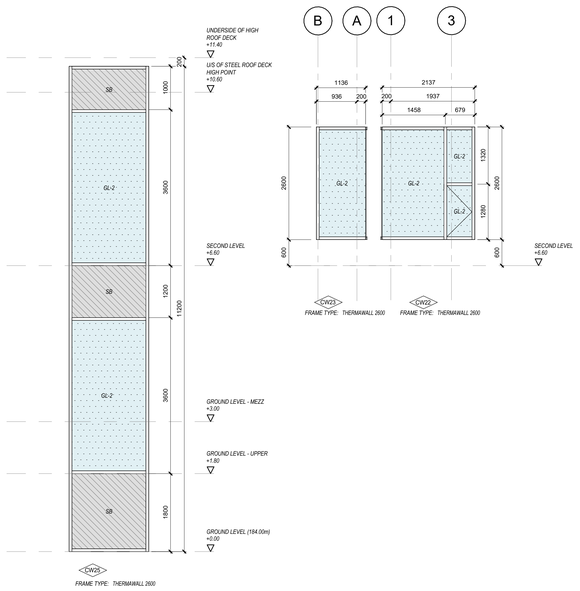

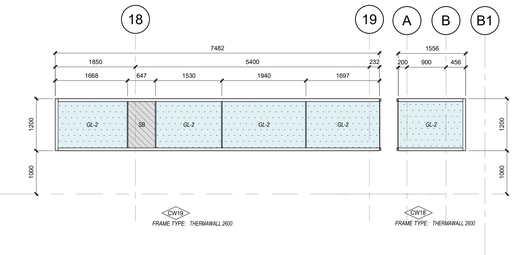

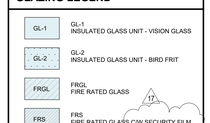

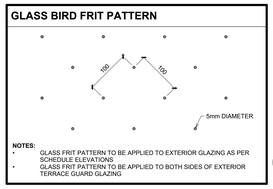

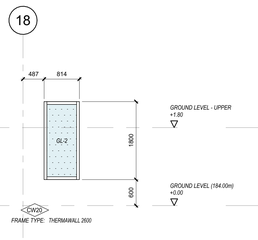

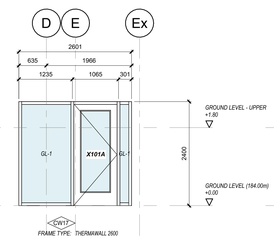

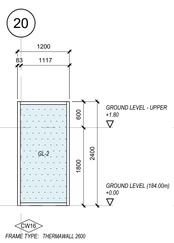

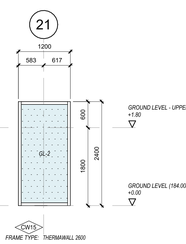

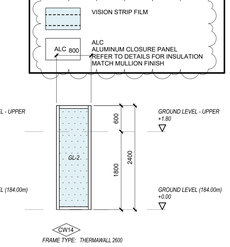

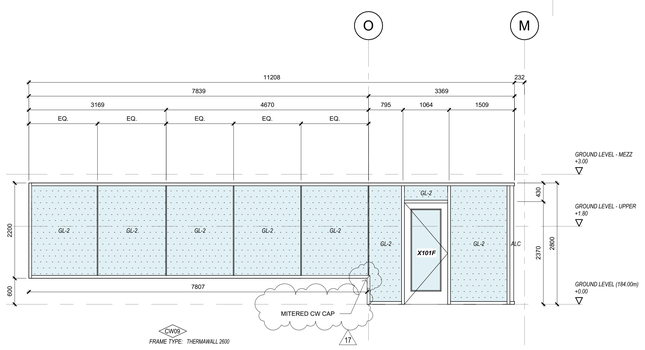

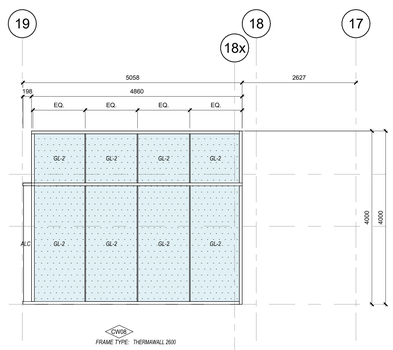

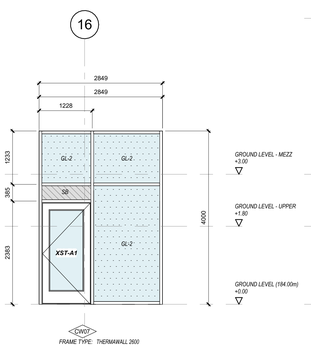

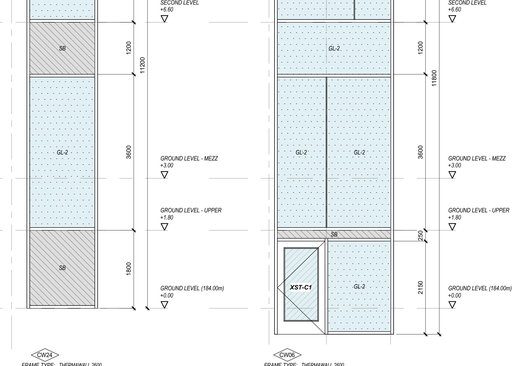

CURTAIN WALL ELEVATIONS

Key to Detail Location

NO. / NO. — Detail Number / Drawing Number

If this sheet is not 46.7/8" x 33 1/8" (1189 x 841 mm) it is a reduced print - Read dwg. accordingly.

Contractors must check and verify all dimensions on the job and report any discrepancies to the Architect before proceeding with the work.

All prints and specifications are the property of the Architect and must be returned at the completion of the work.

Drawings should not be scaled.

No	Date	Revision/Issued
14	2026 05 15	90% CD FOR CLIENT REVIEW
15	2026 07 08	ISSUED FOR TENDER
17	2026 07 27	ISSUED FOR ADDENDA 3

consultants

architect — CS&P Architects Inc., 2345 Yonge St., Suite 200, Toronto, ON, M4P 2E5, Phone.416.482.5002, Fax.416.482.5040

civil engineer — SCS Consulting Group Ltd., 30 Centurian Drive, Suite 100, Markham, ON, L3R 8B8, Phone.905.475.1900, Fax.905.475.8335

structural engineer — LEA Consulting Ltd., 40 University Ave, Suite 503, Toronto, ON, M5J 1T1, Phone.905.470.0015

mechanical engineer — Smith + Andersen, 4211 Yonge Street, Toronto, ON, M2P 2A9, Phone.416.487.8151

electrical engineer — Smith + Andersen, 4211 Yonge Street, Toronto, ON, M2P 2A9, Phone.416.487.8151

landscape architect — Quinn Design Associates Inc., 160 John Street, Toronto, ON, M5T 1X5, Phone.416.962.8700

PROJECT NORTH

SHS CS&P Architects

THE STERLING HALL SCHOOL

99 Cartwright Avenue, Toronto, ON M6A 1V4

CURTAIN WALL ELEVATIONS

scale:	As indicated
date:	10/16/20
drawn:	CS&P
checked by:	CA
project number:	21032
drawing number:	A3.10
Revision:	17

A0

FILENAME: Autodesk Docs://21032 Sterling Hall/21032_SHS-A-MAIN-25.rvt

DRAWING LAST EDITED: 2026-07-27 4:46:31 PM

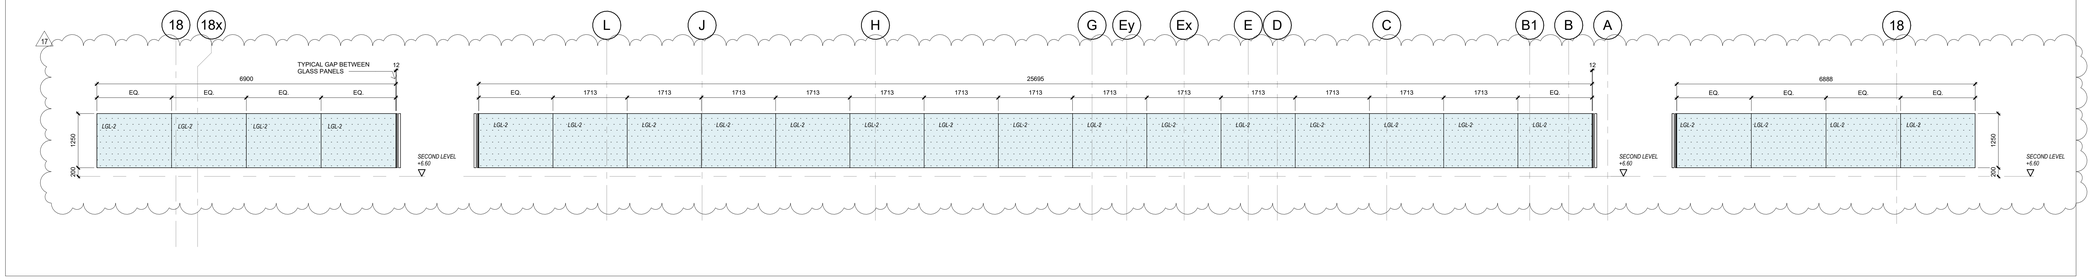

EXTERIOR GLASS GUARD ON ROOF TERRACE

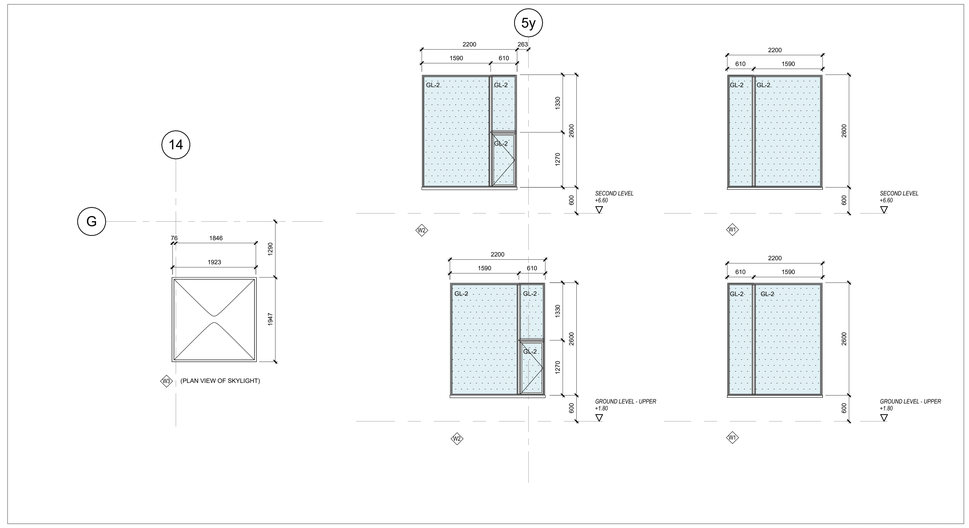

WINDOW ELEVATIONS

GLASS BIRD FRIT PATTERN

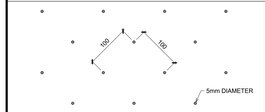

NOTES:

- GLASS FRIT PATTERN TO BE APPLIED TO EXTERIOR GLAZING AS PER SCHEDULE ELEVATIONS
- GLASS FRIT PATTERN TO BE APPLIED TO BOTH SIDES OF EXTERIOR TERRACE GUARD GLAZING

GLAZING LEGEND

- GL-1 — INSULATED GLASS UNIT - VISION GLASS
- GL-2 — INSULATED GLASS UNIT - BIRD FRIT
- FRGL — FIRE RATED GLASS
- FRS — FIRE RATED GLASS C/W SECURITY FILM
- FRNT — FIRE RATED SAFETY GLASS
- LGL-1 — LAMINATED GLASS
- LGL-2 — LAMINATED GLASS - BIRD FRIT
- TGL — TEMPERED GLASS
- SB — SHADOW BOX GL-2 AND METAL SPANDREL PANEL
- SGL — INSULATED SPANDREL PANEL
- CAPPED MULLION
- SSG — SILICONE STRUCTURAL GLAZED MULLION
- SILICONE JOINT (NON-STRUCTURAL)
- OPERABLE WINDOW/GLAZING UNIT
- VISION STRIP FILM
- ALC — ALUMINUM CLOSURE PANEL REFER TO DETAILS FOR INSULATION MATCH MULLION FINISH

CURTAIN WALL ELEVATIONS CONTINUED

Key to Detail Location

NO. — Detail Number
NO. — Drawing Number

If this sheet is not 46 7/8" x 33 1/8" (1189 x 841 mm) it is a reduced print - Read dwg. accordingly.

Contractors must check and verify all dimensions on the job and report any discrepancies to the Architect before proceeding with the work.

All prints and specifications are the property of the Architect and must be returned at the completion of the work.

Drawings should not be scaled.

No	Date	Revision/Issued
14	2026 05 15	90% CD FOR CLIENT REVIEW
15	2026 07 08	ISSUED FOR TENDER
16	2026 07 17	ISSUED FOR ADDENDA 1
17	2026 07 27	ISSUED FOR ADDENDA 3

consultants

architect — CS&P Architects Inc.
2345 Yonge St., Suite 200
Toronto, ON, M4P 2E5
Phone.416.482.5002
Fax.416.482.5040

civil engineer — SCS Consulting Group Ltd.
30 Centurian Drive, Suite 100
Markham, ON, L3R 8B8
Phone.905.475.1900
Fax.905.475.8335

structural engineer — LEA Consulting Ltd.
40 University Ave, Suite 503
Toronto, ON, M5J 1T1
Phone.905.470.0015

mechanical engineer — Smith + Andersen
4211 Yonge Street
Toronto, ON, M2P 2A9
Phone.416.487.8151

electrical engineer — Smith + Andersen
4211 Yonge Street
Toronto, ON, M2P 2A9
Phone.416.487.8151

landscape architect — Quinn Design Associates Inc.
160 John Street
Toronto, ON, M5T 1X5
Phone.416.962.8700

PROJECT NORTH

CS&P Architects

THE STERLING HALL SCHOOL

99 Cartwright Avenue, Toronto, ON M6A 1V4

CURTAIN WALL AND WINDOW ELEVATIONS

scale:	As indicated
date:	03/31/26
drawn:	CS&P
checked by:	CA
project number:	21032
drawing number:	A3.11
Revision:	17

A0

FILENAME: Autodesk Docs://21032 Sterling Hall/21032_SHS-A-MAIN-25.rvt

DRAWING LAST EDITED: 2026-07-27 4:46:37 PM

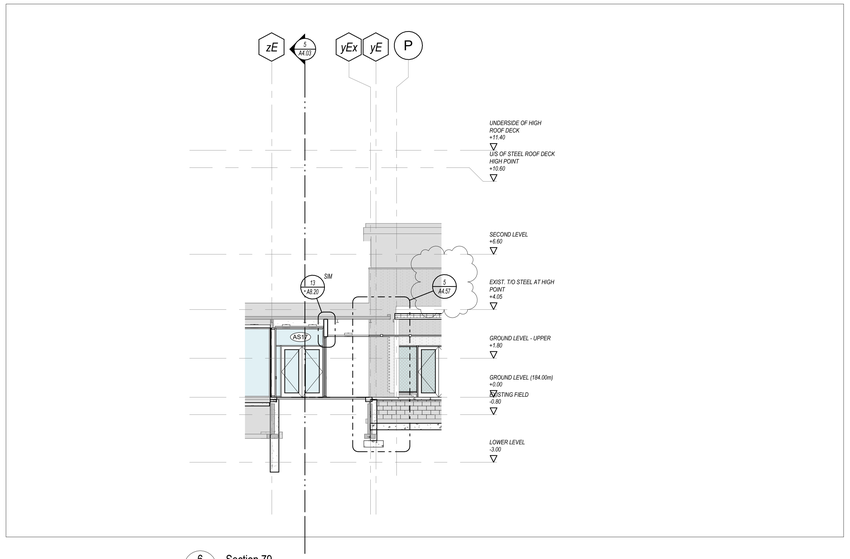

6 A4.02 Section 79
1 : 100

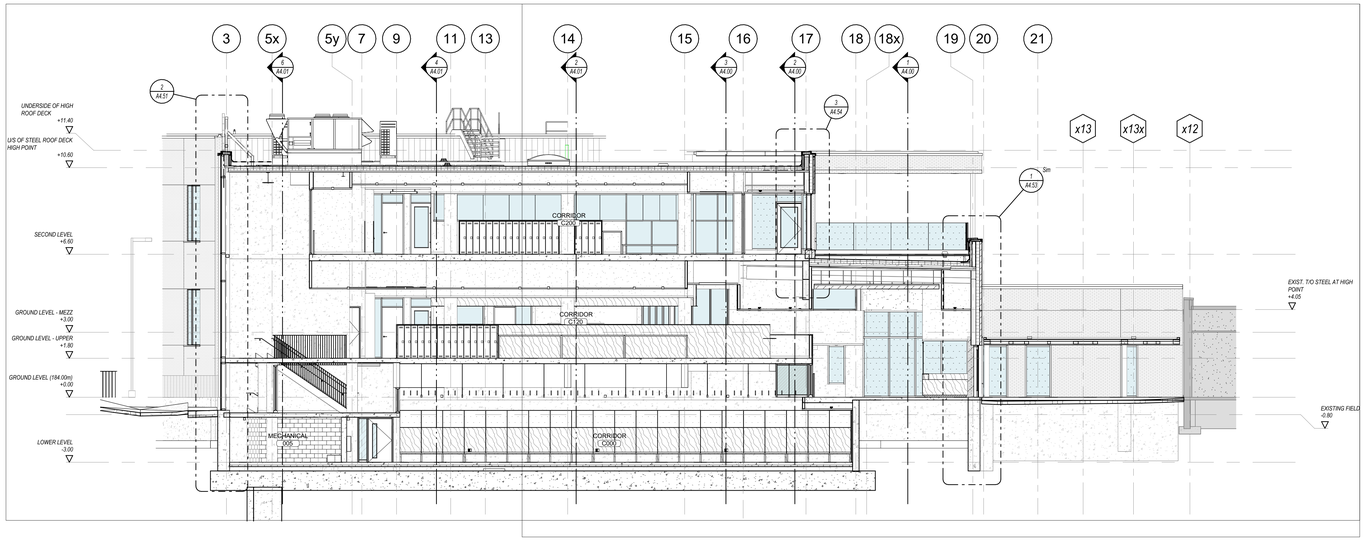

3 A4.02 BUILDING SECTION - LOOKING NORTH
1 : 100

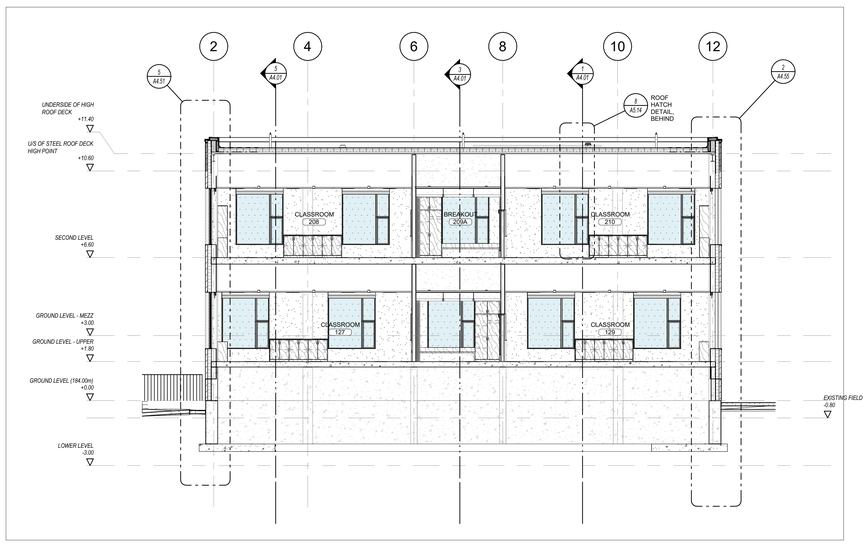

5 A4.02 BUILDING SECTION - LOOKING NORTH-WEST
1 : 100

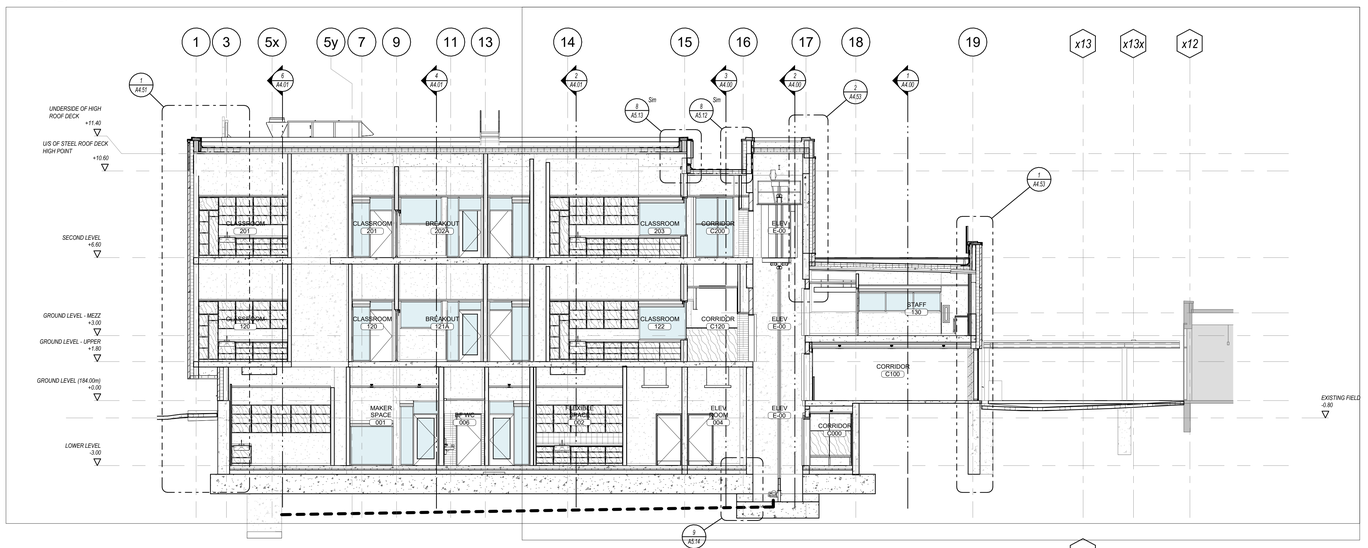

2 A4.02 BUILDING SECTION - LOOKING NORTH
1 : 100

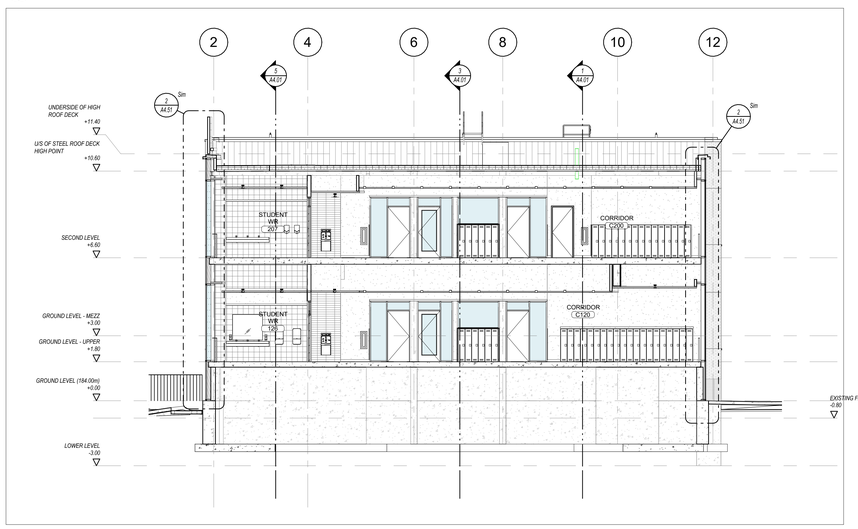

4 A4.02 BUILDING SECTION - LOOKING NORTH-WEST
1 : 100

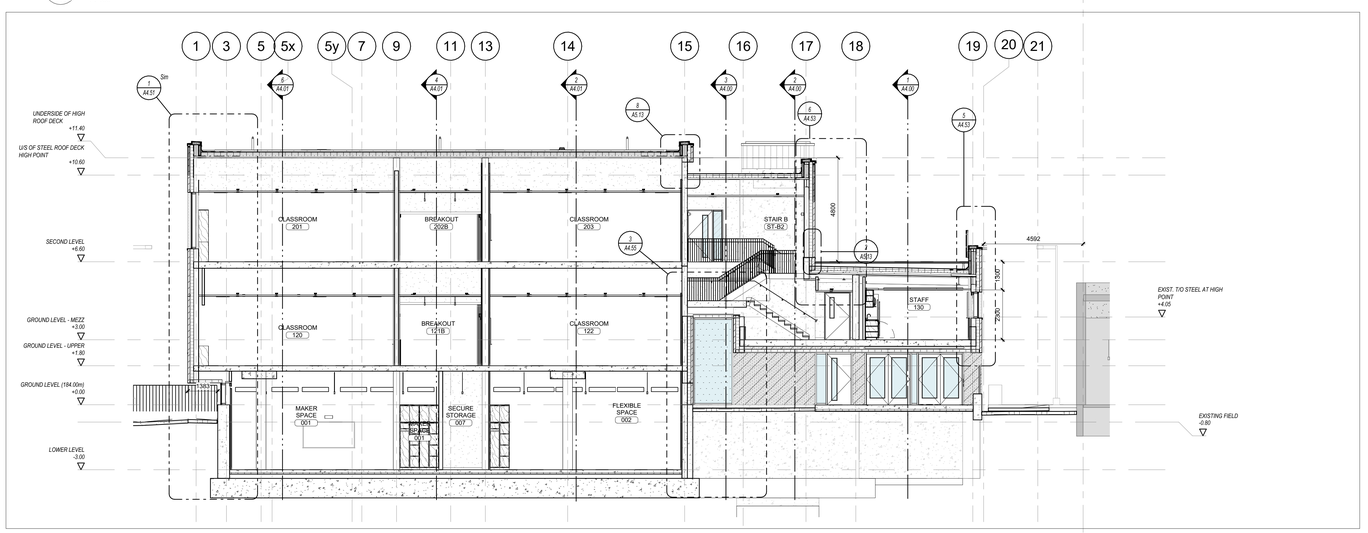

1 A4.02 BUILDING SECTION - LOOKING NORTH
1 : 100

Key to Detail Location

NO. Detail Number
NO. Drawing Number

If this sheet is not 46 7/8" x 33 1/8" (1189 x 841 mm) it is a reduced print - Read dwg. accordingly.

Contractors must check and verify all dimensions on the job and report any discrepancies to the Architect before proceeding with the work.

All prints and specifications are the property of the Architect and must be returned at the completion of the work.

Drawings should not be scaled.

No	Date	Revision/Issued
10	2026 03 13	ISSUED FOR PERMIT
11	2026 04 10	75% CD FOR CLIENT REVIEW
14	2026 05 15	90% CD FOR CLIENT REVIEW
15	2026 07 08	ISSUED FOR TENDER
17	2026 07 27	ISSUED FOR ADDENDA 3

consultants

architect CS&P Architects Inc.
2345 Yonge St., Suite 200
Toronto, ON, M4P 2E5
Phone.416.482.5002
Fax.416.482.5040

civil engineer SCS Consulting Group Ltd.
30 Centurian Drive, Suite 100
Markham, ON, L3R 8B8
Phone.905.475.1900
Fax.905.475.8335

structural engineer LEA Consulting Ltd.
40 University Ave, Suite 503
Toronto, ON, M5J 1T1
Phone.905.470.0015

mechanical engineer Smith + Andersen
4211 Yonge Street
Toronto, ON, M2P 2A9
Phone.416.487.8151

electrical engineer Smith + Andersen
4211 Yonge Street
Toronto, ON, M2P 2A9
Phone.416.487.8151

landscape architect Quinn Design Associates Inc.
180 John Street
Toronto, ON, M5T 1X5
Phone.416.962.8700

PROJECT NORTH

SHS CS&P Architects

THE STERLING HALL SCHOOL

99 Cartwright Avenue, Toronto, ON M6A 1V4

BUILDING SECTIONS

scale:	1 : 100
date:	06/24/24
drawn:	CS&P
checked by:	CA
project number:	21032
drawing number:	A4.02
	Revision: 17

A0

FILENAME: Autodesk Docs://21032 Sterling Hall/21032_SHS-A-MAIN-25.rvt

DRAWING LAST EDITED: 2026-07-27 4:46:50 PM

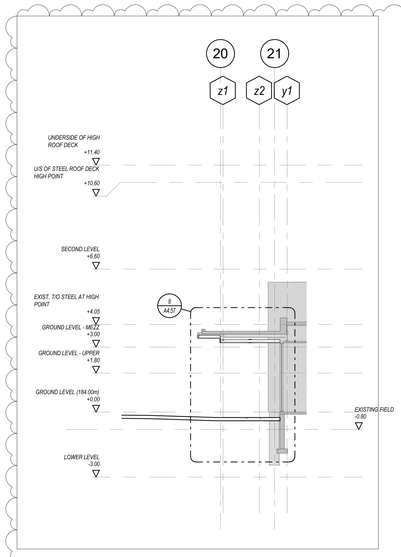

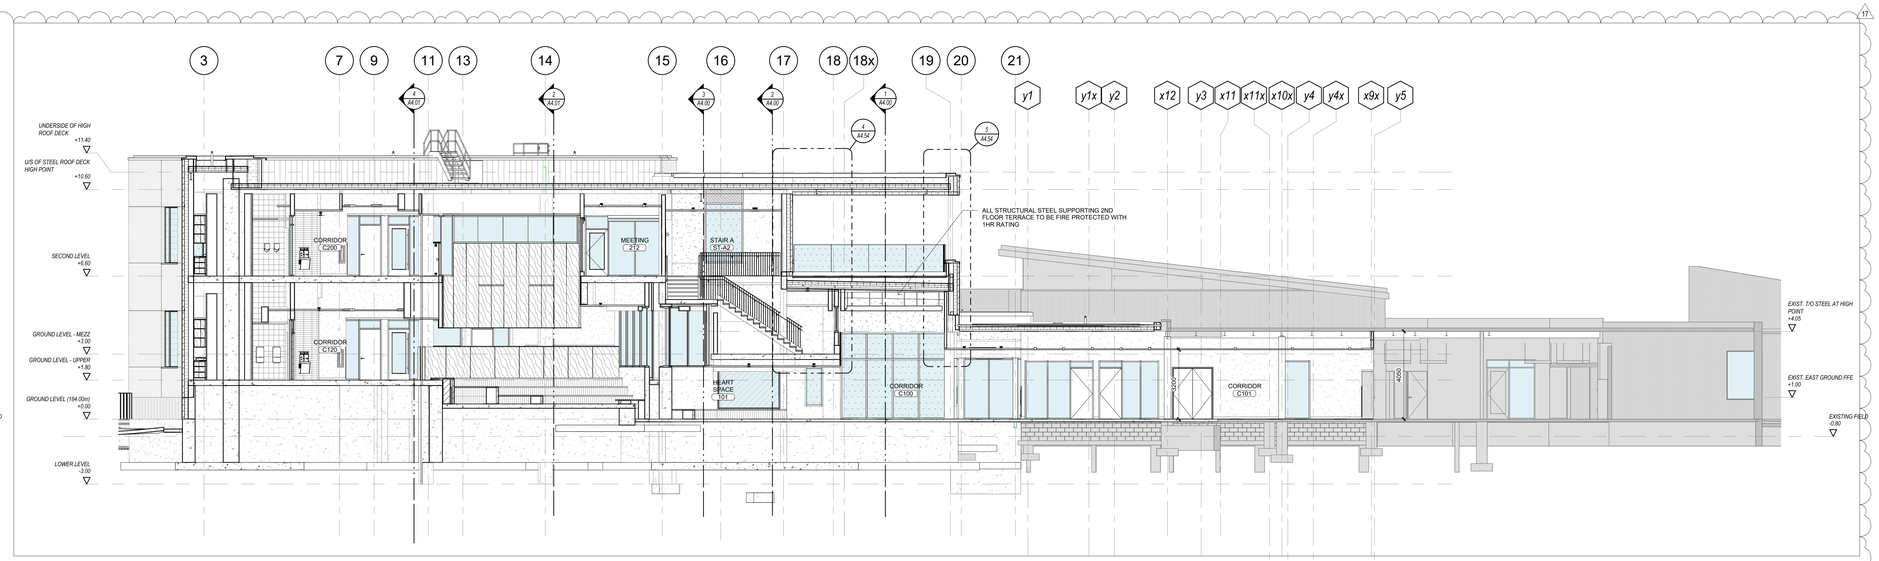

6 A4.03 BUILDING SECTION - LOOKING NORTH
1 : 100

3 A4.03 BUILDING SECTION - LOOKING NORTH
1 : 100

5 A4.03 BUILDING SECTION - LOOKING NORTH
1 : 100

2 A4.03 BUILDING SECTION - LOOKING NORTH
1 : 100

4 A4.03 BUILDING SECTION - LOOKING NORTH
1 : 100

1 A4.03 BUILDING SECTION - LOOKING NORTH
1 : 100

Key to Detail Location

NO. Detail Number
NO. Drawing Number

If this sheet is not 46 7/8" x 33 1/8" (1189 x 841 mm) it is a reduced print - Read dwg. accordingly.

Contractors must check and verify all dimensions on the job and report any discrepancies to the Architect before proceeding with the work.

All prints and specifications are the property of the Architect and must be returned at the completion of the work.

Drawings should not be scaled.

No	Date	Revision/Issued
10	2026 03 13	ISSUED FOR PERMIT
11	2026 04 10	75% CD FOR CLIENT REVIEW
14	2026 05 15	90% CD FOR CLIENT REVIEW
15	2026 07 08	ISSUED FOR TENDER
17	2026 07 27	ISSUED FOR ADDENDA 3

consultants

architect
CS&P Architects Inc.
2345 Yonge St., Suite 200
Toronto, ON, M4P 2E5
Phone.416.482.5002
Fax.416.482.5040

civil engineer
SCS Consulting Group Ltd.
30 Centurian Drive, Suite 100
Markham, ON, L3R 8B8
Phone.905.475.1900
Fax.905.475.8335

structural engineer
LEA Consulting Ltd.
40 University Ave, Suite 503
Toronto, ON, M5J 1T1
Phone.905.470.0015

mechanical engineer
Smith + Andersen
4211 Yonge Street
Toronto, ON, M2P 2A9
Phone.416.487.8151

electrical engineer
Smith + Andersen
4211 Yonge Street
Toronto, ON, M2P 2A9
Phone.416.487.8151

landscape architect
Quinn Design Associates Inc.
160 John Street
Toronto, ON, M5T 1X5
Phone.416.962.8700

PROJECT NORTH

SHS CS&P Architects

THE STERLING HALL SCHOOL

99 Cartwright Avenue, Toronto, ON M6A 1V4

BUILDING SECTIONS

scale:	1 : 100
date:	06/24/24
drawn:	CS&P
checked by:	CA
project number:	21032
drawing number:	A4.03
Revision:	17

A0

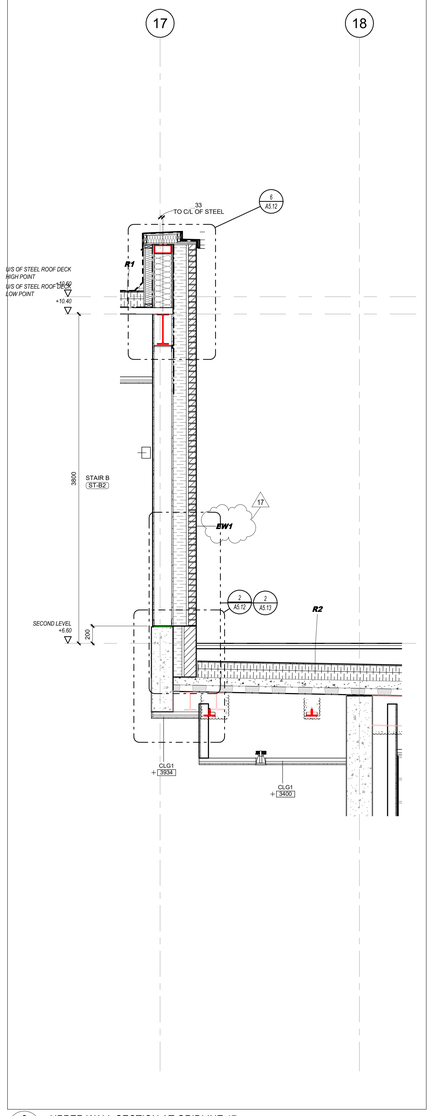

6 A4.53 UPPER WALL SECTION AT GRIDLINE 17
1 : 25

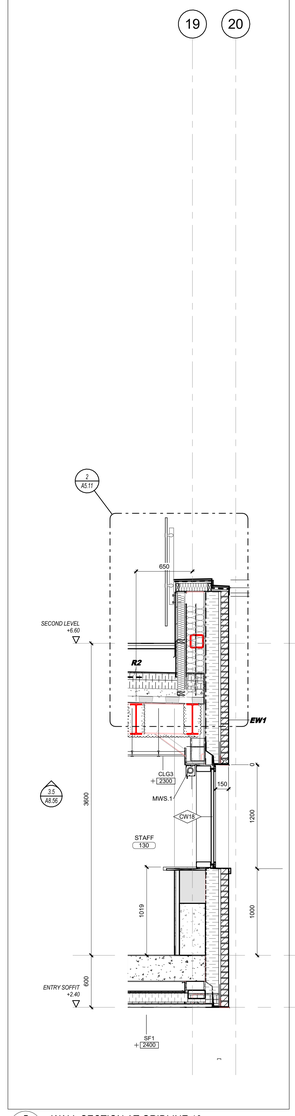

5 A4.53 WALL SECTION AT GRIDLINE 19
1 : 25

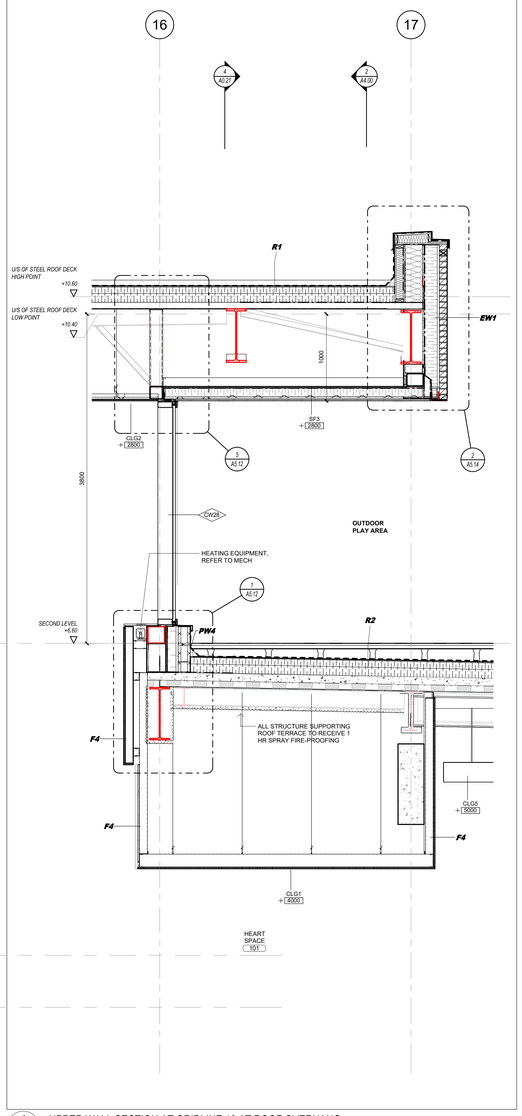

4 A4.53 UPPER WALL SECTION AT GRIDLINE 16 AT ROOF OVERHANG
1 : 25

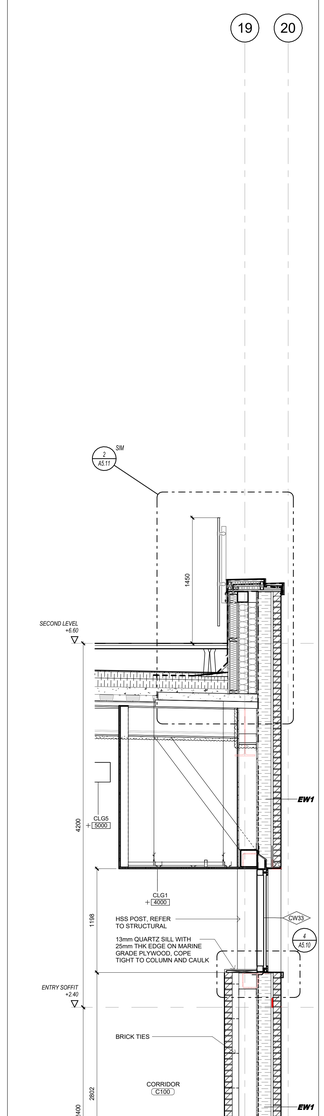

3 A4.53 WALL SECTION AT GRIDLINE 19
1 : 25

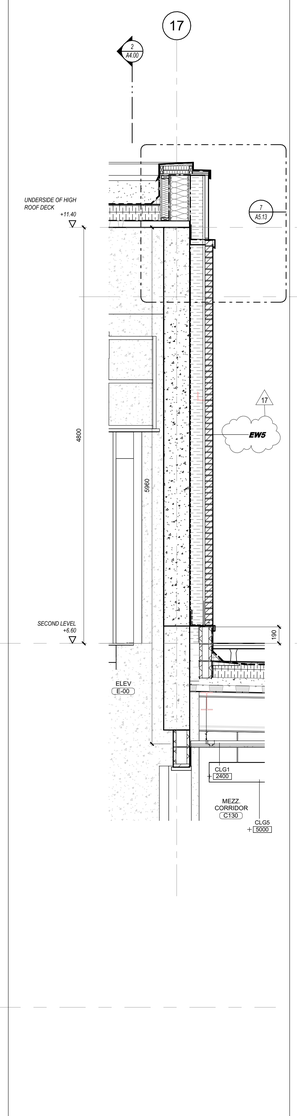

2 A4.53 UPPER WALL SECTION AT GRIDLINE 17 AT ELEVATOR
1 : 25

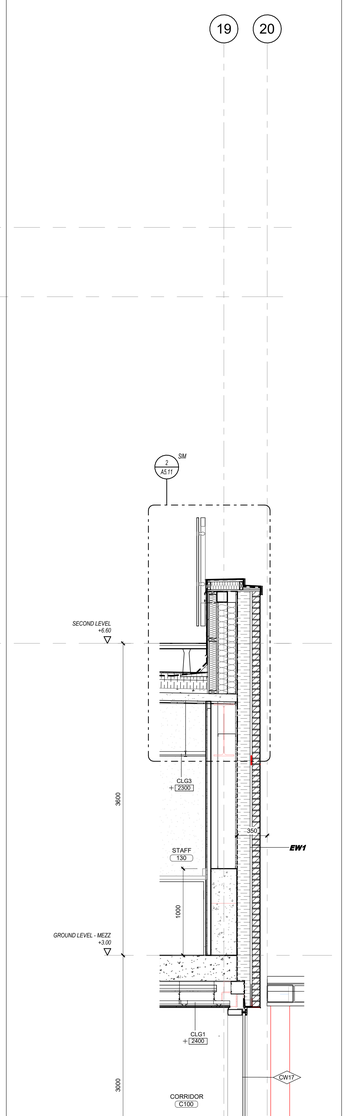

1 A4.53 WALL SECTION AT GRIDLINE 19
1 : 25

Key to Detail Location

NO. — Detail Number
NO. — Drawing Number

If this sheet is not 46 7/8" x 33 1/8" (1189 x 841 mm) it is a reduced print - Read dwg. accordingly.

Contractors must check and verify all dimensions on the job and report any discrepancies to the Architect before proceeding with the work.

All prints and specifications are the property of the Architect and must be returned at the completion of the work.

Drawings should not be scaled.

No	Date	Revision/Issued
11	2026 04 10	75% CD FOR CLIENT REVIEW
14	2026 05 15	90% CD FOR CLIENT REVIEW
15	2026 07 08	ISSUED FOR TENDER
17	2026 07 27	ISSUED FOR ADDENDA 3

consultants

architect — CS&P Architects Inc.
2345 Yonge St., Suite 200
Toronto, ON, M4P 2E5
Phone.416.482.5002
Fax.416.482.5040

civil engineer — SCS Consulting Group Ltd.
30 Centurian Drive, Suite 100
Markham, ON, L3R 8B8
Phone.905.475.1900
Fax.905.475.8335

structural engineer — LEA Consulting Ltd.
40 University Ave, Suite 503
Toronto, ON, M5J 1T1
Phone.905.470.0015

mechanical engineer — Smith + Andersen
4211 Yonge Street
Toronto, ON, M2P 2A9
Phone.416.487.8151

electrical engineer — Smith + Andersen
4211 Yonge Street
Toronto, ON, M2P 2A9
Phone.416.487.8151

landscape architect — Quinn Design Associates Inc.
160 John Street
Toronto, ON, M5T 1X5
Phone.416.962.8700

SHS CS&P Architects

THE STERLING HALL SCHOOL

99 Cartwright Avenue, Toronto, ON M6A 1V4

WALL SECTIONS

scale:	1 : 25
date:	01/15/26
drawn:	CS&P
checked by:	CA
project number:	21032
drawing number:	A4.53
	Revision: 17

A0

FILENAME: Autodesk Docs://21032 Sterling Hall/21032_SHS-A-MAIN-25.rvt

DRAWING LAST EDITED: 2026-07-27 4:47:11 PM

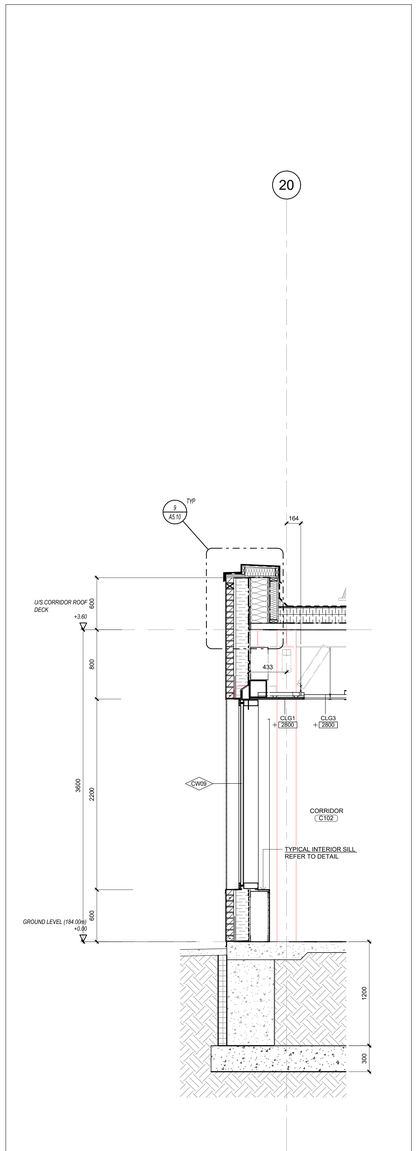

5 A4.56 WALL SECTION AT GRIDLINE 20 NEW CORRIDOR ENVELOPE

1 : 25

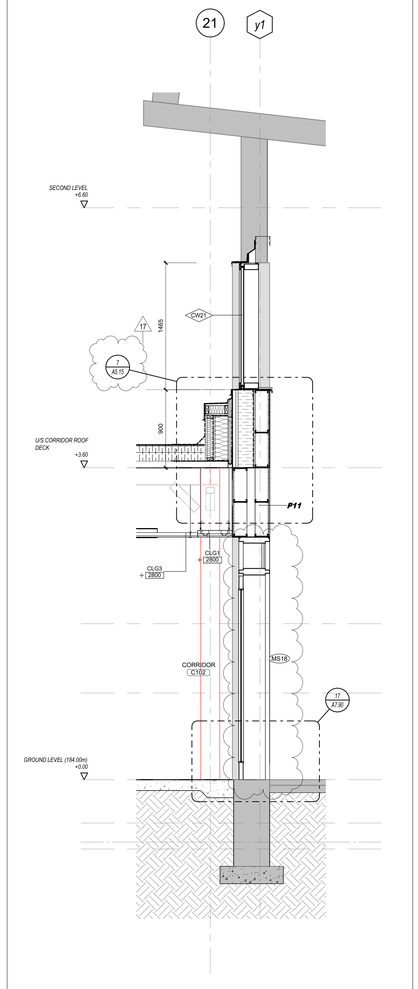

4 A4.56 WALL SECTION AT GRIDLINE 21 NEW CORRIDOR AT EXISTING GYM

1 : 25

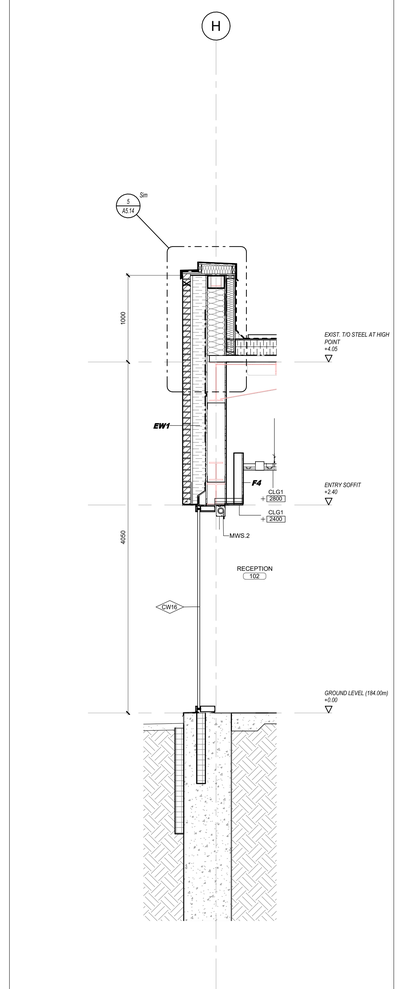

3 A4.56 WALL SECTION AT H AT SOUTH ENVELOPE - CURTAIN WALL

1 : 25

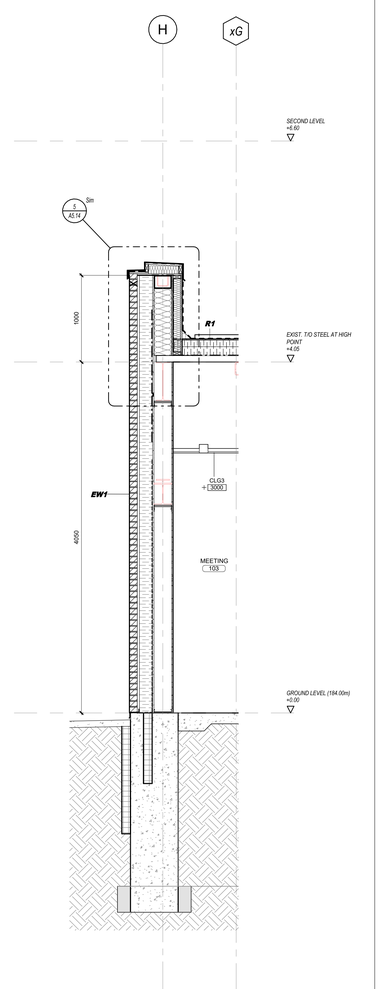

2 A4.56 WALL SECTION AT H AT SOUTH ENVELOPE

1 : 25

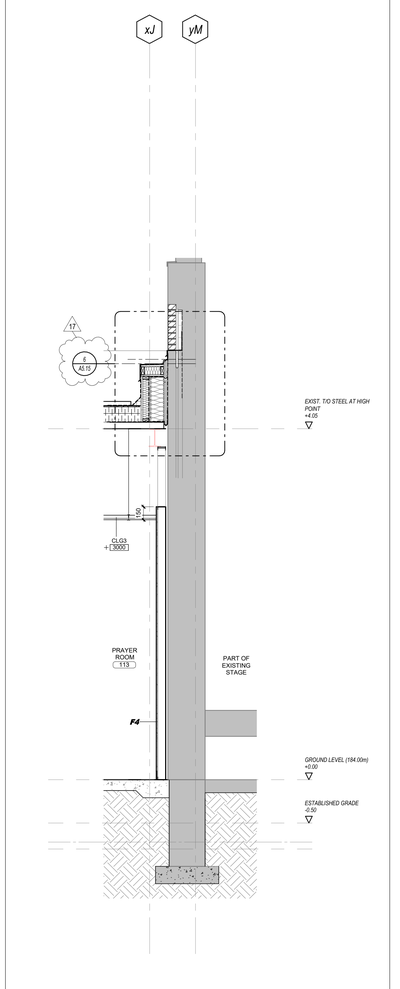

1 A4.56 WALL SECTION AT EXISTING SOUTH END OF GYM

1 : 25

Key to Detail Location

NO.
NO.

Detail Number
Drawing Number

If this sheet is not 46 7/8" x 33 1/8" (1189 x 841 mm) it is a reduced print - Read dwg. accordingly.

Contractors must check and verify all dimensions on the job and report any discrepancies to the Architect before proceeding with the work.

All prints and specifications are the property of the Architect and must be returned at the completion of the work.

Drawings should not be scaled.

No	Date	Revision/Issued
11	2026 04 10	75% CD FOR CLIENT REVIEW
14	2026 05 15	90% CD FOR CLIENT REVIEW
15	2026 07 08	ISSUED FOR TENDER
16	2026 07 17	ISSUED FOR ADDENDA 1
17	2026 07 27	ISSUED FOR ADDENDA 3

consultants

architect
CS&P Architects Inc.
2345 Yonge St., Suite 200
Toronto, ON, M4P 2E5
Phone.416.482.5002
Fax.416.482.5040

civil engineer
SCS Consulting Group Ltd.
30 Centurian Drive, Suite 100
Markham, ON, L3R 8B8
Phone.905.475.1900
Fax.905.475.8335

structural engineer
LEA Consulting Ltd.
40 University Ave, Suite 503
Toronto, ON, M5J 1T1
Phone.905.470.0015

mechanical engineer
Smith + Andersen
4211 Yonge Street
Toronto, ON, M2P 2A9
Phone.416.487.8151

electrical engineer
Smith + Andersen
4211 Yonge Street
Toronto, ON, M2P 2A9
Phone.416.487.8151

landscape architect
Quinn Design Associates Inc.
180 John Street
Toronto, ON, M5T 1X5
Phone.416.962.8700

SHS
CS&P Architects

THE STERLING HALL SCHOOL

99 Cartwright Avenue, Toronto, ON M6A 1V4

WALL SECTIONS

scale:	1 : 25
date:	01/16/26
drawn:	CS&P
checked by:	CA
project number:	21032
drawing number:	A4.56
Revision:	17

A0

FILENAME: Autodesk Docs://21032 Sterling Hall/21032_SHS-A-MAIN-25.rvt

DRAWING LAST EDITED: 2026-07-27 4:47:14 PM

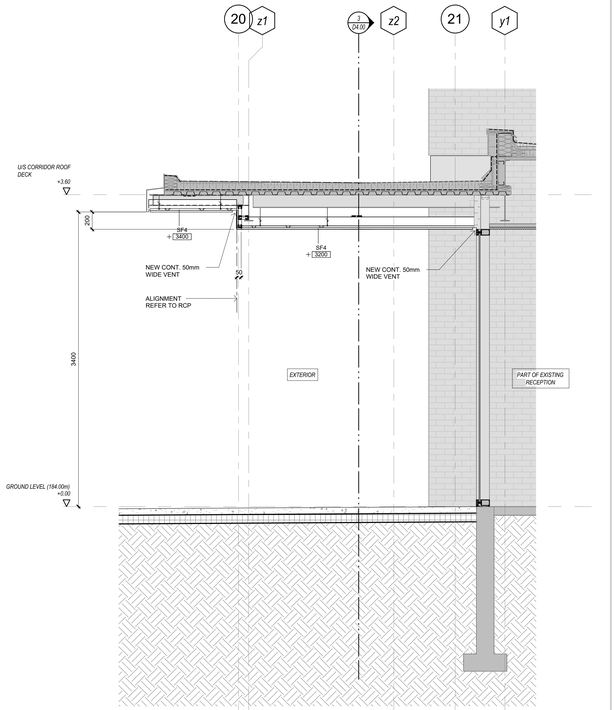

8 A4.57 WALL SECTION AT NORTH VESTIBULE SOFFIT
1 : 25

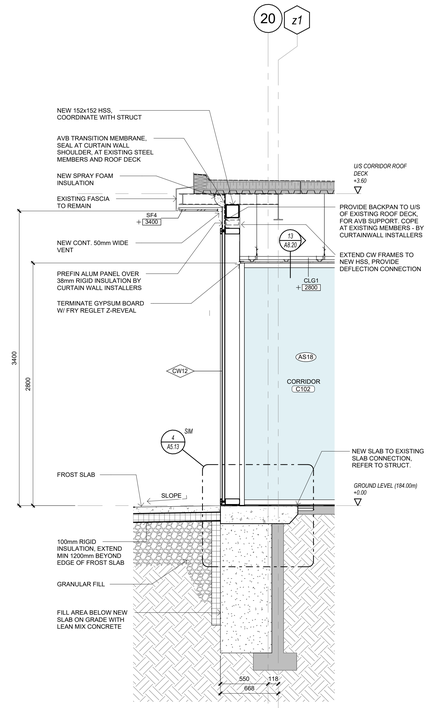

7 A4.57 WALL SECTION LOOKING NORTH AT GRD 20 and z1
1 : 25

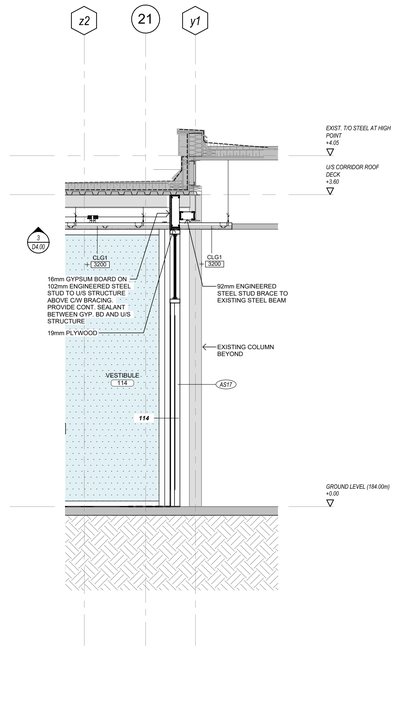

6 A4.57 WALL SECTION AT INTERIOR NORTH VESTIBULE
1 : 25

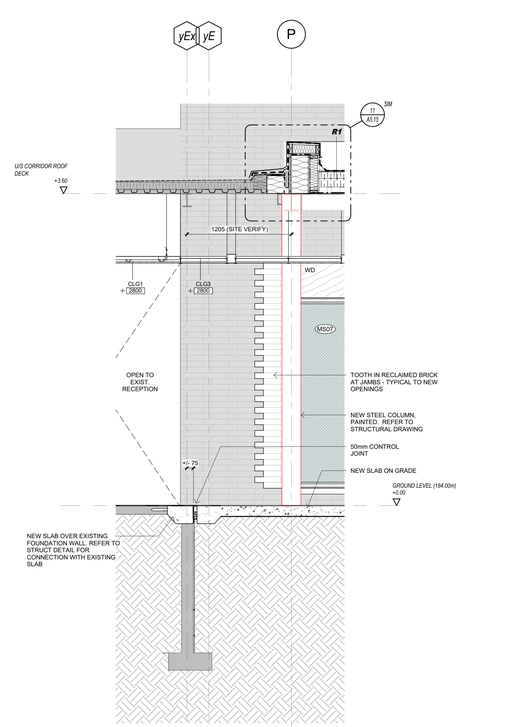

5 A4.57 WALL SECTION AT VESTIBULE CONNECTION TO NEW CORRIDOR
1 : 25

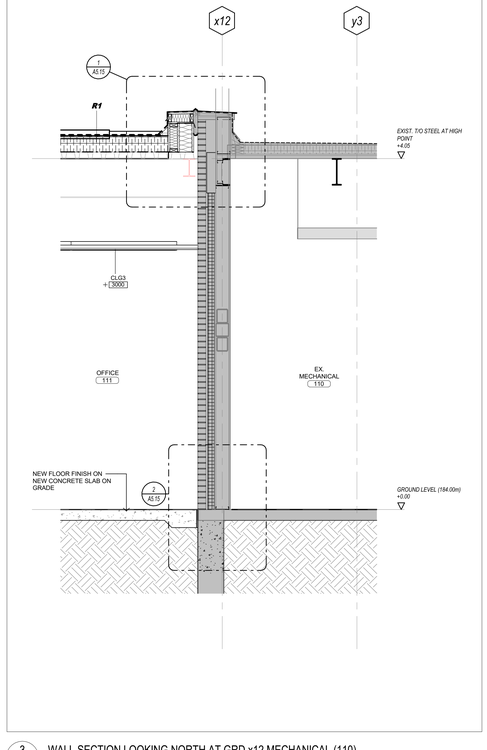

3 A4.57 WALL SECTION LOOKING NORTH AT GRD x12 MECHANICAL (110)
1 : 25

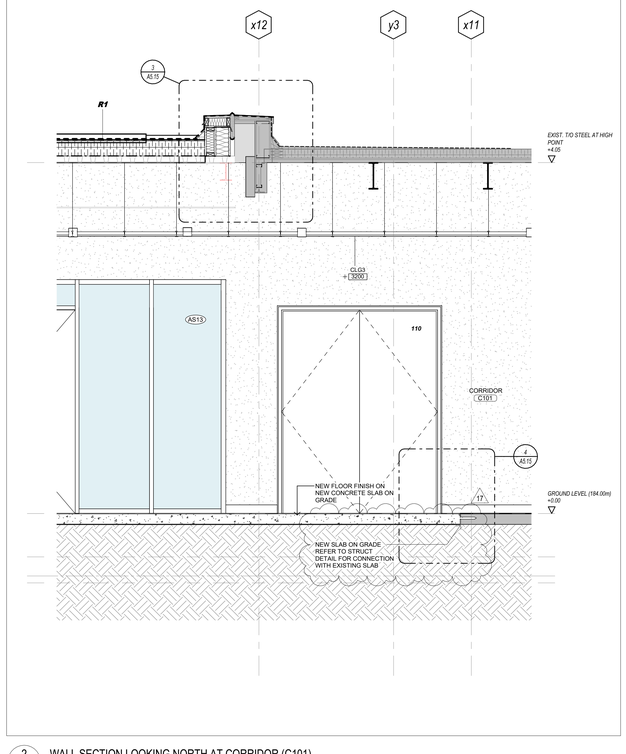

2 A4.57 WALL SECTION LOOKING NORTH AT CORRIDOR (C101)
1 : 25

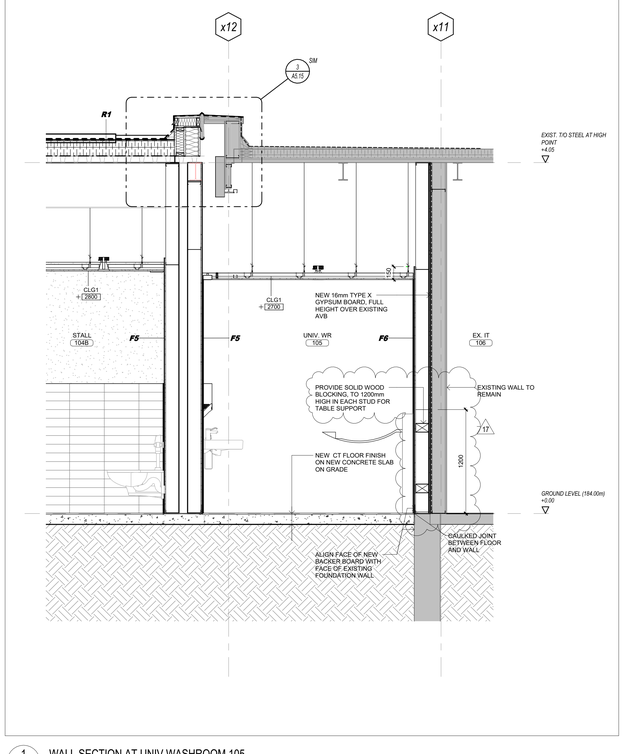

1 A4.57 WALL SECTION AT UNIV.WASHROOM 105
1 : 25

Key to Detail Location

NO. / NO. — Detail Number / Drawing Number

If this sheet is not 46 7/8" x 33 1/8" (1189 x 841 mm) it is a reduced print - Read dwg. accordingly.

Contractors must check and verify all dimensions on the job and report any discrepancies to the Architect before proceeding with the work.

All prints and specifications are the property of the Architect and must be returned at the completion of the work.

Drawings should not be scaled.

No	Date	Revision/Issued
11	2026 04 10	75% CD FOR CLIENT REVIEW
14	2026 05 15	90% CD FOR CLIENT REVIEW
15	2026 07 08	ISSUED FOR TENDER
16	2026 07 17	ISSUED FOR ADDENDA 1
17	2026 07 27	ISSUED FOR ADDENDA 3

consultants

architect — CS&P Architects Inc.
2345 Yonge St., Suite 200
Toronto, ON, M4P 2E5
Phone.416.482.5002
Fax.416.482.5040

civil engineer — SCS Consulting Group Ltd.
30 Centurian Drive, Suite 100
Markham, ON, L3R 8B8
Phone.905.475.1900
Fax.905.475.8335

structural engineer — LEA Consulting Ltd.
40 University Ave, Suite 503
Toronto, ON, M5J 1T1
Phone.905.470.0015

mechanical engineer — Smith + Andersen
4211 Yonge Street
Toronto, ON, M2P 2A9
Phone.416.487.8151

electrical engineer — Smith + Andersen
4211 Yonge Street
Toronto, ON, M2P 2A9
Phone.416.487.8151

landscape architect — Quinn Design Associates Inc.
180 John Street
Toronto, ON, M5T 1X5
Phone.416.962.8700

SHS CS&P Architects

THE STERLING HALL SCHOOL

99 Cartwright Avenue, Toronto, ON M6A 1V4

WALL SECTIONS

scale:	1 : 25
date:	01/16/26
drawn:	CS&P
checked by:	CA
project number:	21032
drawing number:	A4.57
Revision:	17

A0

FILENAME: Autodesk Docs://21032 Sterling Hall/21032_SHS-A-MAIN.25.rvt

DRAWING LAST EDITED: 2026-07-27 4:47:19 PM

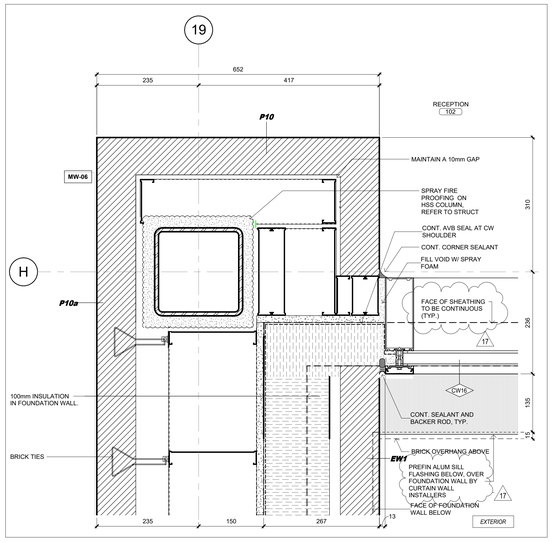

10 A5.00 EXT.PLAN DETAIL - GRID 19/H AT RECEPTION 102

1 : 5

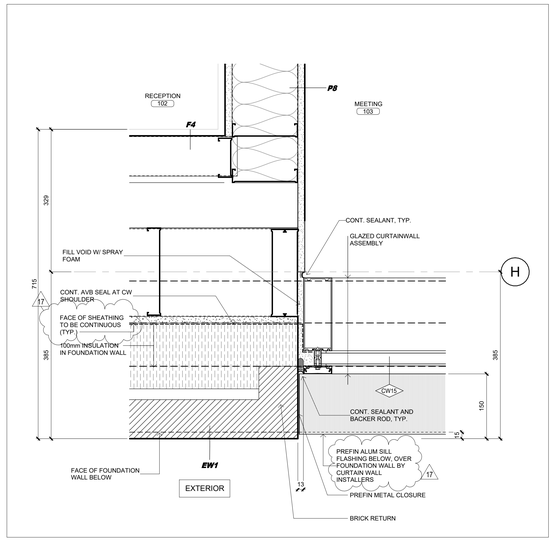

9 A5.00 EXT.PLAN DETAIL - CURTAINWALL DETAIL

1 : 5

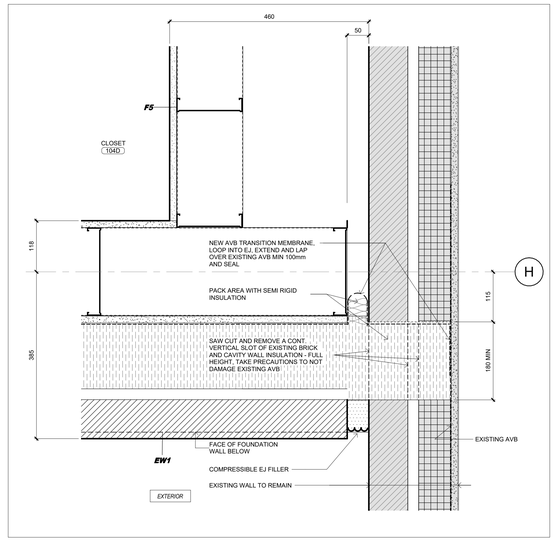

8 A5.00 EXT.PLAN DETAIL - GRID H AT EXISTING BRICK WALL

1 : 5

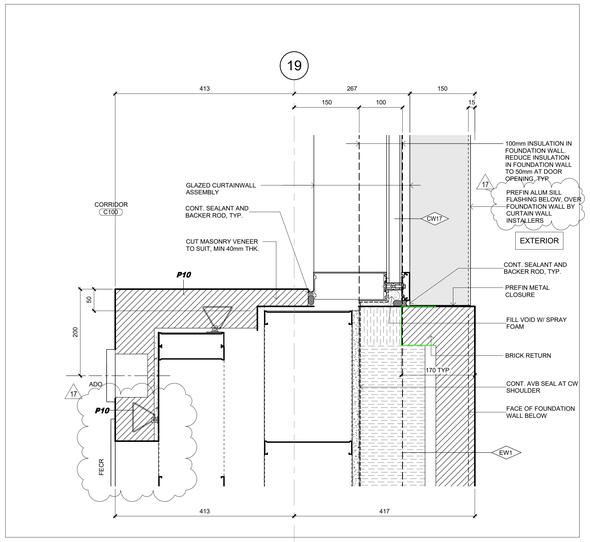

7 A5.00 EXT.PLAN DETAIL - GRID 19 AT CORRIDOR C100

1 : 5

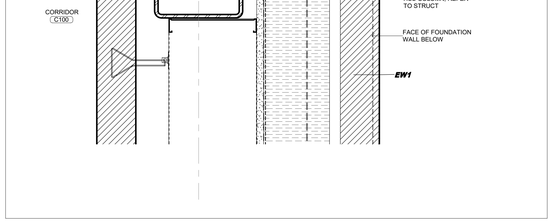

6 A5.00 EXT.PLAN DETAIL - GRID 19/GG AT GROUND LEVEL

1 : 5

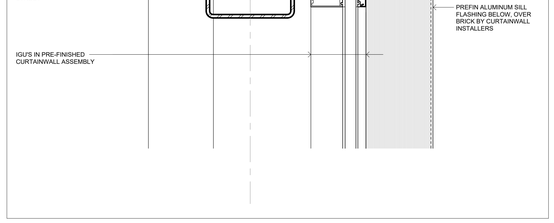

5 A5.00 EXT.PLAN DETAIL - GRID 19/GG AT CW33

1 : 5

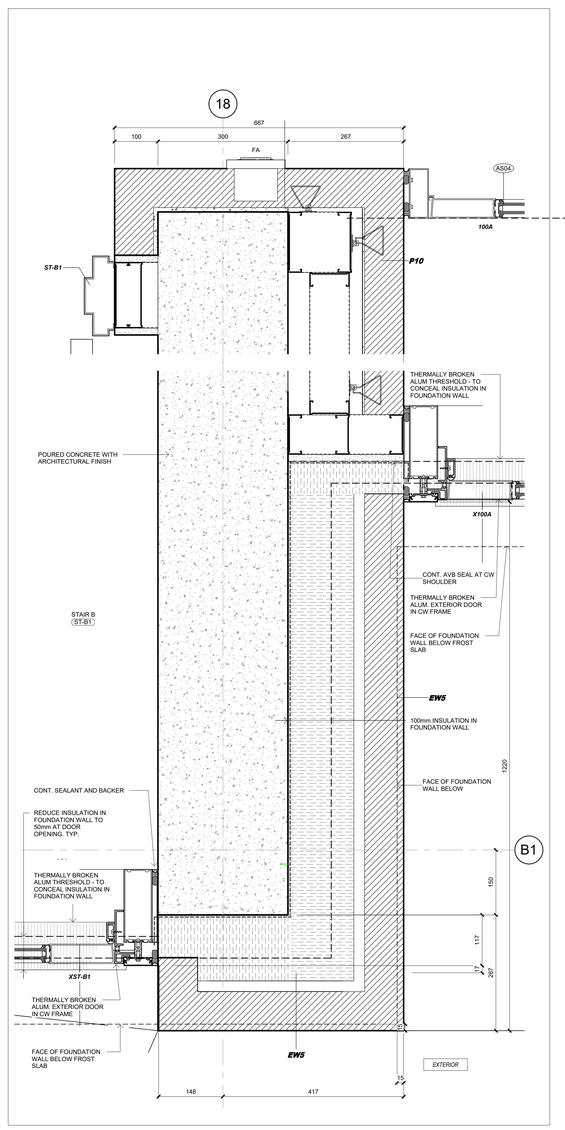

2 A5.00 EXT.PLAN DETAIL - GRID 18 AT MAIN VESTIBULE

1 : 5

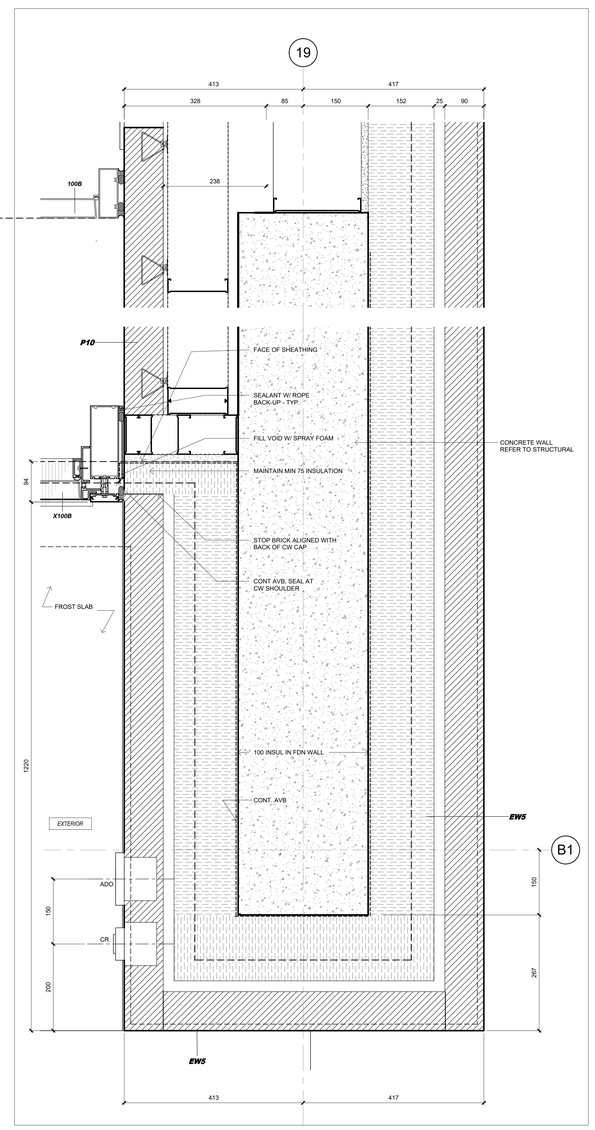

1 A5.00 EXT.PLAN DETAIL - GRID 19 AT MAIN VESTIBULE

1 : 5

4 A5.00 ROOF SCREEN POST DETAILS (TYPICAL)

1 : 5

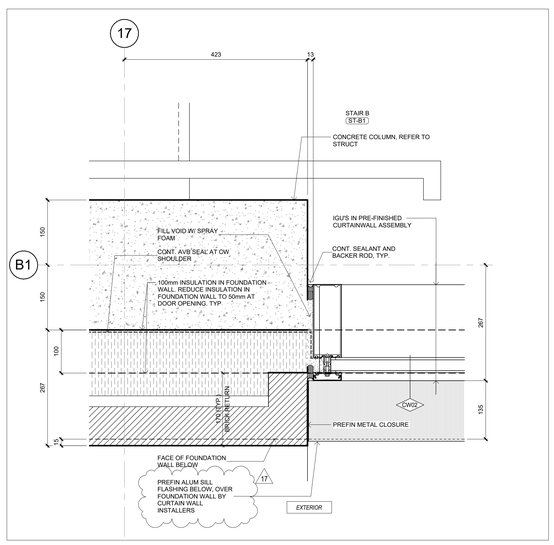

3 A5.00 EXT.PLAN DETAIL - TYP.CURTAINWALL AND BRICK RETURN

1 : 5

Key to Detail Location

NO. Detail Number
NO. Drawing Number

If this sheet is not 46 7/8" x 33 1/8" (1189 x 841 mm) it is a reduced print - Read dwg. accordingly.

Contractors must check and verify all dimensions on the job and report any discrepancies to the Architect before proceeding with the work.

All prints and specifications are the property of the Architect and must be returned at the completion of the work.

Drawings should not be scaled.

No	Date	Revision/Issued
11	2026 04 10	75% CD FOR CLIENT REVIEW
14	2026 05 15	90% CD FOR CLIENT REVIEW
15	2026 07 08	ISSUED FOR TENDER
17	2026 07 27	ISSUED FOR ADDENDA 3

consultants

architect
CS&P Architects Inc.
2345 Yonge St., Suite 200
Toronto, ON, M4P 2E5
Phone.416.482.5002
Fax.416.482.5040

civil engineer
SCS Consulting Group Ltd.
30 Centurian Drive, Suite 100
Markham, ON, L3R 8B8
Phone.905.475.1900
Fax.905.475.8335

structural engineer
LEA Consulting Ltd.
40 University Ave, Suite 503
Toronto, ON, M5J 1T1
Phone.905.470.0015

mechanical engineer
Smith + Andersen
4211 Yonge Street
Toronto, ON, M2P 2A9
Phone.416.487.8151

electrical engineer
Smith + Andersen
4211 Yonge Street
Toronto, ON, M2P 2A9
Phone.416.487.8151

landscape architect
Quinn Design Associates Inc.
180 John Street
Toronto, ON, M5T 1X5
Phone.416.962.8700

PROJECT NORTH N

CS&P Architects

THE STERLING HALL SCHOOL

99 Cartwright Avenue, Toronto, ON M6A 1V4

EXTERIOR PLAN DETAILS

scale:	1 : 5
date:	04/06/26
drawn:	ET
checked by:	Checker
project number:	21032
drawing number:	A5.00
Revision:	17

A0

FILENAME: Autodesk Docs://21032 Sterling Hall/21032_-SHS-A-MAIN-25.rvt

DRAWING LAST EDITED: 2026-07-27 4:47:24 PM

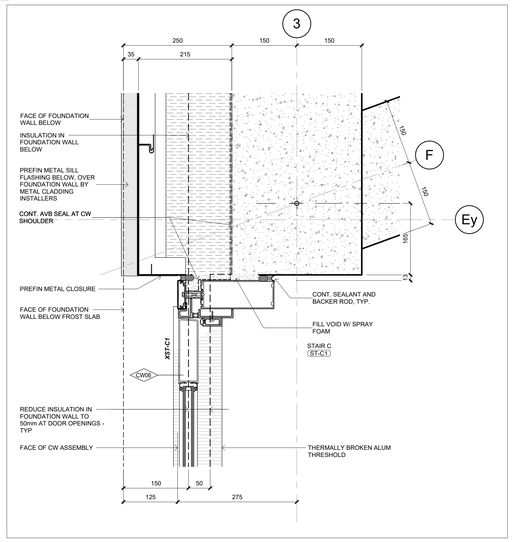

5 A5.01 EXT.PLAN DETAIL - GRID 3/F

1 : 5

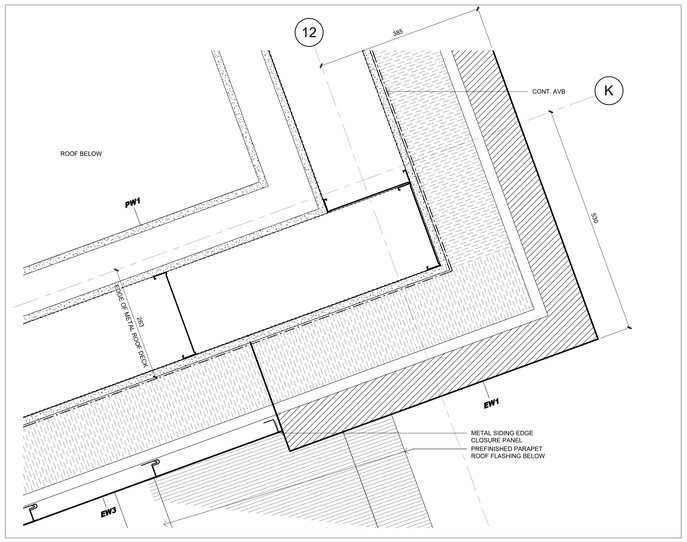

7 A5.01 EXT. PLAN DETAIL - CUT THROUGH HIGH ROOF PARAPET AT GRID 15K

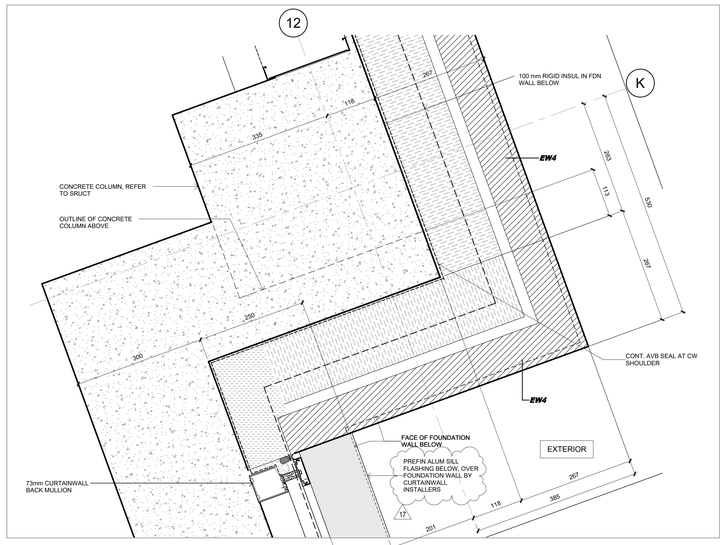

9 A5.01 EXT.PLAN DET- GRID 15/K GROUND LEVEL

1 : 5

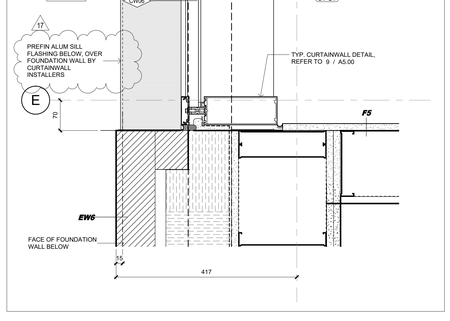

4 A5.01 EXT.PLAN DETAIL - ALONG GRID 3/E STAIR C

1 : 5

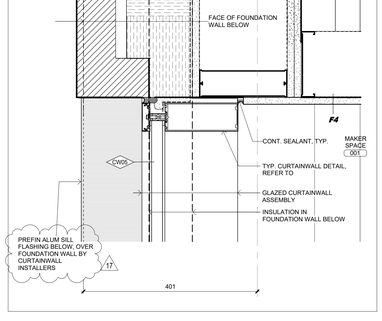

13 A5.01 EXT.PLAN DETAIL - ALONG GRID 3 MAKERSPACE

1 : 5

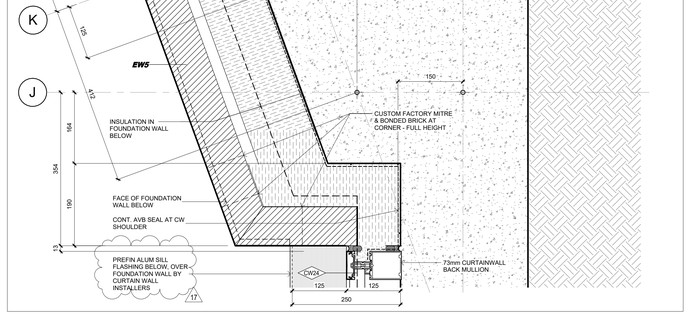

6 A5.01 EXT.PLAN DETAIL - GRID 2/J

1 : 5

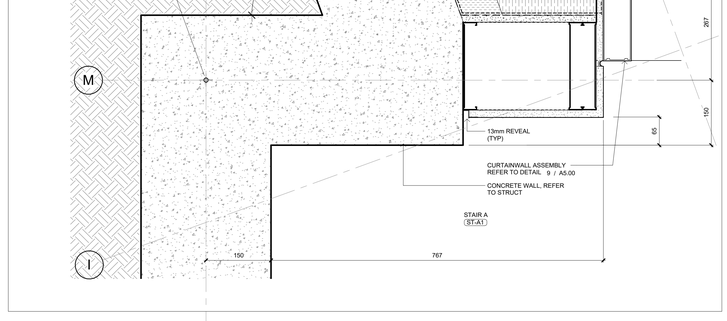

10 A5.01 EXT.PLAN DET- GRID 15/M GROUND LEVEL

1 : 5

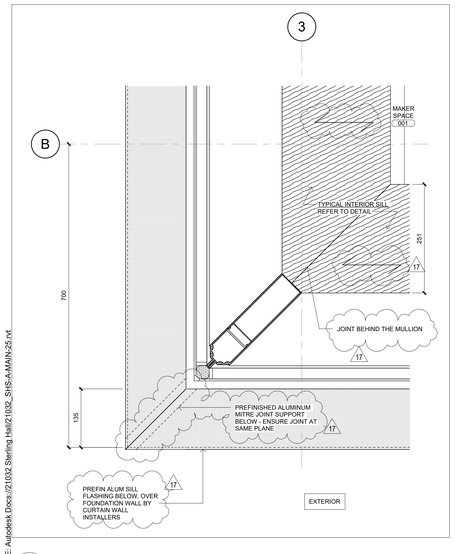

3 A5.01 EXT.PLAN DETAIL - GRID 3/B

1 : 5

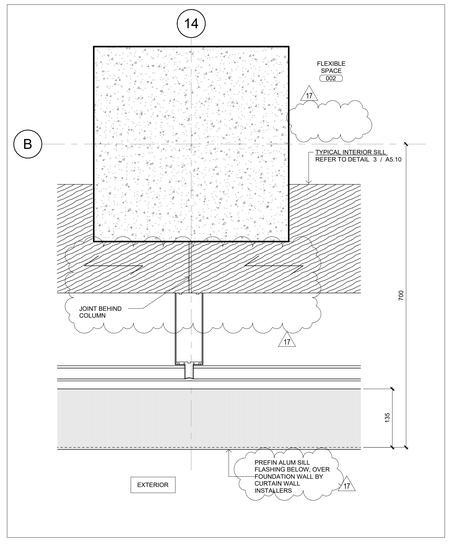

2 A5.01 EXT.PLAN DETAIL - GRID 14/B

1 : 5

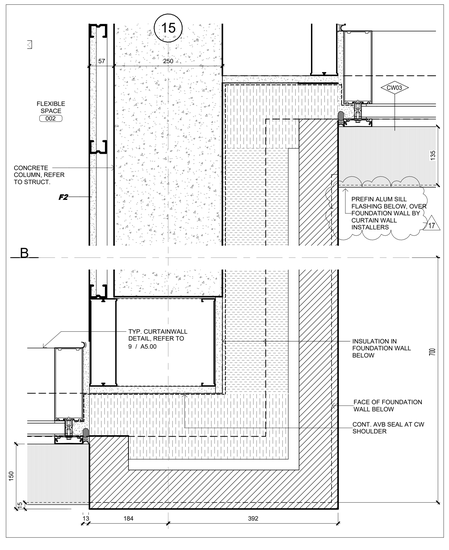

1 A5.01 EXT.PLAN DETAIL - GRID 15/B

1 : 5

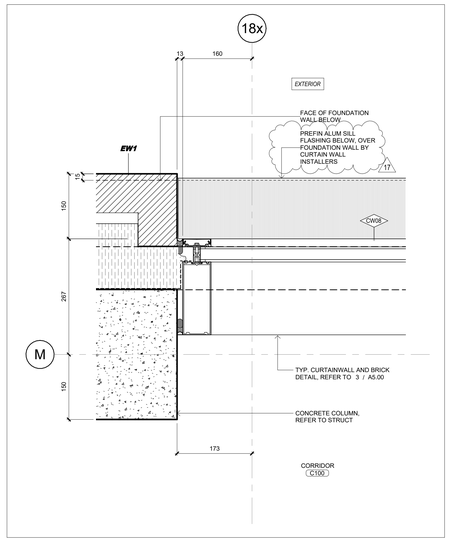

11 A5.01 EXT.PLAN DETAIL - GRID 18X/M

1 : 5

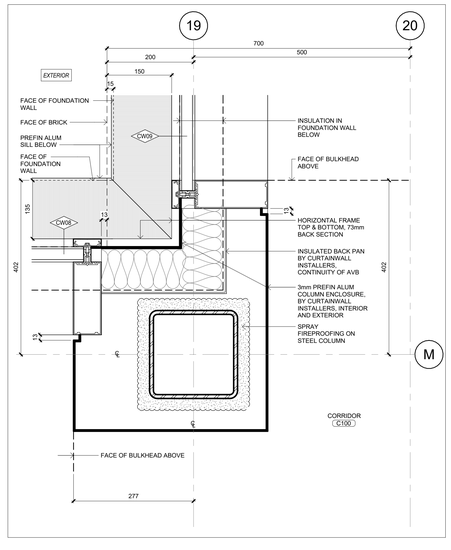

12 A5.01 EXT.PLAN DETAIL - GRID 19/M

1 : 5

Key to Detail Location

NO. Detail Number
NO. Drawing Number

If this sheet is not 46 7/8" x 33 1/8" (1189 x 841 mm) it is a reduced print - Read dwg. accordingly.

Contractors must check and verify all dimensions on the job and report any discrepancies to the Architect before proceeding with the work.

All prints and specifications are the property of the Architect and must be returned at the completion of the work.

Drawings should not be scaled.

No	Date	Revision/Issued
11	2026 04 10	75% CD FOR CLIENT REVIEW
14	2026 05 15	90% CD FOR CLIENT REVIEW
15	2026 07 08	ISSUED FOR TENDER
16	2026 07 17	ISSUED FOR ADDENDA 1
17	2026 07 27	ISSUED FOR ADDENDA 3

consultants

architect
CS&P Architects Inc.
2345 Yonge St., Suite 200
Toronto, ON, M4P 2E5
Phone.416.482.5002
Fax.416.482.5040

civil engineer
SCS Consulting Group Ltd.
30 Centurian Drive, Suite 100
Markham, ON, L3R 8B8
Phone.905.475.1900
Fax.905.475.8335

structural engineer
LEA Consulting Ltd.
40 University Ave, Suite 503
Toronto, ON, M5J 1T1
Phone.905.470.0015

mechanical engineer
Smith + Andersen
4211 Yonge Street
Toronto, ON, M2P 2A9
Phone.416.487.8151

electrical engineer
Smith + Andersen
4211 Yonge Street
Toronto, ON, M2P 2A9
Phone.416.487.8151

landscape architect
Quinn Design Associates Inc.
180 John Street
Toronto, ON, M5T 1X5
Phone.416.962.8700

PROJECT NORTH N

SHS CS&P Architects

THE STERLING HALL SCHOOL

99 Cartwright Avenue, Toronto, ON M6A 1V4

EXTERIOR PLAN DETAILS

scale:	1 : 5
date:	04/06/26
drawn:	ET
checked by:	Checker
project number:	21032
drawing number:	A5.01
Revision:	17

A0

FILENAME: Autodesk Docs://21032_Sterling Hall/21032_SHS-A-MAIN-25.rvt

DRAWING LAST EDITED: 2026-07-27 4:47:29 PM

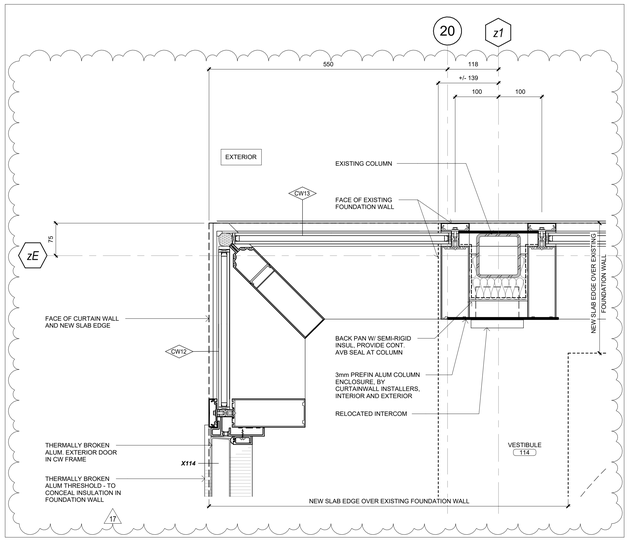

6 A5.02 EXT. PLAN DETAIL - VESTIBULE 114

1 : 5

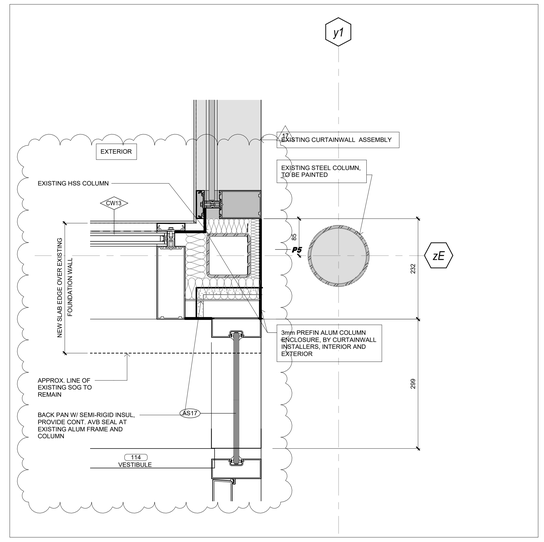

5 A5.02 EXT. PLAN DETAIL - VESTIBULE 114 AT GRID y1/zE

1 : 5

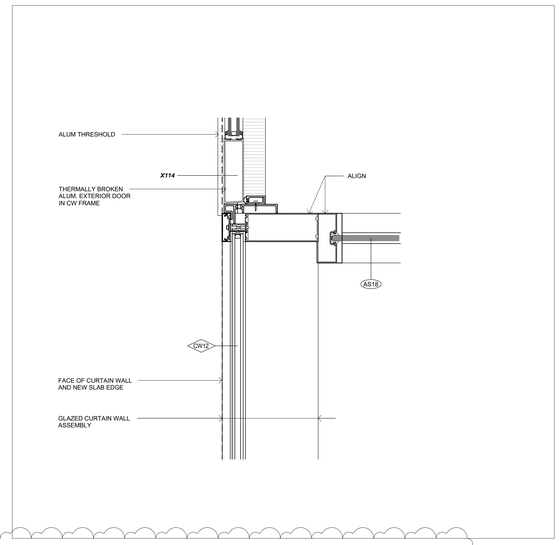

8 A5.02 EXT. PLAN DETAIL - CW12

1 : 5

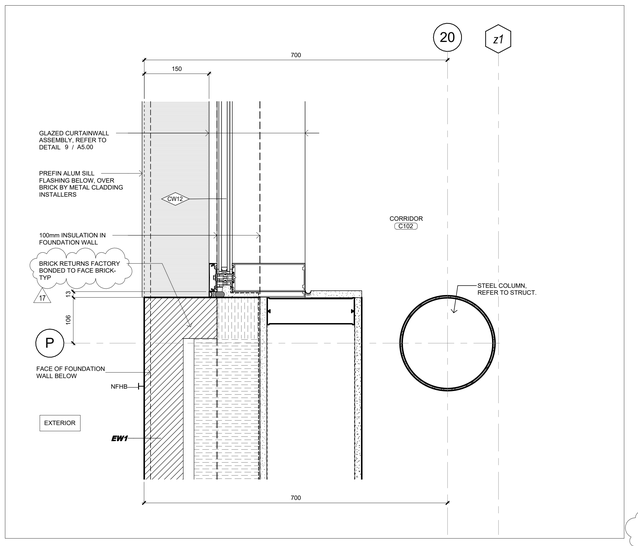

4 A5.02 EXT. PLAN DETAIL - GRID 20/P AT CORRIDOR C102

1 : 5

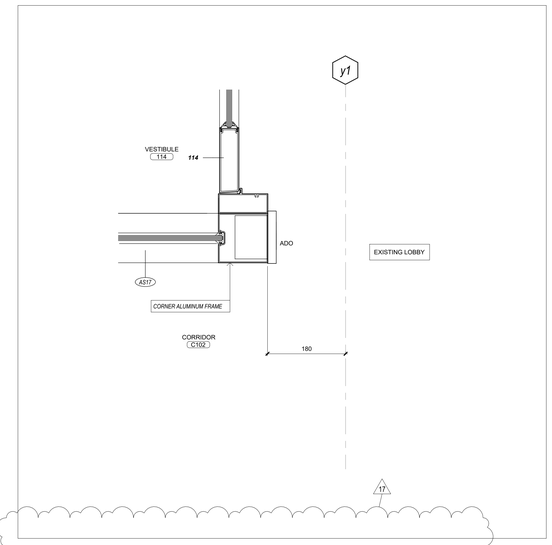

3 A5.02 EXT. PLAN DETAIL - CORNER MULLION AT AS17

1 : 5

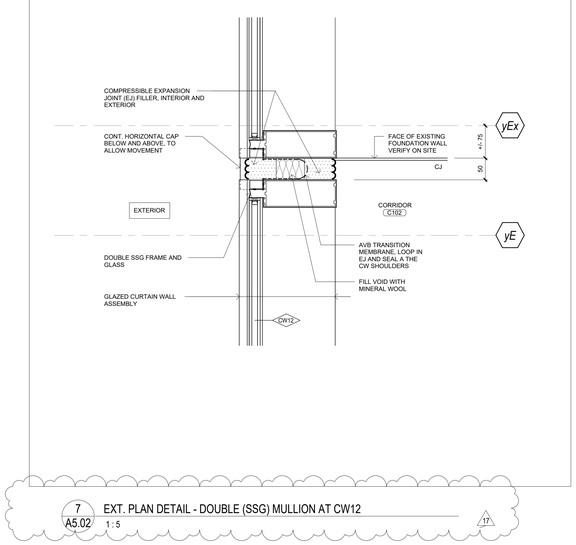

7 A5.02 EXT. PLAN DETAIL - DOUBLE (SSG) MULLION AT CW12

1 : 5

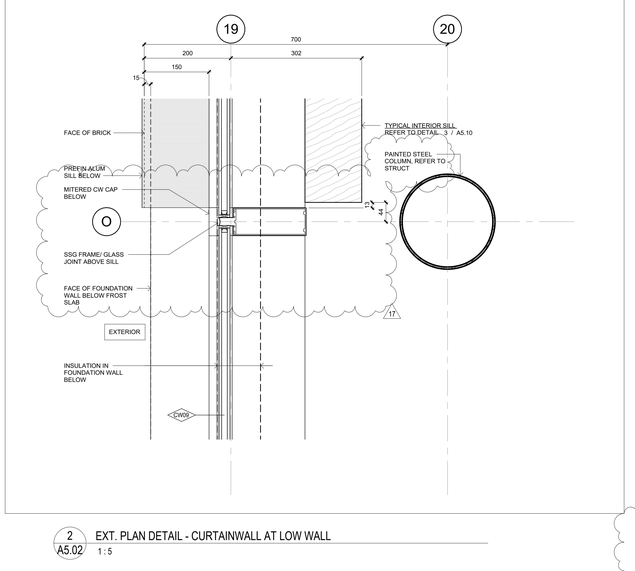

2 A5.02 EXT. PLAN DETAIL - CURTAINWALL AT LOW WALL

1 : 5

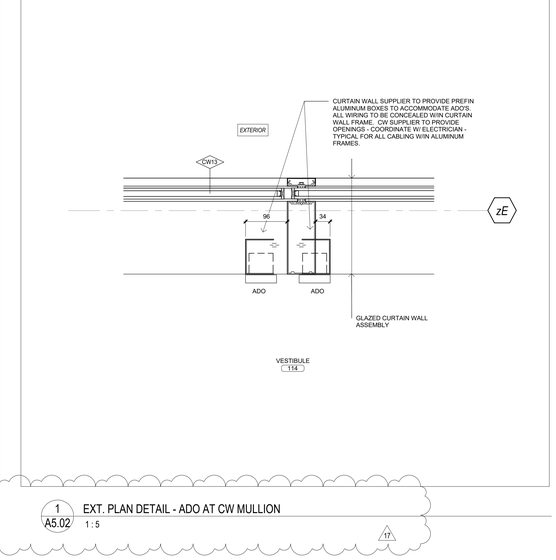

1 A5.02 EXT. PLAN DETAIL - ADO AT CW MULLION

1 : 5

Key to Detail Location

NO. Detail Number
NO. Drawing Number

If this sheet is not 46 7/8" x 33 1/8" (1189 x 841 mm) it is a reduced print - Read dwg. accordingly.

Contractors must check and verify all dimensions on the job and report any discrepancies to the Architect before proceeding with the work.

All prints and specifications are the property of the Architect and must be returned at the completion of the work.

Drawings should not be scaled.

No	Date	Revision/Issued
11	2026 04 10	75% CD FOR CLIENT REVIEW
14	2026 05 15	90% CD FOR CLIENT REVIEW
15	2026 07 08	ISSUED FOR TENDER
17	2026 07 27	ISSUED FOR ADDENDA 3

consultants

architect — CS&P Architects Inc., 2345 Yonge St., Suite 200, Toronto, ON, M4P 2E5, Phone.416.482.5002, Fax.416.482.5040

civil engineer — SCS Consulting Group Ltd., 30 Centurian Drive, Suite 100, Markham, ON, L3R 8B8, Phone.905.475.1900, Fax.905.475.8335

structural engineer — LEA Consulting Ltd., 40 University Ave, Suite 503, Toronto, ON, M5J 1T1, Phone.905.470.0015

mechanical engineer — Smith + Andersen, 4211 Yonge Street, Toronto, ON, M2P 2A9, Phone.416.487.8151

electrical engineer — Smith + Andersen, 4211 Yonge Street, Toronto, ON, M2P 2A9, Phone.416.487.8151

landscape architect — Quinn Design Associates Inc., 180 John Street, Toronto, ON, M5T 1X5, Phone.416.962.8700

PROJECT NORTH N

SHS CS&P Architects

THE STERLING HALL SCHOOL

99 Cartwright Avenue, Toronto, ON M6A 1V4

EXTERIOR PLAN DETAILS

scale:	1 : 5
date:	04/06/26
drawn:	ET
checked by:	Checker
project number:	21032
drawing number:	A5.02
Revision:	17

A0

FILENAME: Autodesk Docs://21032 Sterling Hall/21032_SHS-A-MAIN-25.rvt

DRAWING LAST EDITED: 2026-07-27 4:47:33 PM

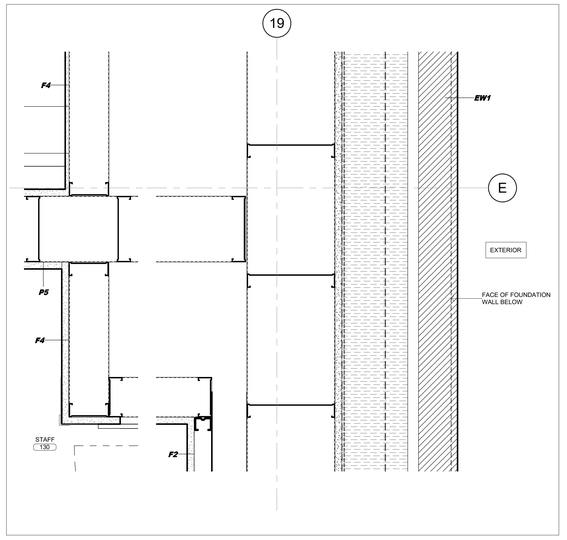

4 A5.04 EXT.PLAN DETAIL- MEZZANINE LEVEL AT GRID 19/E

1 : 5

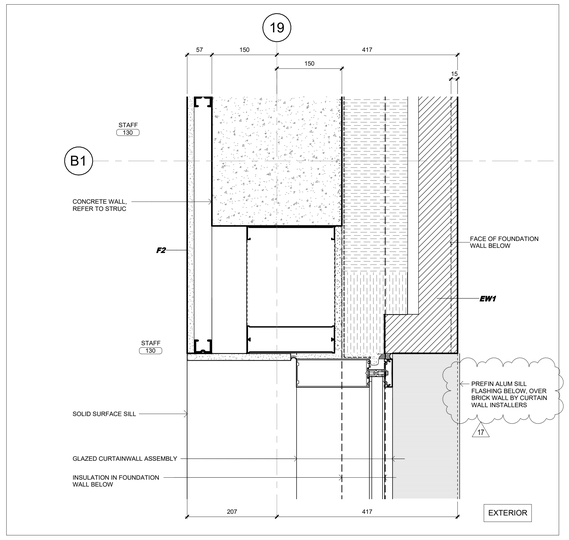

3 A5.04 EXT.PLAN DETAIL- MEZZANINE LEVEL AT EAST SHEAR WALL

1 : 5

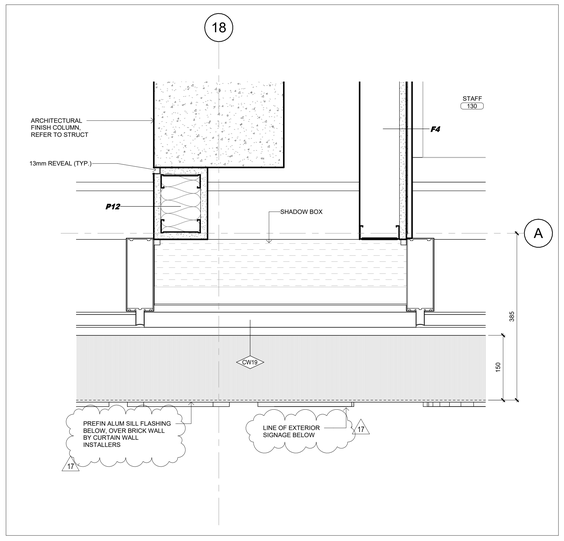

2 A5.04 EXT.PLAN DETAIL- MEZZANINE LEVEL AT SOUTH SHADOW BOX

1 : 5

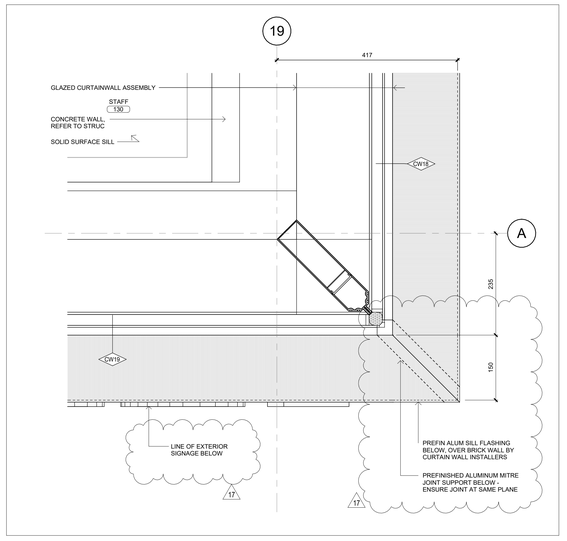

1 A5.04 EXT.PLAN DETAIL- MEZZANINE LEVEL AT SOUTHEAST CORNER WINDOW

1 : 5

Key to Detail Location

NO. / NO. — Detail Number / Drawing Number

If this sheet is not 46 7/8" x 33 1/8" (1189 x 841 mm) it is a reduced print - Read dwg. accordingly.

Contractors must check and verify all dimensions on the job and report any discrepancies to the Architect before proceeding with the work.

All prints and specifications are the property of the Architect and must be returned at the completion of the work.

Drawings should not be scaled.

No	Date	Revision/Issued
11	2026 04 10	75% CD FOR CLIENT REVIEW
14	2026 05 15	90% CD FOR CLIENT REVIEW
15	2026 07 08	ISSUED FOR TENDER
17	2026 07 27	ISSUED FOR ADDENDA 3

consultants

architect — CS&P Architects Inc.
2345 Yonge St., Suite 200
Toronto, ON, M4P 2E5
Phone.416.482.5002
Fax.416.482.5040

civil engineer — SCS Consulting Group Ltd.
30 Centurian Drive, Suite 100
Markham, ON, L3R 8B8
Phone.905.475.1900
Fax.905.475.8335

structural engineer — LEA Consulting Ltd.
40 University Ave, Suite 503
Toronto, ON, M5J 1T1
Phone.905.470.0015

mechanical engineer — Smith + Andersen
4211 Yonge Street
Toronto, ON, M2P 2A9
Phone.416.487.8151

electrical engineer — Smith + Andersen
4211 Yonge Street
Toronto, ON, M2P 2A9
Phone.416.487.8151

landscape architect — Quinn Design Associates Inc.
180 John Street
Toronto, ON, M5T 1X5
Phone.416.962.8700

PROJECT NORTH

CS&P Architects

THE STERLING HALL SCHOOL

99 Cartwright Avenue, Toronto, ON M6A 1V4

EXTERIOR PLAN DETAILS

scale:	1 : 5
date:	04/08/26
drawn:	ET
checked by:	Checker
project number:	21032
drawing number:	A5.04
	Revision: 17

A0

FILENAME: Autodesk Docs://21032 Sterling Hall/21032_SHS-A-MAIN-25.rvt

DRAWING LAST EDITED: 2026-07-27 4:47:35 PM

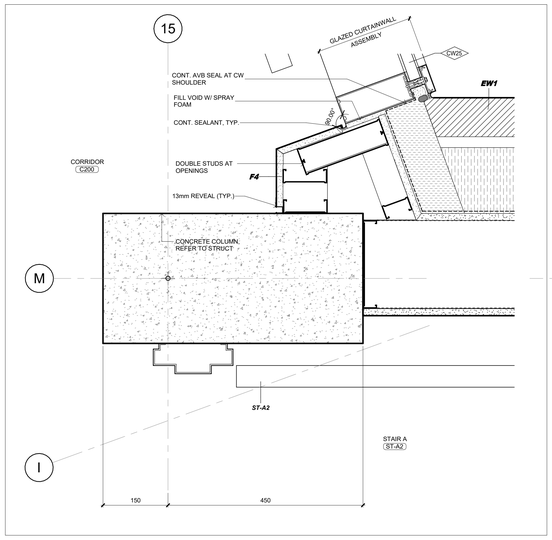

7 A5.05 EXT. PLAN DEETAIL - GRID 15/M SECOND LEVEL

1 : 5

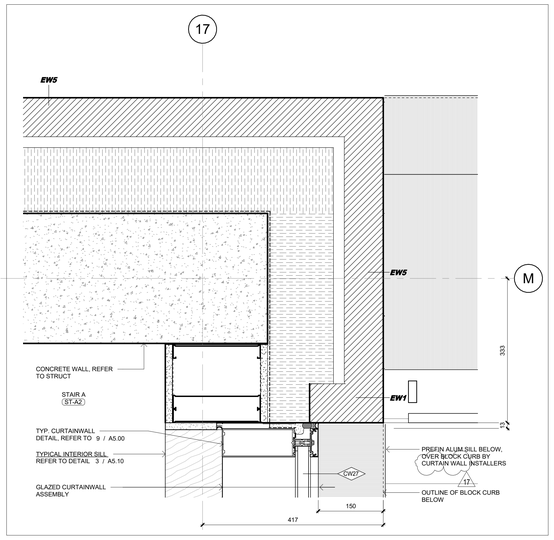

8 A5.05 EXT.PLAN DETAIL - GRID 17/M

1 : 5

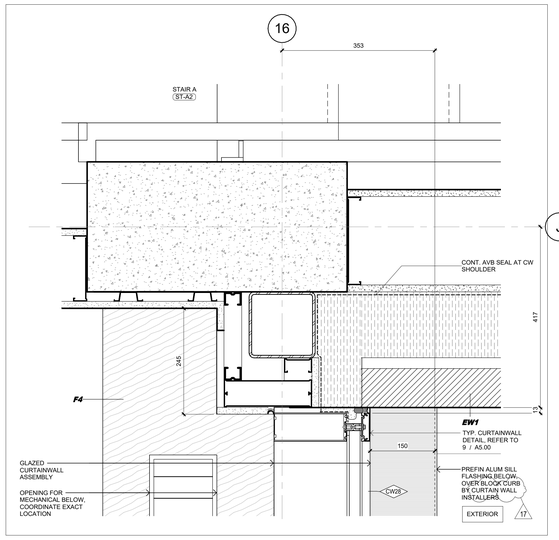

9 A5.05 EXT.PLAN DETAIL - NORTH OF CW 28

1 : 5

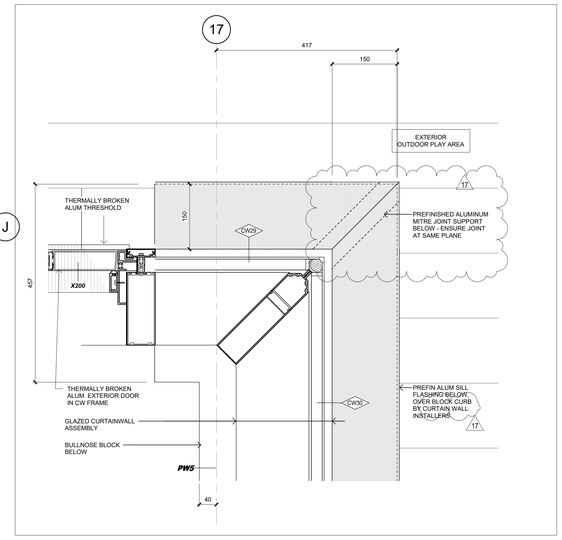

11 A5.05 EXT.PLAN DETAIL - VESTIBULE 200 AT GRID 17

1 : 5

5 A5.05 EXT.PLAN DETAIL - CURTAINWALL ON SILL

1 : 5

10 A5.05 EXT.PLAN DETAIL - SOUT OF CW 28

1 : 5

12 A5.05 EXT.PLAN DETAIL - VESTIBULE 200 GRID 17/E

1 : 5

4 A5.05 EXT.PLAN DETAIL - SECOND LEVEL CORNER CURTAINWALL ON SILL

1 : 5

2 A5.05 EXT.PLAN DETAIL - SECOND LEVEL CURTAINWALL WITH DEEP CAP

1 : 5

1 A5.05 EXT.PLAN DETAIL - SECOND LEVEL CORNER BRICK AT OUTDOOR PLAY AREA

1 : 5

Key to Detail Location

NO. Detail Number
NO. Drawing Number

If this sheet is not 46 7/8" x 33 1/8" (1189 x 841 mm) it is a reduced print - Read dwg. accordingly.

Contractors must check and verify all dimensions on the job and report any discrepancies to the Architect before proceeding with the work.

All prints and specifications are the property of the Architect and must be returned at the completion of the work.

Drawings should not be scaled.

No	Date	Revision/Issued
11	2026 04 10	75% CD FOR CLIENT REVIEW
14	2026 05 15	90% CD FOR CLIENT REVIEW
15	2026 07 08	ISSUED FOR TENDER
17	2026 07 27	ISSUED FOR ADDENDA 3

consultants

architect — CS&P Architects Inc., 2345 Yonge St., Suite 200, Toronto, ON, M4P 2E5, Phone.416.482.5002, Fax.416.482.5040

civil engineer — SCS Consulting Group Ltd., 30 Centurian Drive, Suite 100, Markham, ON, L3R 8B8, Phone.905.475.1900, Fax.905.475.8335

structural engineer — LEA Consulting Ltd., 40 University Ave, Suite 503, Toronto, ON, M5J 1T1, Phone.905.470.0015

mechanical engineer — Smith + Andersen, 4211 Yonge Street, Toronto, ON, M2P 2A9, Phone.416.487.8151

electrical engineer — Smith + Andersen, 4211 Yonge Street, Toronto, ON, M2P 2A9, Phone.416.487.8151

landscape architect — Quinn Design Associates Inc., 180 John Street, Toronto, ON, M5T 1X5, Phone.416.962.8700

PROJECT NORTH

CS&P Architects

THE STERLING HALL SCHOOL

99 Cartwright Avenue, Toronto, ON M6A 1V4

EXTERIOR PLAN DETAILS

scale:	1 : 5
date:	04/08/26
drawn:	Author
checked by:	Checker
project number:	21032
drawing number:	A5.05
	Revision: 17

A0

FILENAME: Autodesk Docs://21032 Sterling Hall/21032_SHS-A-MAIN-25.rvt

DRAWING LAST EDITED: 2026-07-27 4:47:40 PM

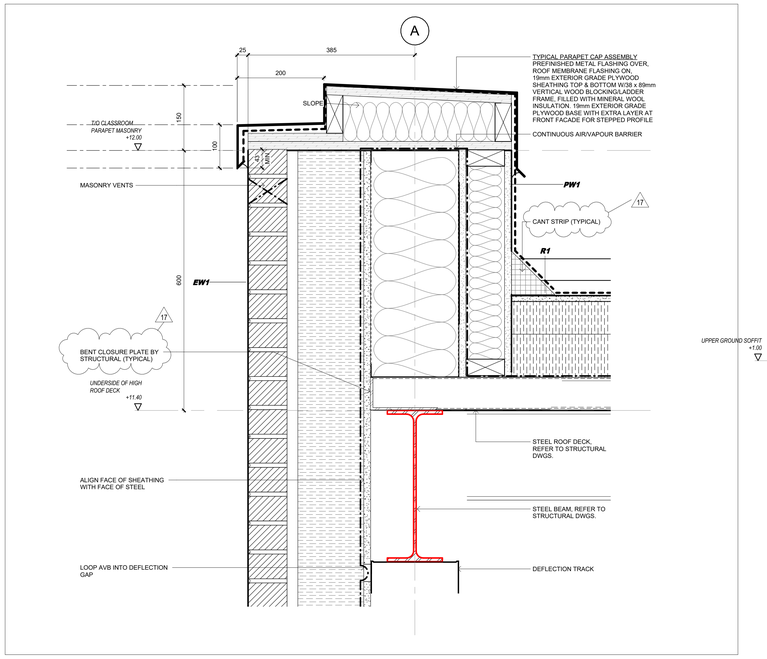

9 A5.10 SECTION DETAIL - TYPICAL PARAPET
1 : 5

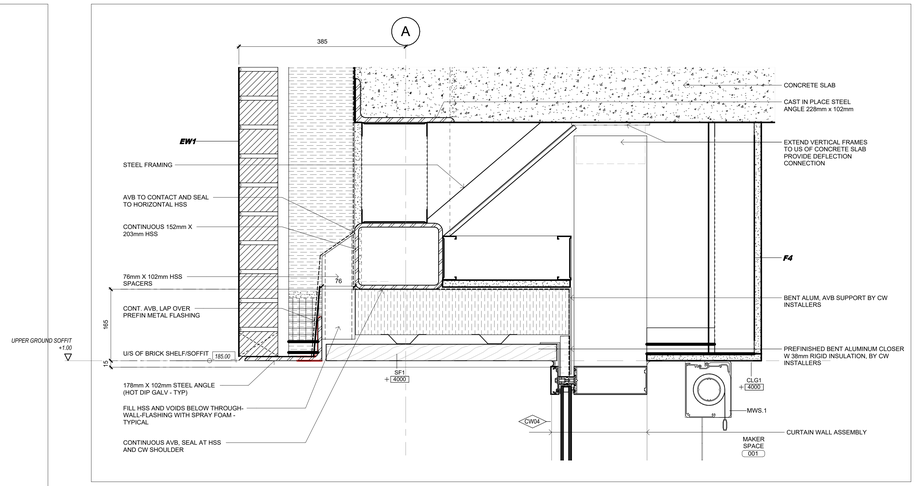

8 A5.10 SECTION DETAIL - TYPICAL BRICK OVERHANG AND SOFFIT
1 : 5

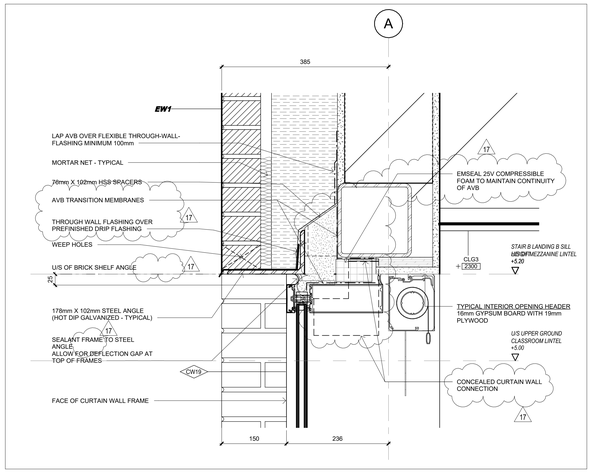

7 A5.10 SECTION DETAIL - TYPICAL CURTAIN WALL HEADER
1 : 5

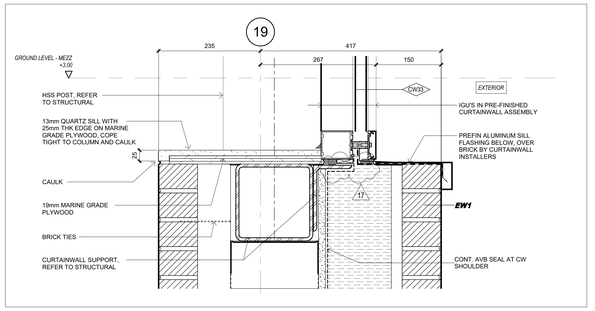

4 A5.10 SECTION DETAIL - QUARTZ SILL
1 : 5

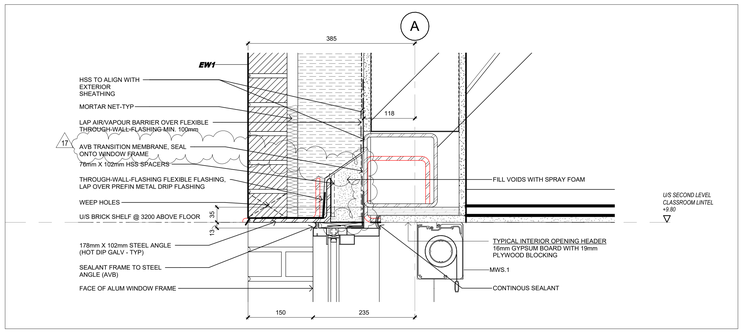

6 A5.10 SECTION DETAIL - TYPICAL WINDOW HEADER
1 : 5

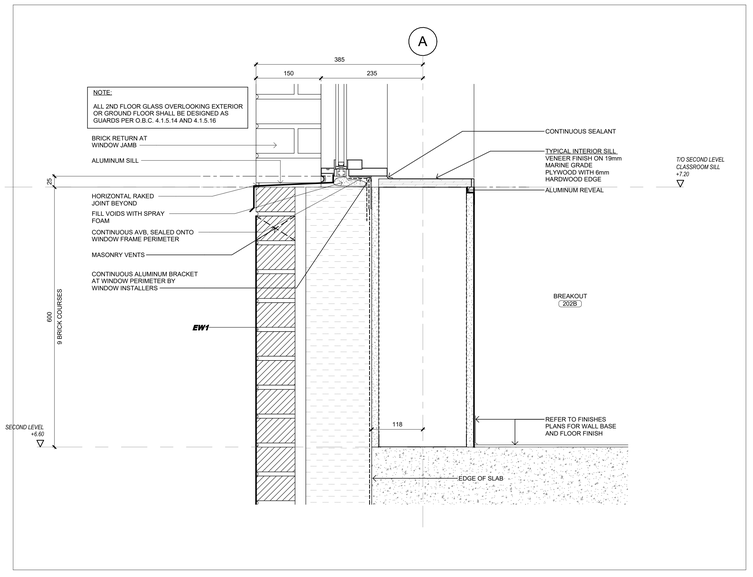

3 A5.10 SECTION DETAIL - TYPICAL WINDOW SILL
1 : 5

5 A5.10 SECTION DETAIL - TYPICAL CURTAIN WALL AT TOP OF FOUNDATION
1 : 5

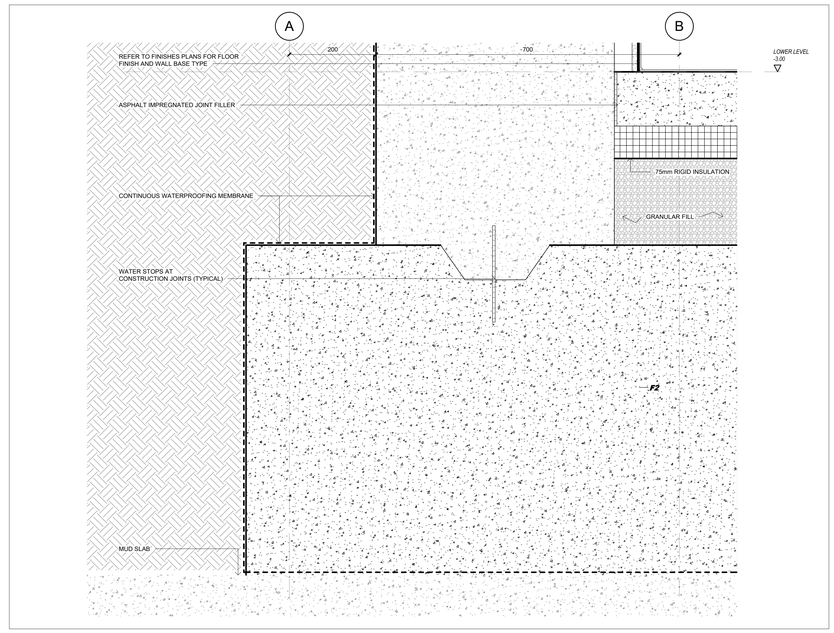

2 A5.10 TYPICAL FOUNDATION @ BASEMENT DETAIL
1 : 5

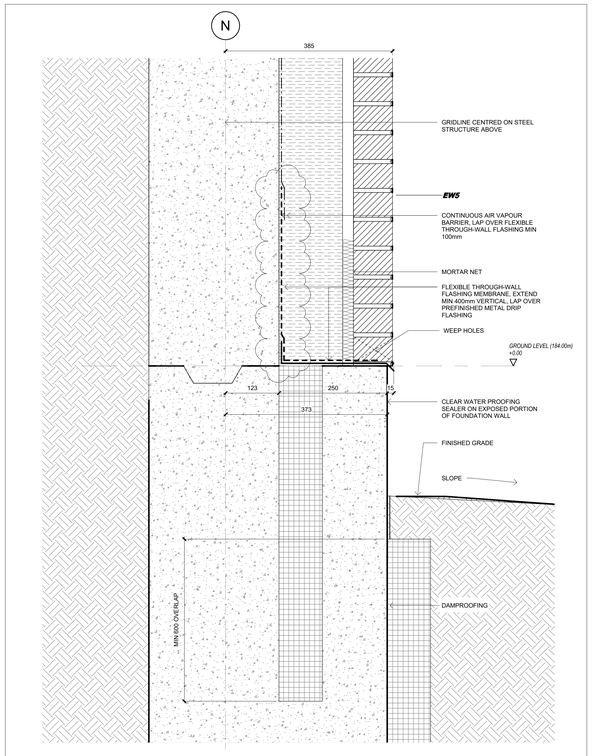

1 A5.10 SECTION DETAIL - TYPICAL TOP OF FOUNDATION @ NO BASEMENT
1 : 5

Key to Detail Location

NO. (Detail Number)
NO. (Drawing Number)

If this sheet is not 46 7/8" x 33 1/8" (1189 x 841 mm) it is a reduced print - Read dwg. accordingly.

Contractors must check and verify all dimensions on the job and report any discrepancies to the Architect before proceeding with the work.

All prints and specifications are the property of the Architect and must be returned at the completion of the work.

Drawings should not be scaled.

No	Date	Revision/Issued
13	2026 04 10	75% CD FOR CLIENT REVIEW
14	2026 05 15	90% CD FOR CLIENT REVIEW
15	2026 07 08	ISSUED FOR TENDER
17	2026 07 27	ISSUED FOR ADDENDA 3

consultants

architect — CS&P Architects Inc., 2345 Yonge St., Suite 200, Toronto, ON, M4P 2E5, Phone.416.482.5002, Fax.416.482.5040

civil engineer — SCS Consulting Group Ltd., 30 Centurian Drive, Suite 100, Markham, ON, L3R 8B8, Phone.905.475.1900, Fax.905.475.8335

structural engineer — LEA Consulting Ltd., 40 University Ave, Suite 503, Toronto, ON, M5J 1T1, Phone.905.470.0015

mechanical engineer — Smith + Andersen, 4211 Yonge Street, Toronto, ON, M2P 2A9, Phone.416.487.8151

electrical engineer — Smith + Andersen, 4211 Yonge Street, Toronto, ON, M2P 2A9, Phone.416.487.8151

landscape architect — Quinn Design Associates Inc., 180 John Street, Toronto, ON, M5T 1X5, Phone.416.962.8700

PROJECT NORTH

SHS CS&P Architects

THE STERLING HALL SCHOOL

99 Cartwright Avenue, Toronto, ON M6A 1V4

EXTERIOR SECTION DETAILS

scale:	1 : 5
date:	10/01/25
drawn:	CS&P
checked by:	CA
project number:	21032
drawing number:	A5.10
	Revision: 17

A0

FILENAME: Autodesk Docs://21032 Sterling Hall/21032_SHS-A-MAIN-25.rvt

DRAWING LAST EDITED: 2026-07-27 4:47:45 PM

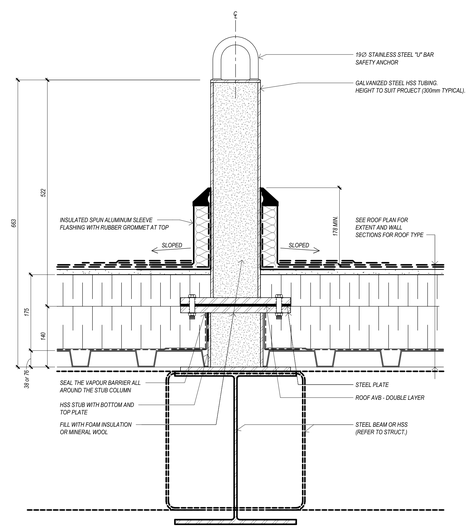

9 A5.11 SECTION DETAIL - TYPICAL ROOF ANCHOR AT SEEL STRUCTURE AND STEEL DECK

1 : 5

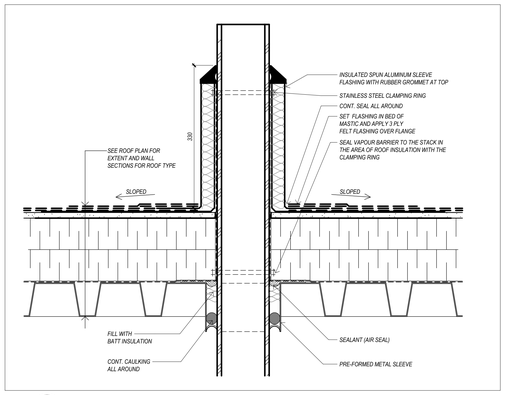

8 A5.11 SECTION DETAIL - TYPICAL VENT STACK FLASHING

1 : 5

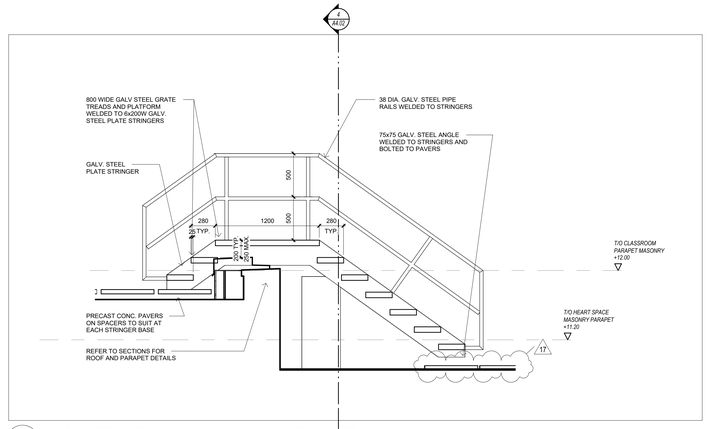

7 A5.11 SECTION DETAIL - TYPICAL ROOF ACCESS STAIR (CROSSOVER)

1 : 25

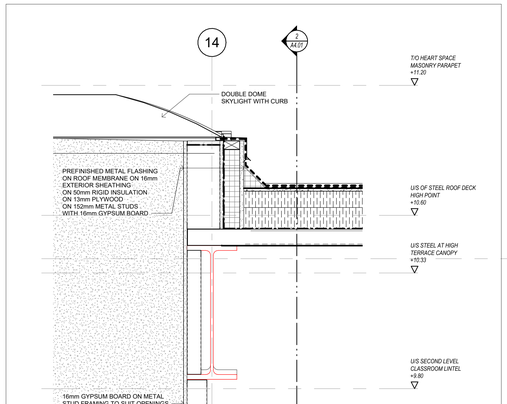

5 A5.11 SECTION DETAIL - SKYLIGHT EDGE

1 : 10

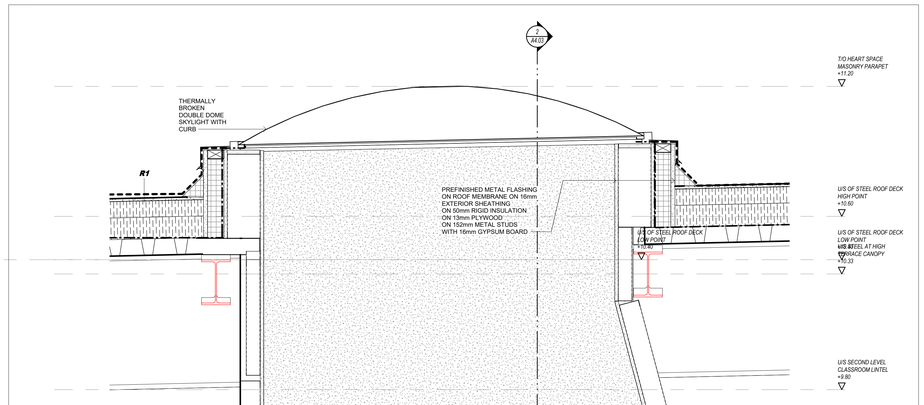

4 A5.11 SECTION DETAIL - SKYLIGHT WITH SLOPED SIDE

1 : 10

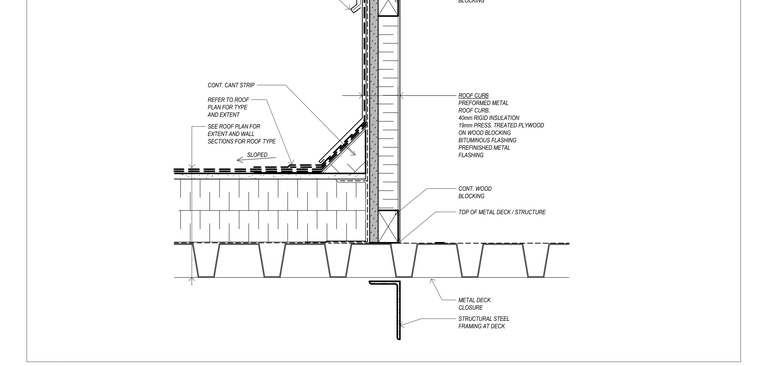

6 A5.11 SECTION DETAIL - TYPICAL ROOF CURB AT MECHANICAL EQUIPMENT

1 : 5

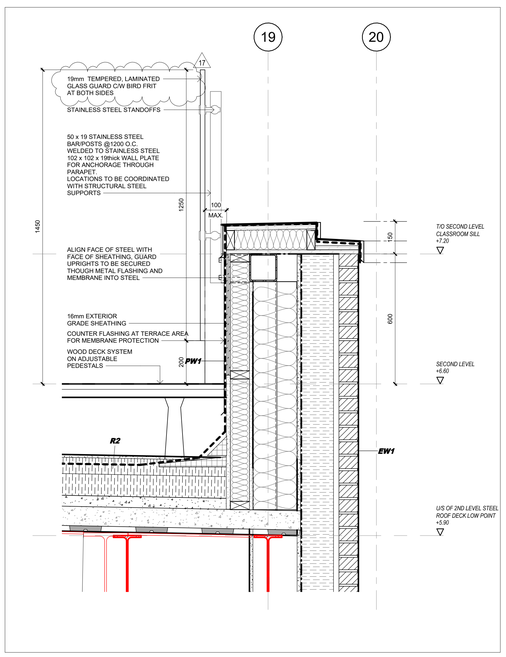

2 A5.11 SECTION DETAIL - TYPICAL EXTERIOR GLASS BALLUSTRADE AT ROOF TERRACE

1 : 10

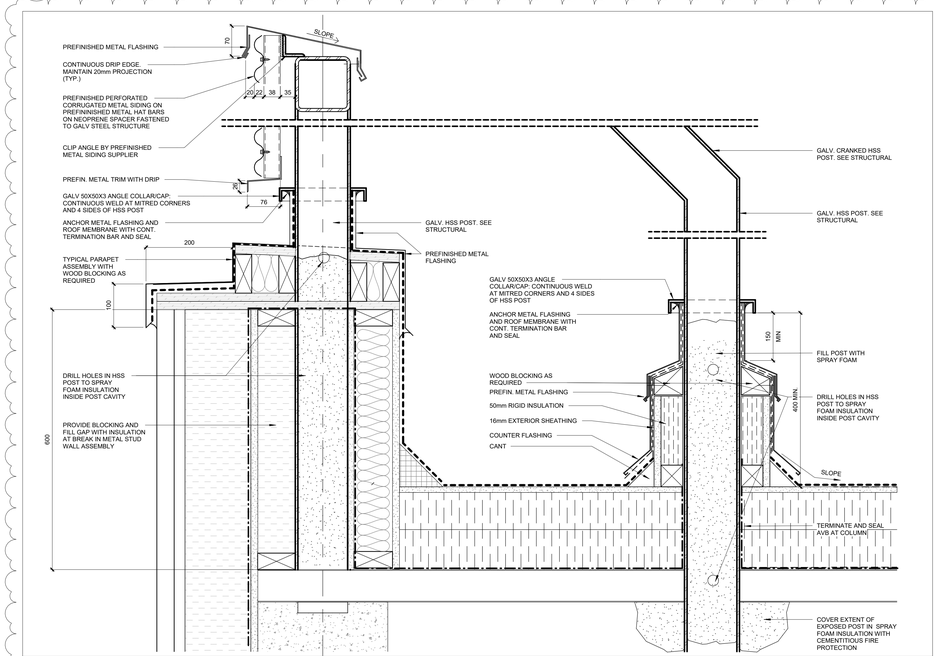

1 A5.11 SECTION DETAIL - TYPICAL PARAPET AND POST AT ROOF SCREEN

1 : 5

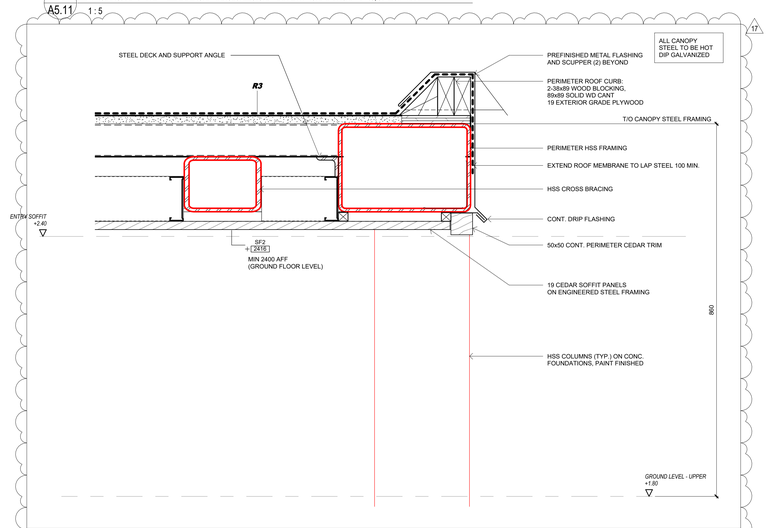

3 A5.11 SECTION DETAIL - CANOPY PARAPET

1 : 5

Key to Detail Location

NO. / NO. — Detail Number / Drawing Number

If this sheet is not 46 7/8" x 33 1/8" (1189 x 841 mm) it is a reduced print - Read dwg. accordingly.

Contractors must check and verify all dimensions on the job and report any discrepancies to the Architect before proceeding with the work.

All prints and specifications are the property of the Architect and must be returned at the completion of the work.

Drawings should not be scaled.

No	Date	Revision/Issued
11	2026 04 10	75% CD FOR CLIENT REVIEW
14	2026 05 15	90% CD FOR CLIENT REVIEW
15	2026 07 08	ISSUED FOR TENDER
17	2026 07 27	ISSUED FOR ADDENDA 3

consultants

architect — CS&P Architects Inc., 2345 Yonge St., Suite 200, Toronto, ON, M4P 2E5, Phone.416.482.5002, Fax.416.482.5040

civil engineer — SCS Consulting Group Ltd., 30 Centurian Drive, Suite 100, Markham, ON, L3R 8B8, Phone.905.475.1900, Fax.905.475.8335

structural engineer — LEA Consulting Ltd., 40 University Ave, Suite 503, Toronto, ON, M5J 1T1, Phone.905.470.0015

mechanical engineer — Smith + Andersen, 4211 Yonge Street, Toronto, ON, M2P 2A9, Phone.416.487.8151

electrical engineer — Smith + Andersen, 4211 Yonge Street, Toronto, ON, M2P 2A9, Phone.416.487.8151

landscape architect — Quinn Design Associates Inc., 180 John Street, Toronto, ON, M5T 1X5, Phone.416.962.8700

PROJECT NORTH N

SHS CS&P Architects

THE STERLING HALL SCHOOL

99 Cartwright Avenue, Toronto, ON M6A 1V4

EXTERIOR SECTION DETAILS

scale:	As indicated
date:	10/01/25
drawn:	CS&P
checked by:	CA
project number:	21032
drawing number:	A5.11
	Revision: 17

A0

FILENAME: Autodesk Docs://21032 Sterling Hall/21032_SHS-A-MAIN-25.rvt

DRAWING LAST EDITED: 2026-07-27 4:47:49 PM

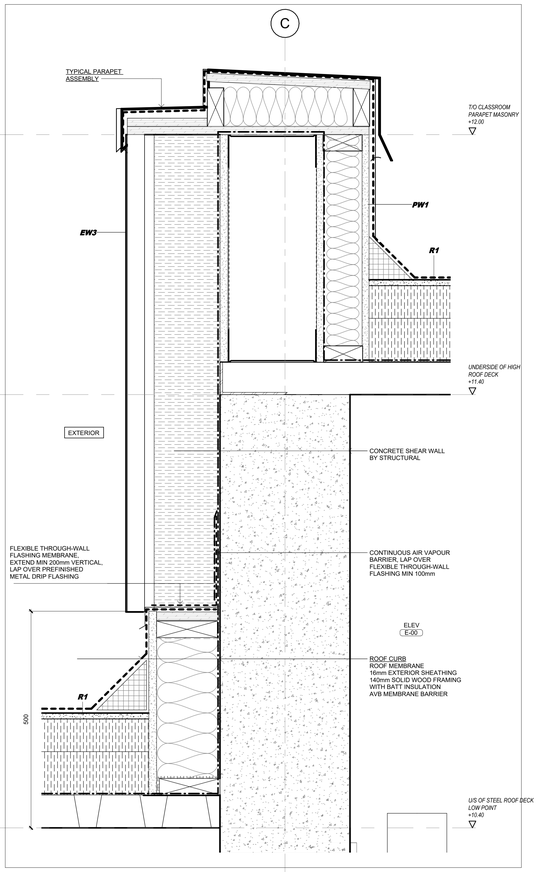

8 A5.12 ROOF AT ELEVATOR
1 : 5

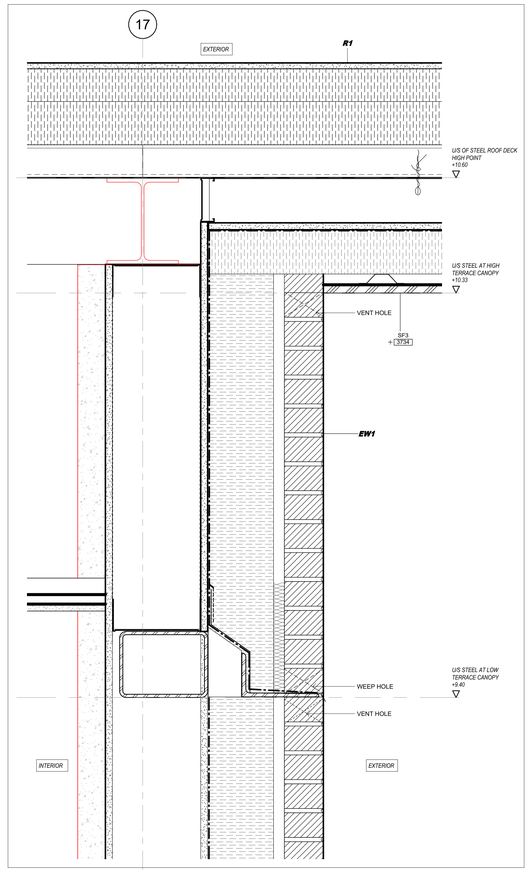

7 A5.12 ROOF PLAY AREA - CONNECTION AT HIGH CANOPY
1 : 5

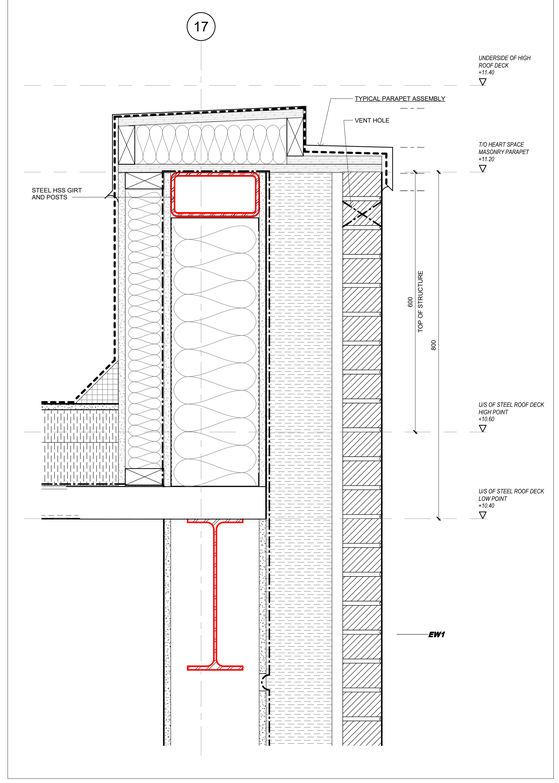

6 A5.12 ROOF PARAPET AT SLOPED ROOF
1 : 5

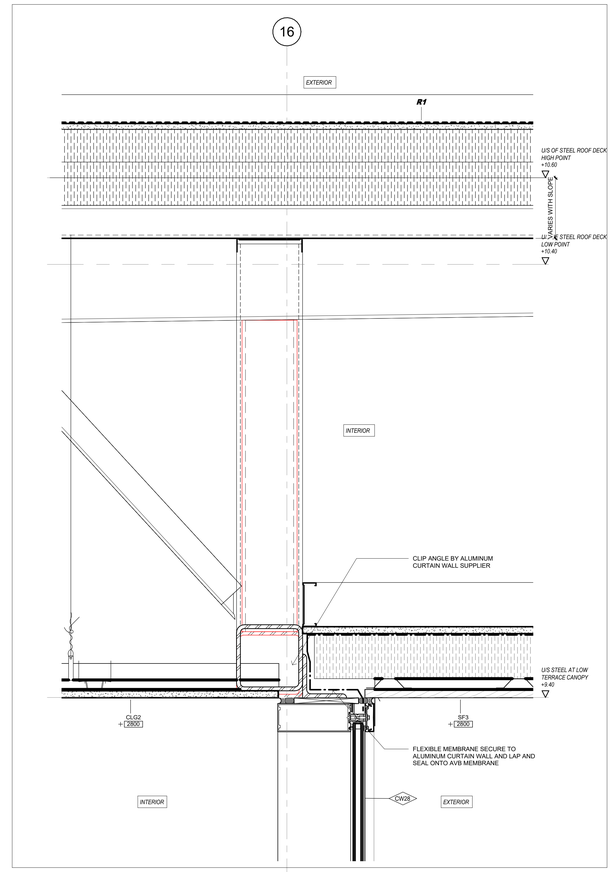

5 A5.12 ROOF PLAY AREA - HEADER AT CW & CONNECTION TO LOW CANOPY
1 : 5

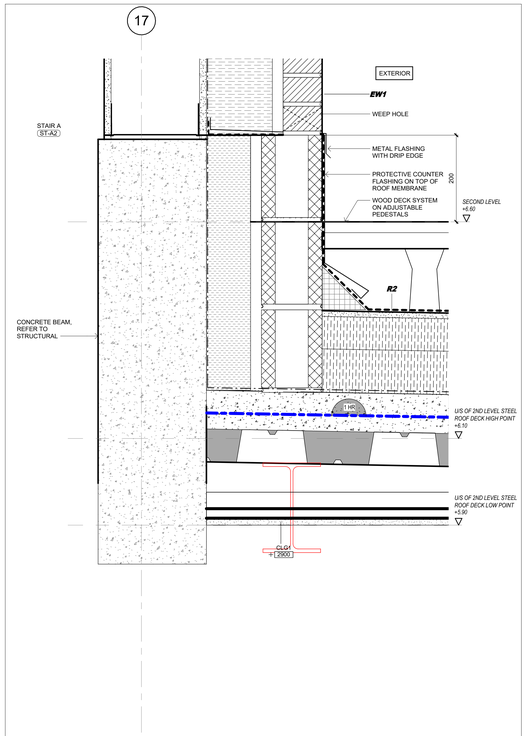

4 A5.12 ROOF PLAY AREA - WEST CURB AT STAIR A
1 : 5

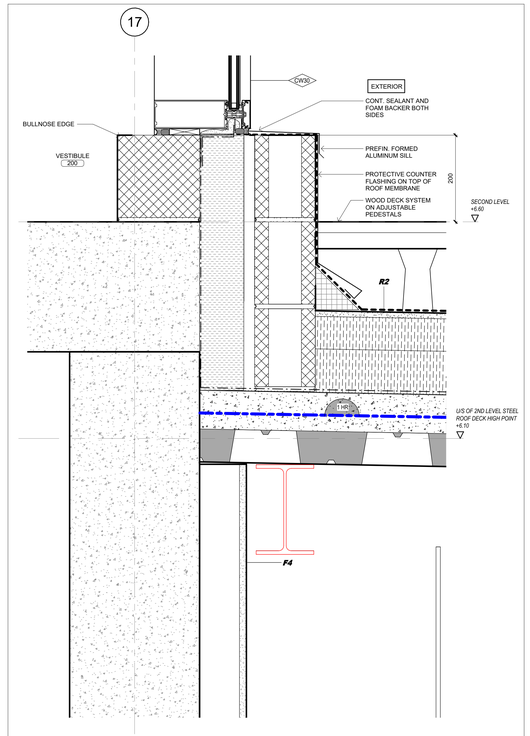

3 A5.12 ROOF PLAY AREA - WEST CURB AT VESTIBULE
1 : 5

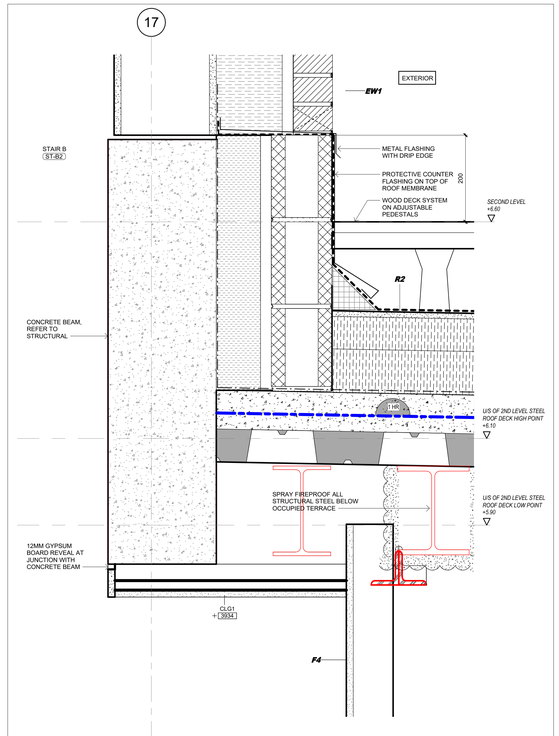

2 A5.12 ROOF PLAY AREA - WEST CURB AT STAIR B
1 : 5

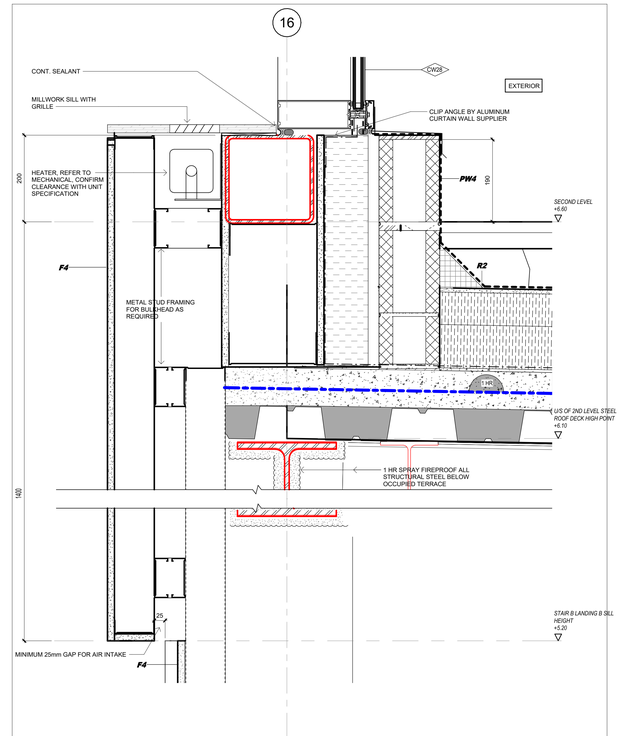

1 A5.12 ROOF PLAY AREA - WEST CURB AT CW
1 : 5

Key to Detail Location

NO. Detail Number
NO. Drawing Number

If this sheet is not 46 7/8" x 33 1/8" (1189 x 841 mm) it is a reduced print - Read dwg. accordingly.

Contractors must check and verify all dimensions on the job and report any discrepancies to the Architect before proceeding with the work.

All prints and specifications are the property of the Architect and must be returned at the completion of the work.

Drawings should not be scaled.

No	Date	Revision/Issued
11	2026 04 10	75% CD FOR CLIENT REVIEW
14	2026 05 15	90% CD FOR CLIENT REVIEW
17	2026 07 27	ISSUED FOR ADDENDA 3

consultants

architect
CS&P Architects Inc.
2345 Yonge St., Suite 200
Toronto, ON, M4P 2E5
Phone.416.482.5002
Fax.416.482.5040

civil engineer
SCS Consulting Group Ltd.
30 Centurian Drive, Suite 100
Markham, ON, L3R 8B8
Phone.905.475.1900
Fax.905.475.8335

structural engineer
LEA Consulting Ltd.
40 University Ave, Suite 503
Toronto, ON, M5J 1T1
Phone.905.470.0015

mechanical engineer
Smith + Andersen
4211 Yonge Street
Toronto, ON, M2P 2A9
Phone.416.487.8151

electrical engineer
Smith + Andersen
4211 Yonge Street
Toronto, ON, M2P 2A9
Phone.416.487.8151

landscape architect
Quinn Design Associates Inc.
180 John Street
Toronto, ON, M5T 1X5
Phone.416.962.8700

SHS CS&P Architects

THE STERLING HALL SCHOOL

99 Cartwright Avenue, Toronto, ON M6A 1V4

EXTERIOR SECTION DETAILS

scale:	1 : 5
date:	10/01/25
drawn:	CS&P
checked by:	CA
project number:	21032
drawing number:	A5.12
	Revision: 17

A0

FILENAME: Autodesk Docs://21032 Sterling Hall/21032_SHS-A-MAIN-25.rvt

DRAWING LAST EDITED: 2026-07-27 4:47:54 PM

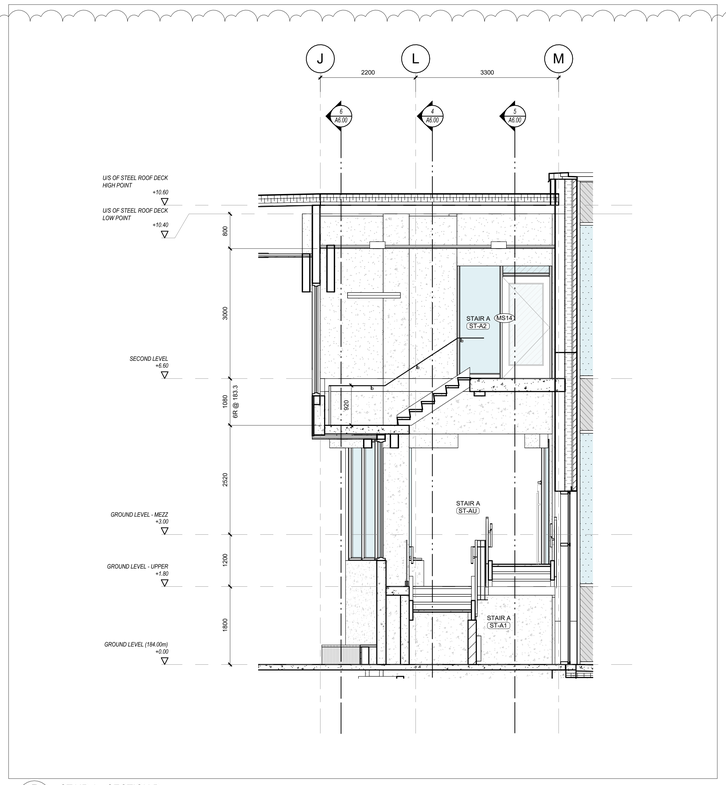

7 A6.00 STAIR A - SECTION D
1 : 50

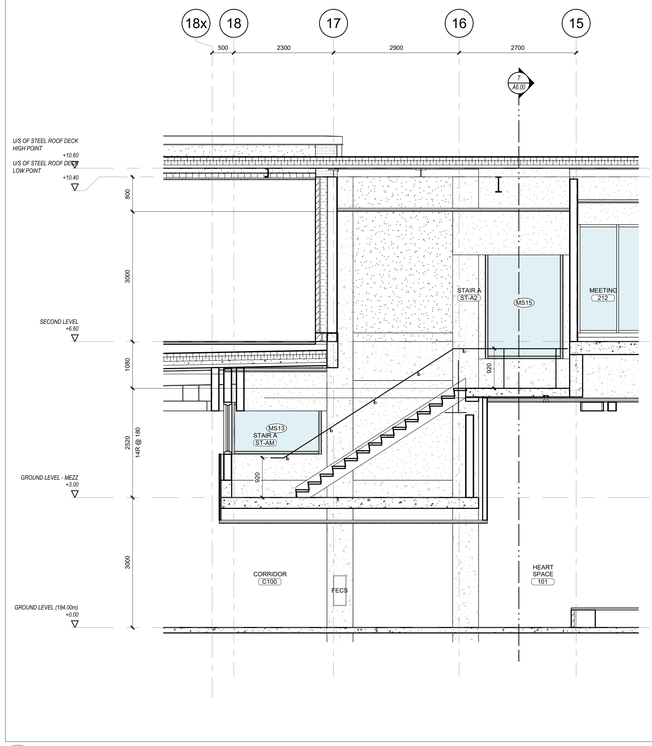

6 A6.00 STAIR A - SECTION C
1 : 50

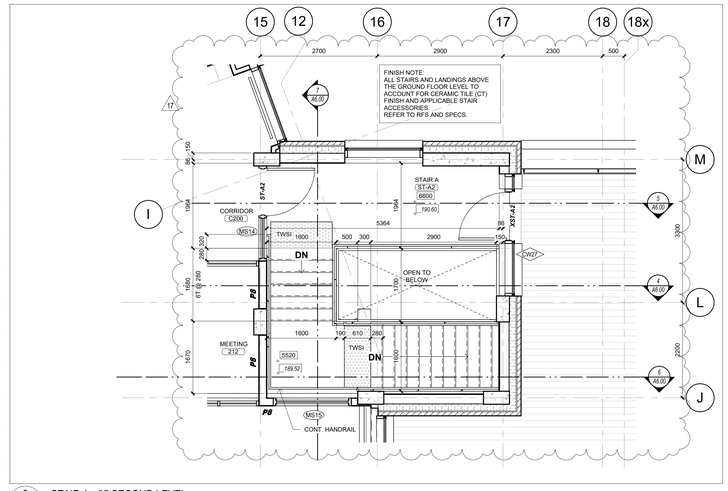

3 A6.00 STAIR A - 05 SECOND LEVEL
1 : 50

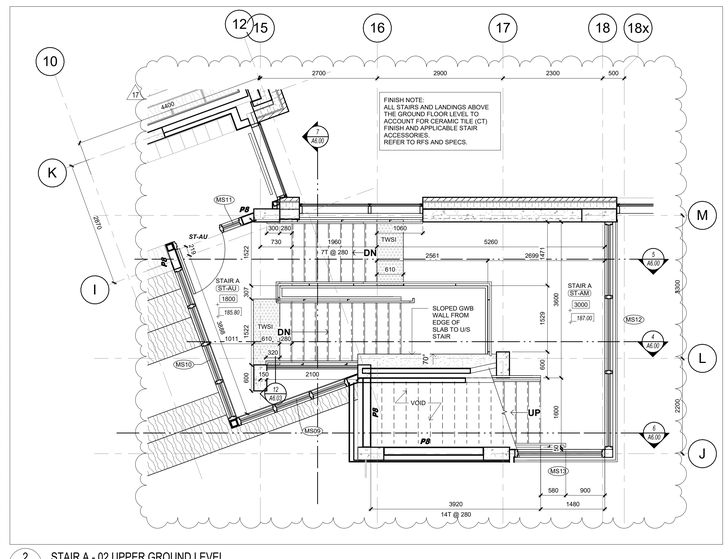

2 A6.00 STAIR A - 02 UPPER GROUND LEVEL
1 : 50

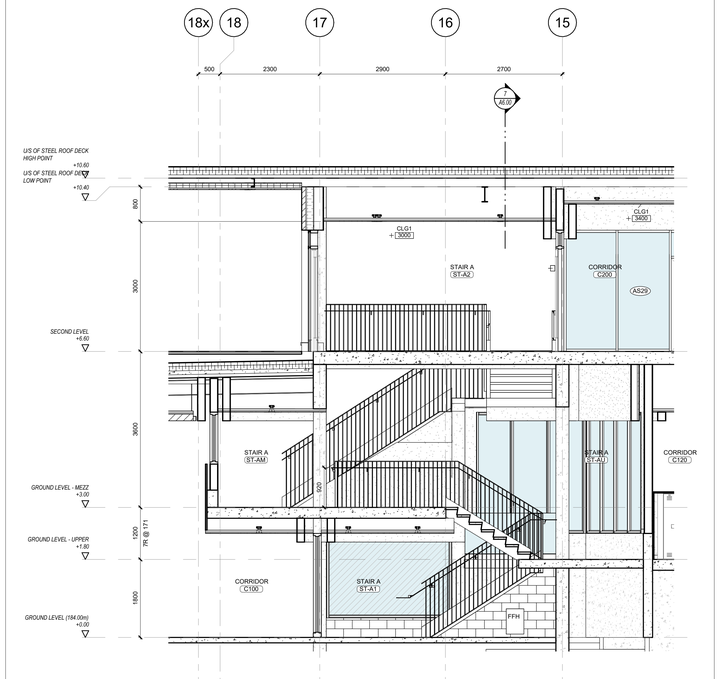

5 A6.00 STAIR A - SECTION B
1 : 50

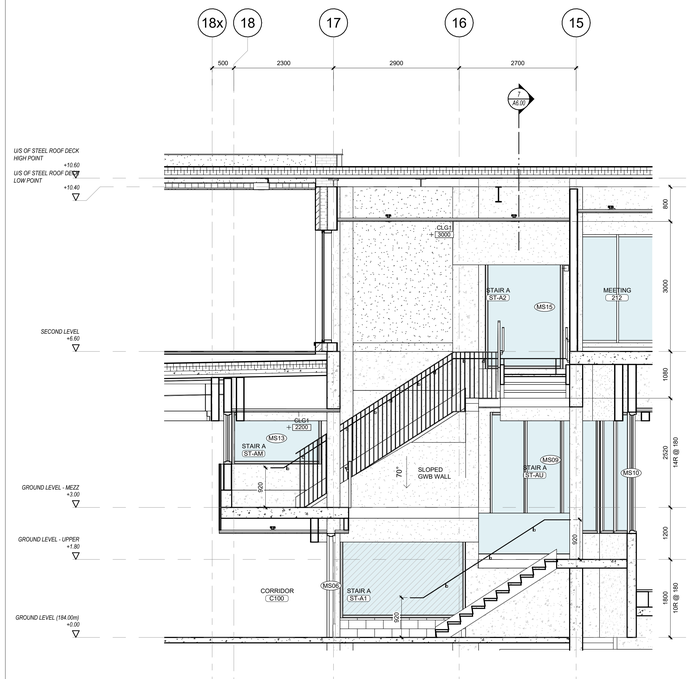

4 A6.00 STAIR A - SECTION A
1 : 50

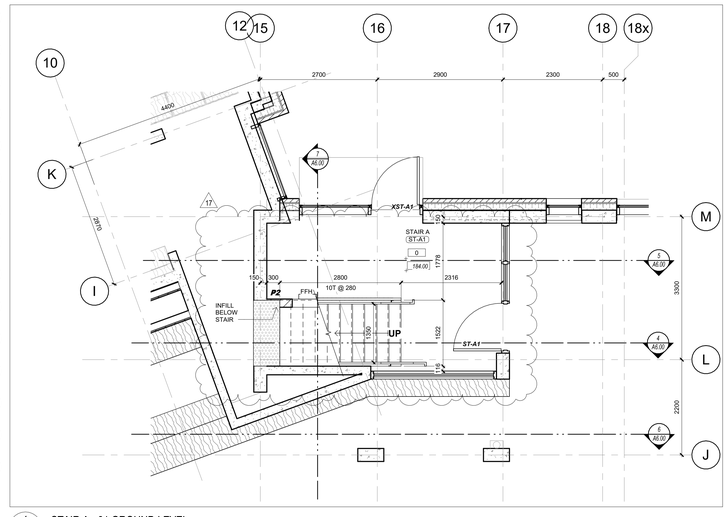

1 A6.00 STAIR A - 01 GROUND LEVEL
1 : 50

Key to Detail Location

NO. Detail Number
NO. Drawing Number

If this sheet is not 46 7/8" x 33 1/8" (1189 x 841 mm) it is a reduced print - Read dwg. accordingly.

Contractors must check and verify all dimensions on the job and report any discrepancies to the Architect before proceeding with the work.

All prints and specifications are the property of the Architect and must be returned at the completion of the work.

Drawings should not be scaled.

No	Date	Revision/Issued
8	2025.11.05	15% CD FOR CLIENT REVIEW
9	2025.12.15	30% CD FOR CLIENT REVIEW
10	2026.03.13	ISSUED FOR PERMIT
11	2026.04.10	75% CD FOR CLIENT REVIEW
14	2026.05.15	90% CD FOR CLIENT REVIEW
15	2026.07.08	ISSUED FOR TENDER
17	2026.07.27	ISSUED FOR ADDENDA 3

consultants

architect CS&P Architects Inc.
2345 Yonge St., Suite 200
Toronto, ON, M4P 2E5
Phone.416.482.5002
Fax.416.482.5040

civil engineer SCS Consulting Group Ltd.
30 Centurian Drive, Suite 100
Markham, ON, L3R 8B8
Phone.905.475.1900
Fax.905.475.8335

structural engineer LEA Consulting Ltd.
40 University Ave, Suite 503
Toronto, ON, M5J 1T1
Phone.905.470.0015

mechanical engineer Smith + Andersen
4211 Yonge Street
Toronto, ON, M2P 2A9
Phone.416.487.8151

electrical engineer Smith + Andersen
4211 Yonge Street
Toronto, ON, M2P 2A9
Phone.416.487.8151

landscape architect Quinn Design Associates Inc.
180 John Street
Toronto, ON, M5T 1X5
Phone.416.962.8700

SHS CS&P Architects

THE STERLING HALL SCHOOL

99 Cartwright Avenue, Toronto, ON M6A 1V4

STAIR A

scale:	1 : 50
date:	06/25/24
drawn:	CS&P
checked by:	CA
project number:	21032
drawing number:	A6.00
	Revision: 17

A0

FILENAME: Autodesk Docs://21032 Sterling Hall/21032_SHS-A-MAIN-25.rvt

DRAWING LAST EDITED: 2026-07-27 4:48:16 PM

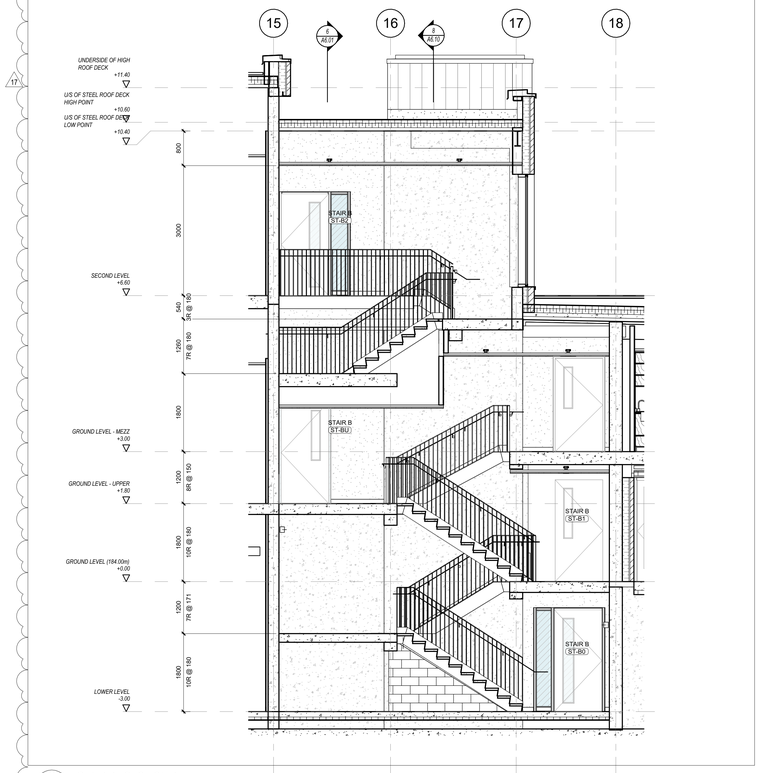

9 A6.01 STAIR B - SECTION D
1 : 50

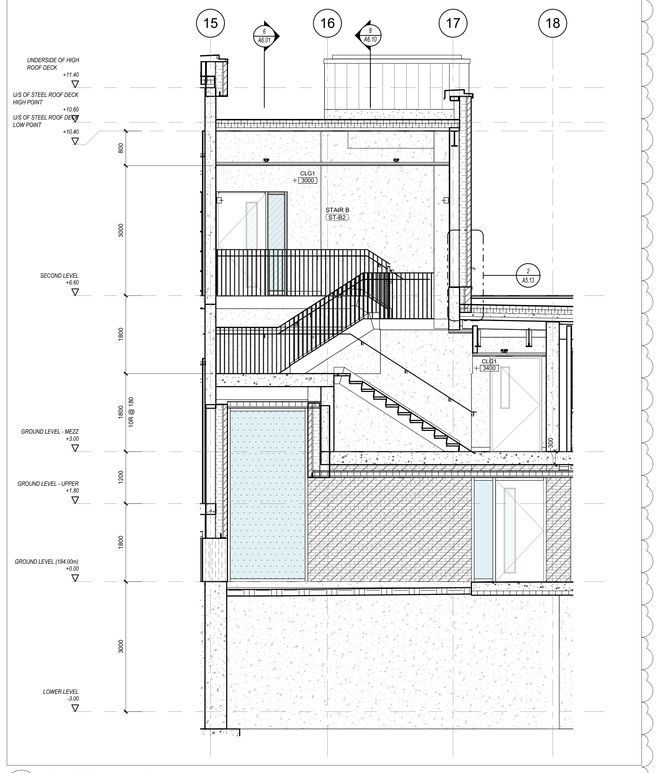

8 A6.01 STAIR B - SECTION C
1 : 50

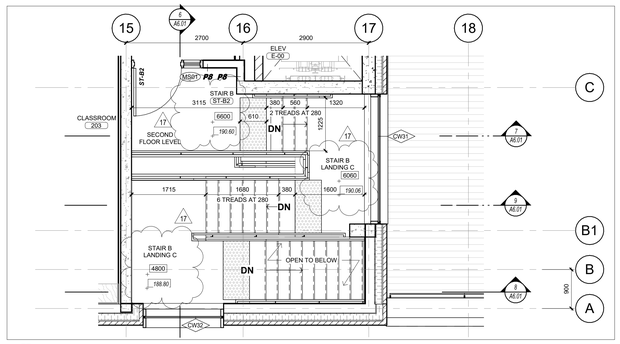

5 A6.01 STAIR B - 05 SECOND LEVEL
1 : 50

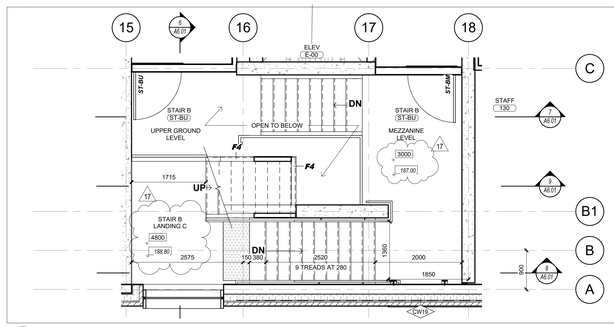

4 A6.01 STAIR B - 04 MEZZANINE LEVEL -
1 : 50

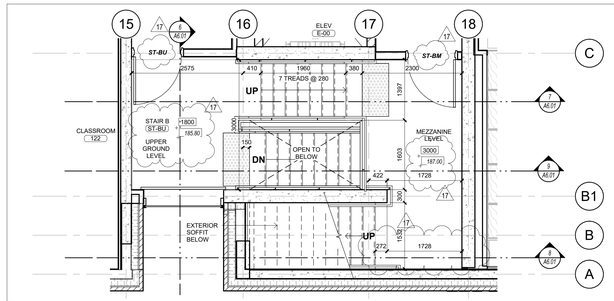

3 A6.01 STAIR B - 02 UPPER GROUND LEVEL
1 : 50

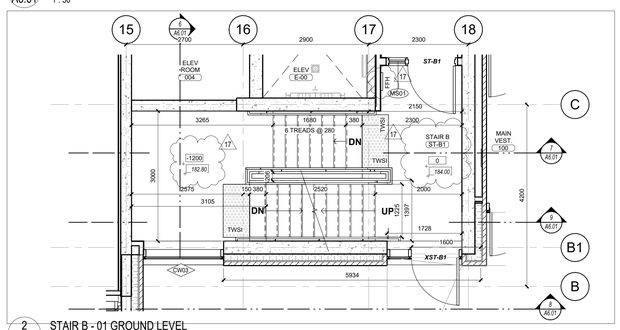

2 A6.01 STAIR B - 01 GROUND LEVEL
1 : 50

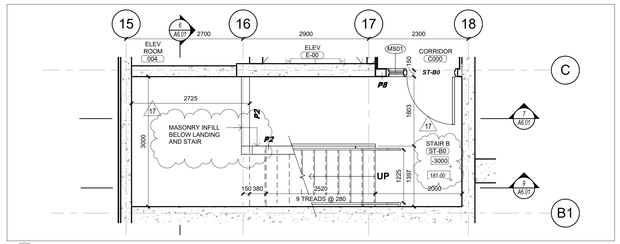

1 A6.01 STAIR B - 00 LOWER LEVEL
1 : 50

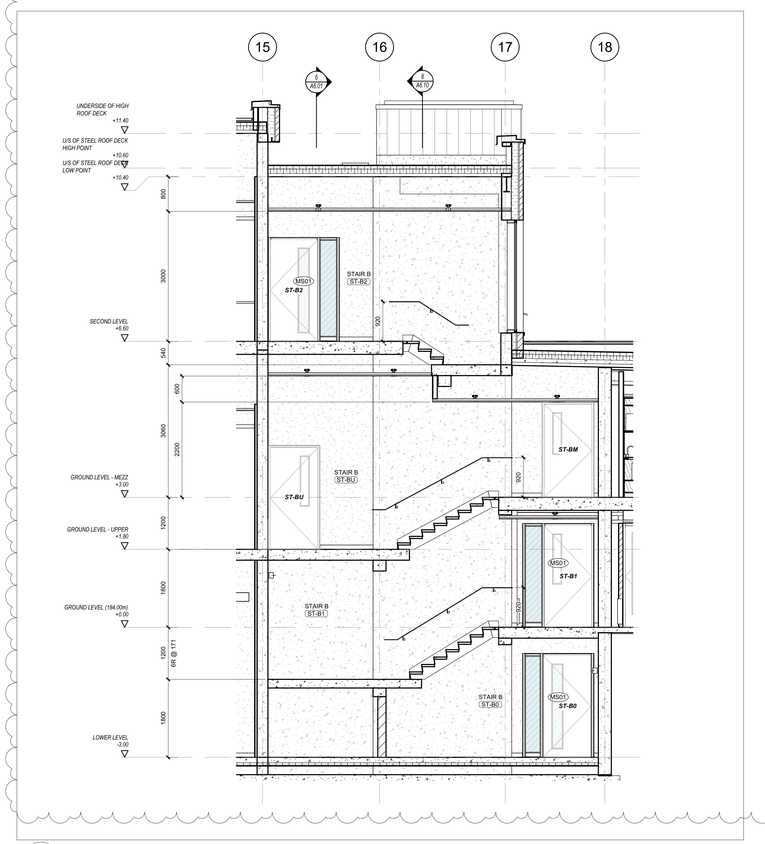

7 A6.01 STAIR B - SECTION B
1 : 50

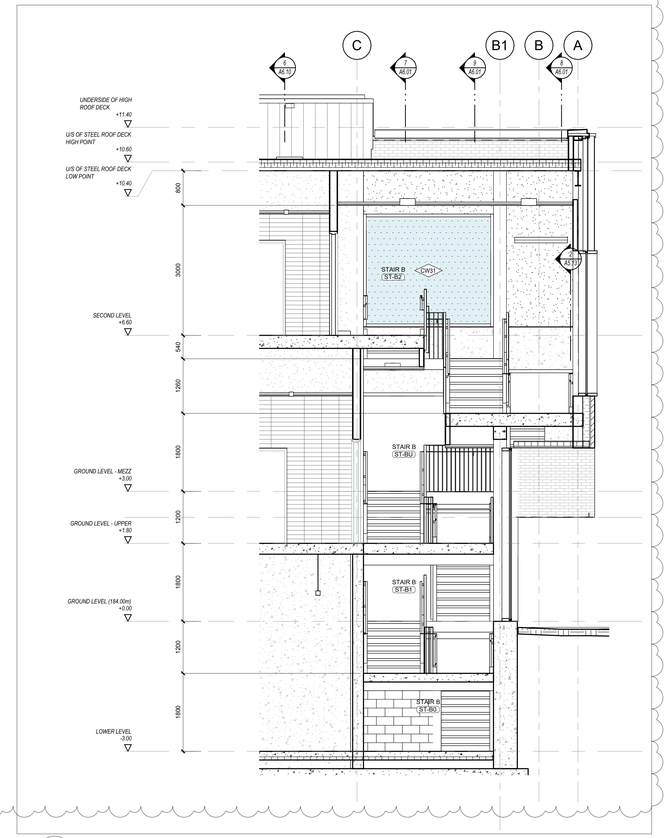

6 A6.01 STAIR B - SECTION A
1 : 50

Key to Detail Location

NO. Detail Number
NO. Drawing Number

If this sheet is not 46.7/8" x 33 1/8" (1189 x 841 mm) it is a reduced print - Read dwg. accordingly.

Contractors must check and verify all dimensions on the job and report any discrepancies to the Architect before proceeding with the work.

All prints and specifications are the property of the Architect and must be returned at the completion of the work.

Drawings should not be scaled.

No	Date	Revision/Issued
8	2025.11.05	15% CD FOR CLIENT REVIEW
9	2025.12.15	30% CD FOR CLIENT REVIEW
10	2026.03.13	ISSUED FOR PERMIT
11	2026.04.10	75% CD FOR CLIENT REVIEW
14	2026.05.15	90% CD FOR CLIENT REVIEW
15	2026.07.08	ISSUED FOR TENDER
17	2026.07.27	ISSUED FOR ADDENDA 3

consultants

architect
CS&P Architects Inc.
2345 Yonge St., Suite 200
Toronto, ON, M4P 2E5
Phone.416.482.5002
Fax.416.482.5040

civil engineer
SCS Consulting Group Ltd.
30 Centurian Drive, Suite 100
Markham, ON, L3R 8B8
Phone.905.475.1900
Fax.905.475.8335

structural engineer
LEA Consulting Ltd.
40 University Ave, Suite 503
Toronto, ON, M5J 1T1
Phone.905.470.0015

mechanical engineer
Smith + Andersen
4211 Yonge Street
Toronto, ON, M2P 2A9
Phone.416.487.8151

electrical engineer
Smith + Andersen
4211 Yonge Street
Toronto, ON, M2P 2A9
Phone.416.487.8151

landscape architect
Quinn Design Associates Inc.
180 John Street
Toronto, ON, M5T 1X5
Phone.416.962.8700

SHS
CS&P Architects

THE STERLING HALL SCHOOL

99 Cartwright Avenue, Toronto, ON M6A 1V4

STAIR B

scale:	1 : 50
date:	03/13/26
drawn:	CS&P
checked by:	CA
project number:	21032
drawing number:	A6.01
Revision:	17

A0

FILENAME: Autodesk Docs://21032 Sterling Hall/21032_SHS-A-MAIN-25.rvt

DRAWING LAST EDITED: 2026-07-27 4:48:24 PM

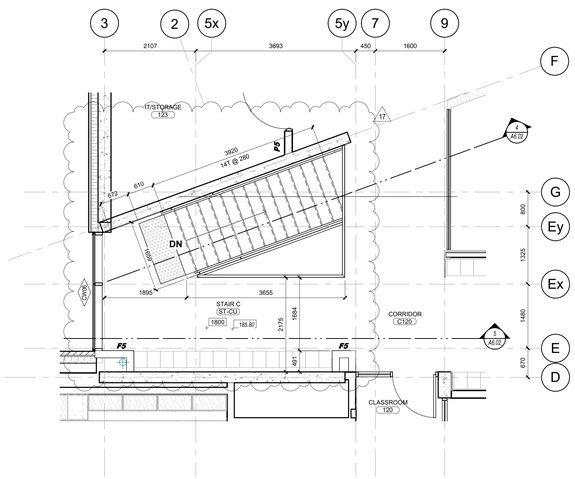

3 A6.02 STAIR C - 02 UPPER GROUND LEVEL
1 : 50

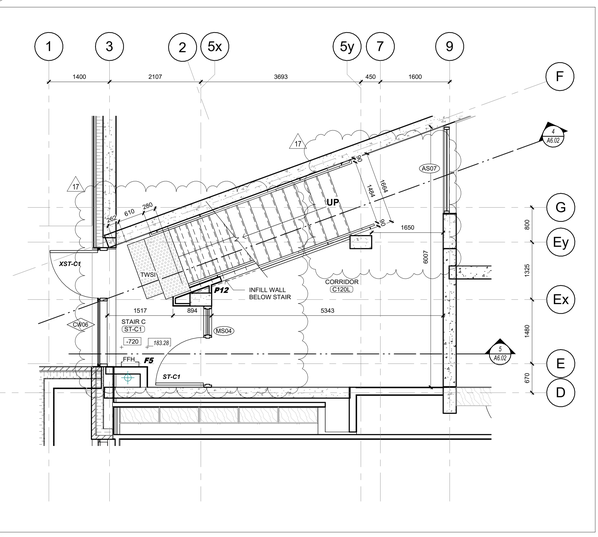

2 A6.02 STAIR C - 01 GROUND LEVEL
1 : 50

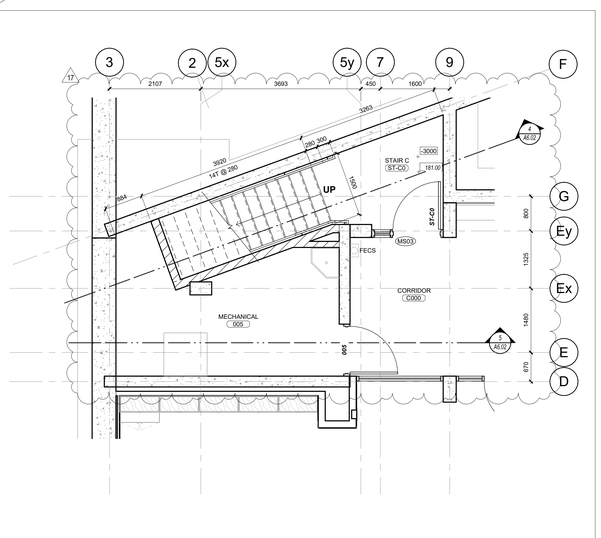

1 A6.02 STAIR C - 00 LOWER LEVEL
1 : 50

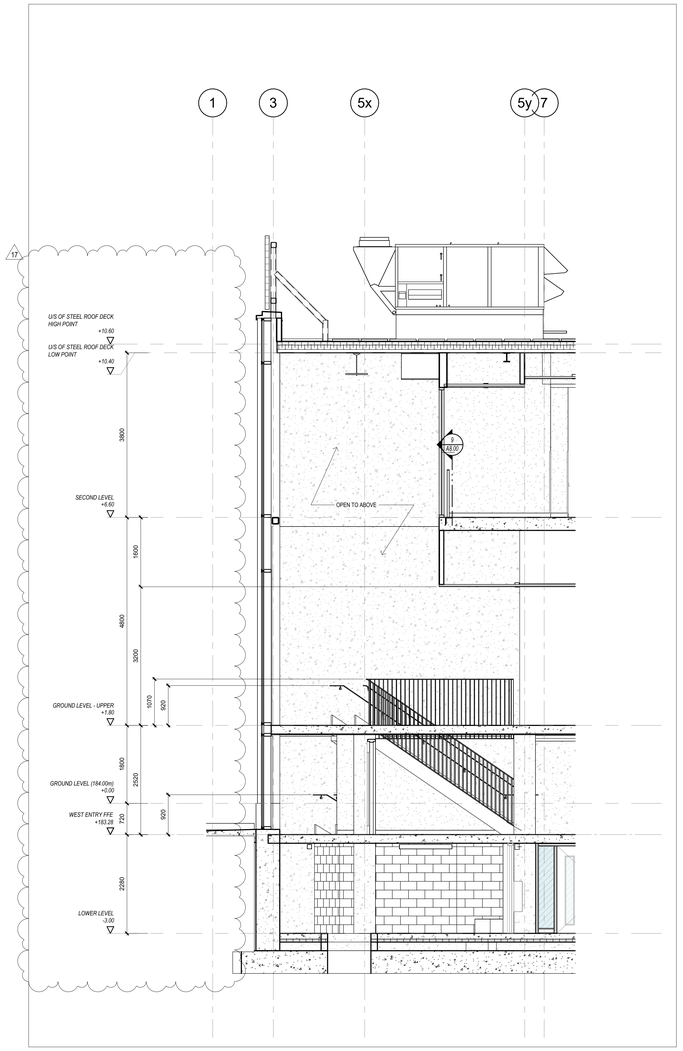

5 A6.02 STAIR C - SECTION C
1 : 50

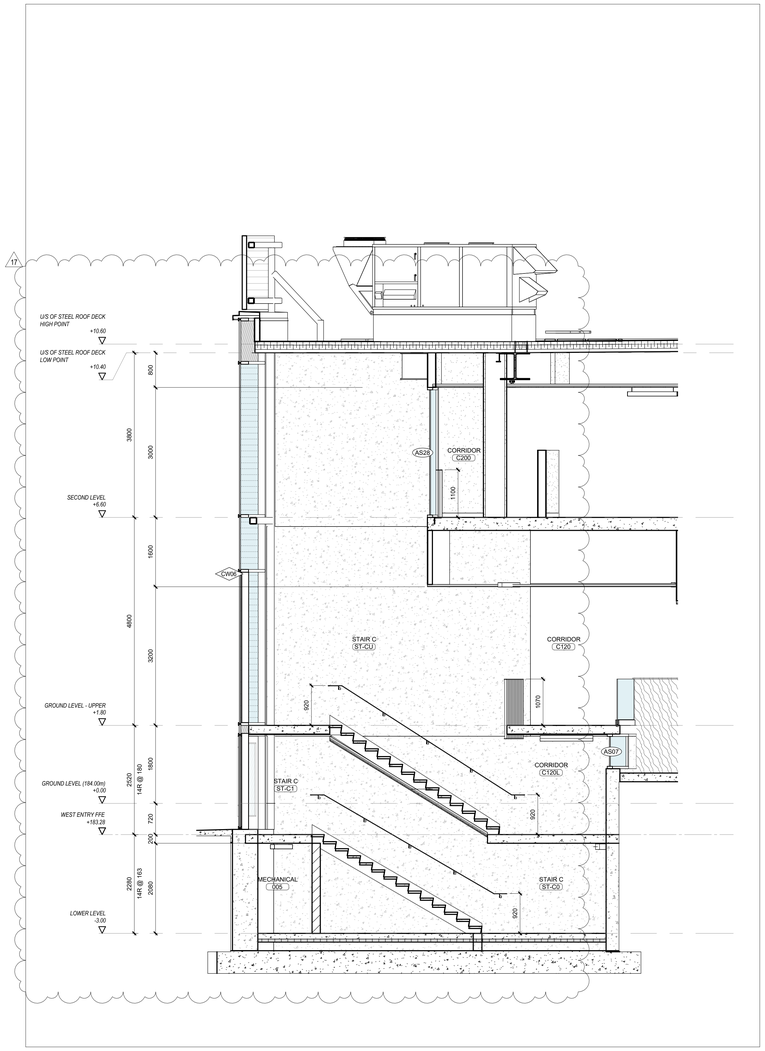

4 A6.02 STAIR C - SECTION A
1 : 50

Key to Detail Location

NO. — Detail Number
NO. — Drawing Number

If this sheet is not 46 7/8" x 33 1/8" (1189 x 841 mm) it is a reduced print - Read dwg. accordingly.

Contractors must check and verify all dimensions on the job and report any discrepancies to the Architect before proceeding with the work.

All prints and specifications are the property of the Architect and must be returned at the completion of the work.

Drawings should not be scaled.

No	Date	Revision/Issued
8	2025.11.05	15% CD FOR CLIENT REVIEW
9	2025.12.15	30% CD FOR CLIENT REVIEW
10	2026.03.13	ISSUED FOR PERMIT
11	2026.04.10	75% CD FOR CLIENT REVIEW
14	2026.05.15	90% CD FOR CLIENT REVIEW
15	2026.07.08	ISSUED FOR TENDER
17	2026.07.27	ISSUED FOR ADDENDA 3

consultants

architect
CS&P Architects Inc.
2345 Yonge St., Suite 200
Toronto, ON, M4P 2E5
Phone.416.482.5002
Fax.416.482.5040

civil engineer
SCS Consulting Group Ltd.
30 Centurian Drive, Suite 100
Markham, ON, L3R 8B8
Phone.905.475.1900
Fax.905.475.8335

structural engineer
LEA Consulting Ltd.
40 University Ave, Suite 503
Toronto, ON, M5J 1T1
Phone.905.470.0015

mechanical engineer
Smith + Andersen
4211 Yonge Street
Toronto, ON, M2P 2A9
Phone.416.487.8151

electrical engineer
Smith + Andersen
4211 Yonge Street
Toronto, ON, M2P 2A9
Phone.416.487.8151

landscape architect
Quinn Design Associates Inc.
180 John Street
Toronto, ON, M5T 1X5
Phone.416.962.8700

SHS
CS&P Architects

THE STERLING HALL SCHOOL

99 Cartwright Avenue, Toronto, ON M6A 1V4

STAIR C

scale:	1 : 50
date:	06/25/24
drawn:	CS&P
checked by:	CA
project number:	21032
drawing number:	A6.02
Revision:	17

A0

FILENAME: Autodesk Docs://21032 Sterling Hall/21032_SHS-A-MAIN-25.rvt

DRAWING LAST EDITED: 2026-07-27 4:48:29 PM

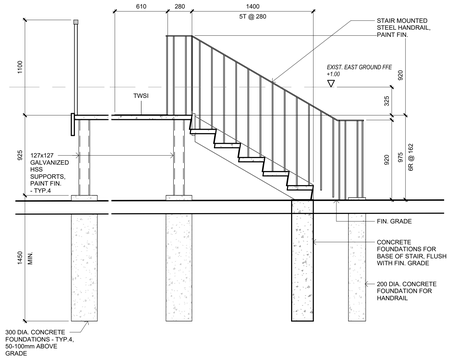

13 A6.03 SECTION OF EXTERIOR STAIR AT DEMOLISHED PORTABLE
1 : 25

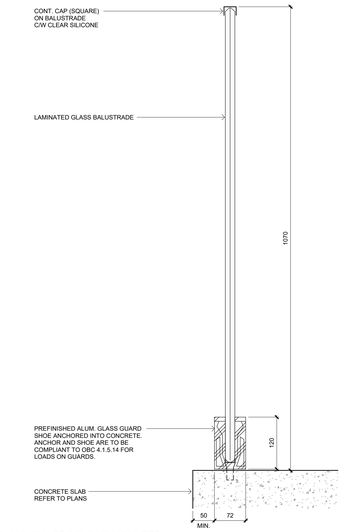

12 A6.03 GLASS GUARDS FLOOR MOUNTED
1 : 5

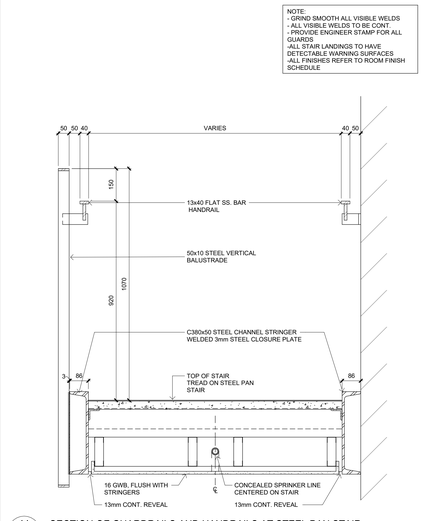

11 A6.03 SECTION OF GUARDRAILS AND HANDRAILS AT STEEL PAN STAIR
1 : 10

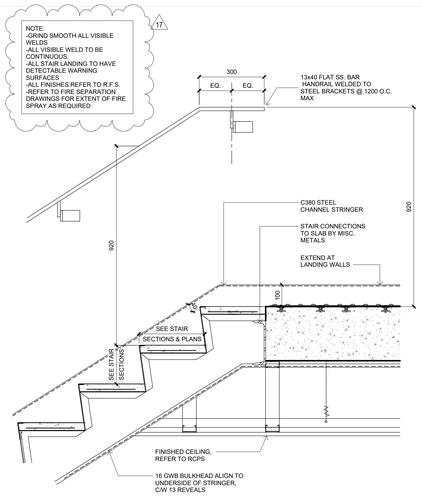

10 A6.03 UPPER LANDING AT TOP OF STAIR AND WALL MOUNT HANDRAIL
1 : 10

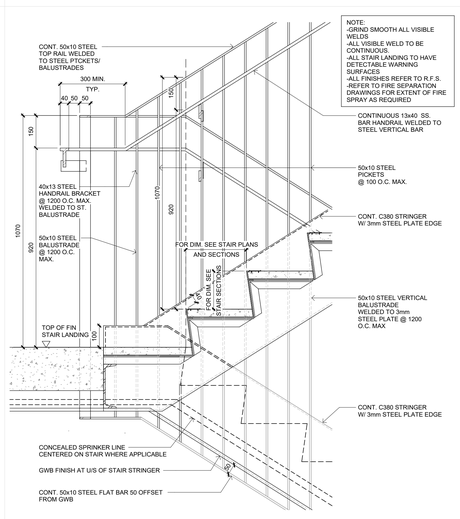

9 A6.03 MID LANDING AT STEEL PAN STAIR
1 : 10

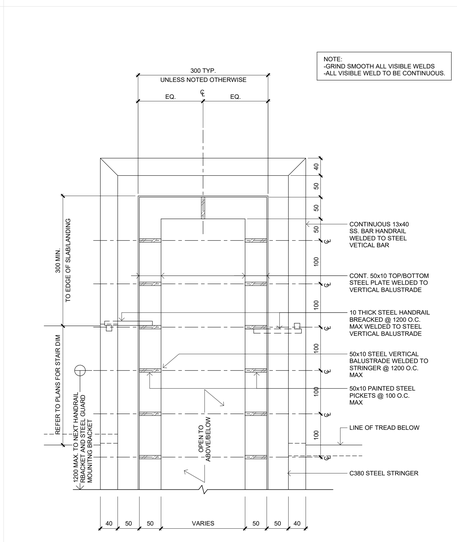

8 A6.03 MID LANDING AT STEEL PAN STAIR PLAN DETAIL
1 : 5

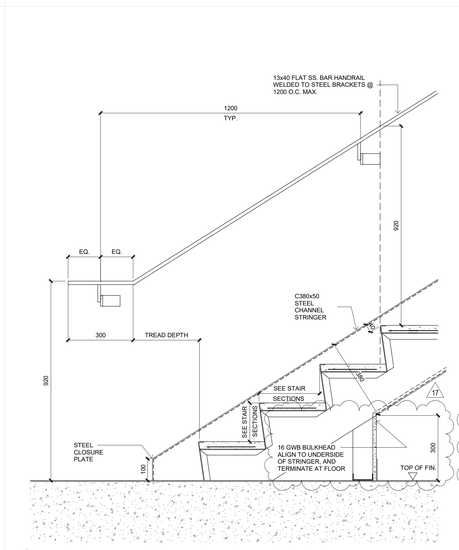

7 A6.03 BOTTOM OF STEEL PAN STAIR AND WALL MOUNT HANDRAIL
1 : 10

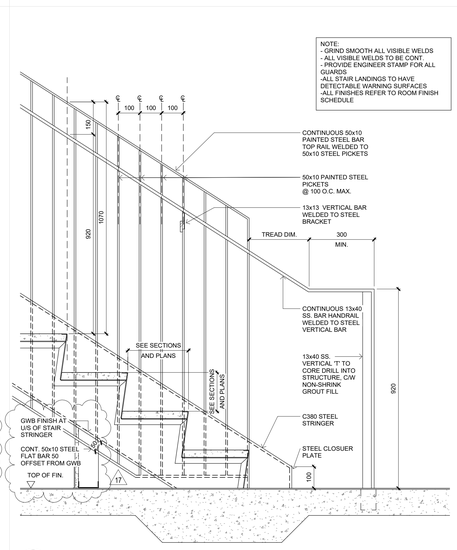

6 A6.03 HANDRAIL DETAIL AT BOTTOM OF STEEL PAN STAIR
1 : 10

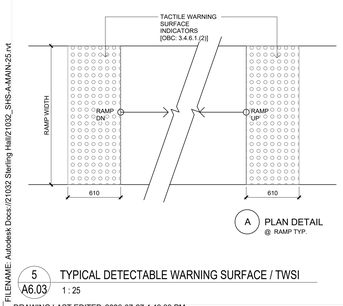

5 A6.03 TYPICAL DETECTABLE WARNING SURFACE / TWSI
1 : 25

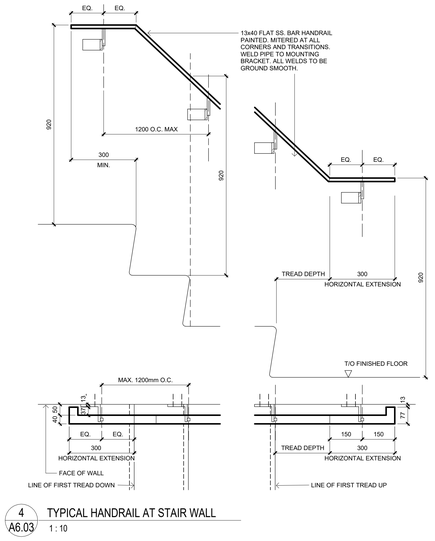

4 A6.03 TYPICAL HANDRAIL AT STAIR WALL
1 : 10

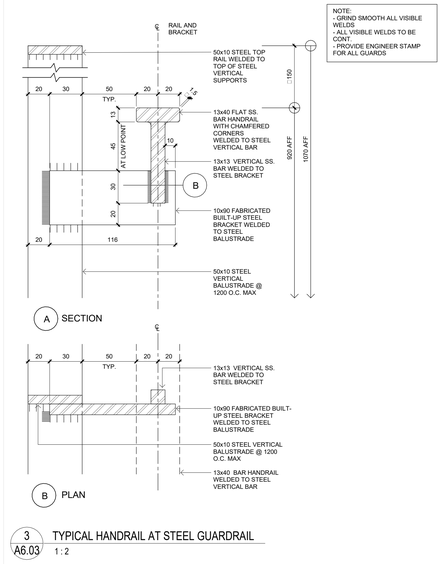

3 A6.03 TYPICAL HANDRAIL AT STEEL GUARDRAIL
1 : 2

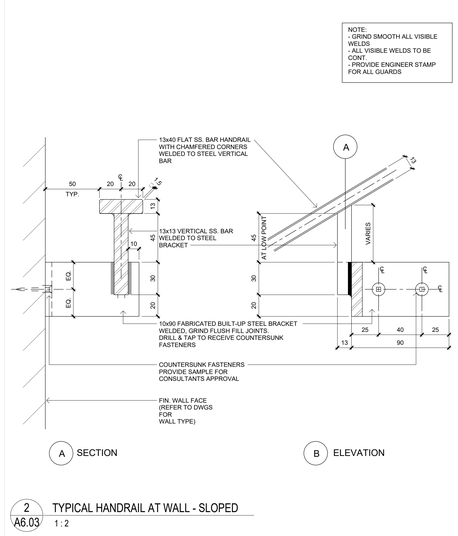

2 A6.03 TYPICAL HANDRAIL AT WALL - SLOPED
1 : 2

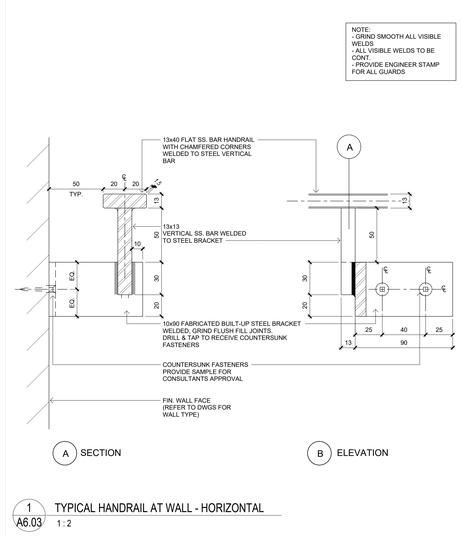

1 A6.03 TYPICAL HANDRAIL AT WALL - HORIZONTAL
1 : 2

Key to Detail Location

NO. / NO. — Detail Number / Drawing Number

If this sheet is not 46 7/8" x 33 1/8" (1189 x 841 mm) it is a reduced print - Read dwg. accordingly.

Contractors must check and verify all dimensions on the job and report any discrepancies to the Architect before proceeding with the work.

All prints and specifications are the property of the Architect and must be returned at the completion of the work.

Drawings should not be scaled.

No	Date	Revision/Issued
10	2026 03 13	ISSUED FOR PERMIT
11	2026 04 10	75% CD FOR CLIENT REVIEW
14	2026 05 15	90% CD FOR CLIENT REVIEW
15	2026 07 08	ISSUED FOR TENDER
16	2026 07 17	ISSUED FOR ADDENDA 1
17	2026 07 27	ISSUED FOR ADDENDA 3

consultants

architect — CS&P Architects Inc., 2345 Yonge St., Suite 200, Toronto, ON, M4P 2E5, Phone.416.482.5002, Fax.416.482.5040

civil engineer — SCS Consulting Group Ltd., 30 Centurian Drive, Suite 100, Markham, ON, L3R 8B8, Phone.905.475.1900, Fax.905.475.8335

structural engineer — LEA Consulting Ltd., 40 University Ave, Suite 503, Toronto, ON, M5J 1T1, Phone.905.470.0015

mechanical engineer — Smith + Andersen, 4211 Yonge Street, Toronto, ON, M2P 2A9, Phone.416.487.8151

electrical engineer — Smith + Andersen, 4211 Yonge Street, Toronto, ON, M2P 2A9, Phone.416.487.8151

landscape architect — Quinn Design Associates Inc., 180 John Street, Toronto, ON, M5T 1X5, Phone.416.962.8700

PROJECT NORTH — N

SHS CS&P Architects

THE STERLING HALL SCHOOL

99 Cartwright Avenue, Toronto, ON M6A 1V4

STAIR DETAILS

scale:	As indicated
date:	10/16/20
drawn:	CS&P
checked by:	CA
project number:	21032
drawing number:	A6.03
Revision:	17

A0

FILENAME: Autodesk Docs://21032 Sterling Hall/21032_SHS-A-MAIN-25.rvt

DRAWING LAST EDITED: 2026-07-27 4:48:33 PM

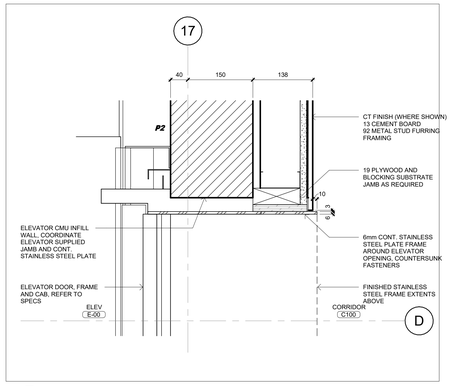

9 A6.10 PLAN DETAIL - ELEVATOR JAMB AT GROUND FLOOR
1 : 5

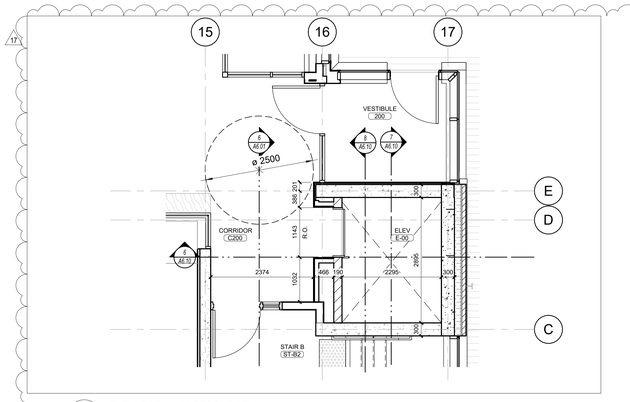

5 A6.10 ELEVATOR 1 - 05 SECOND LEVEL
1 : 50

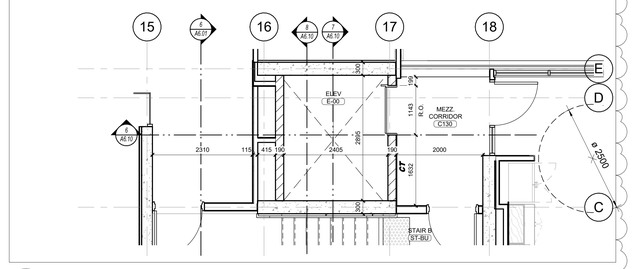

4 A6.10 ELEVATOR - 04 MEZZANINE LEVEL
1 : 50

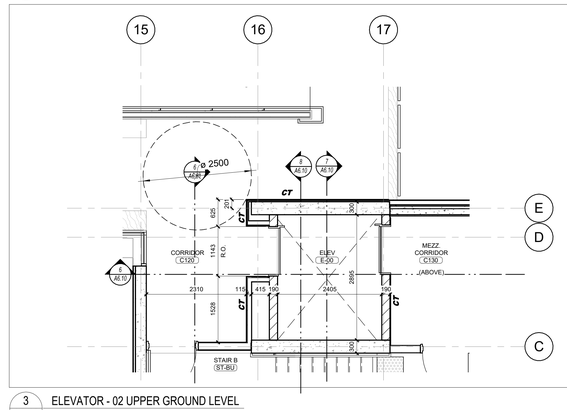

3 A6.10 ELEVATOR - 02 UPPER GROUND LEVEL
1 : 50

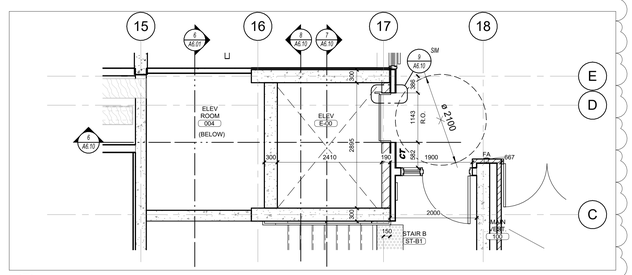

2 A6.10 ELEVATOR - 01 GROUND LEVEL
1 : 50

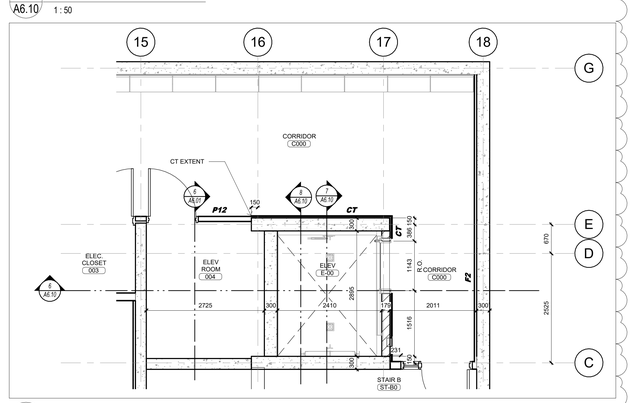

1 A6.10 ELEVATOR - 00 LOWER LEVEL
1 : 50

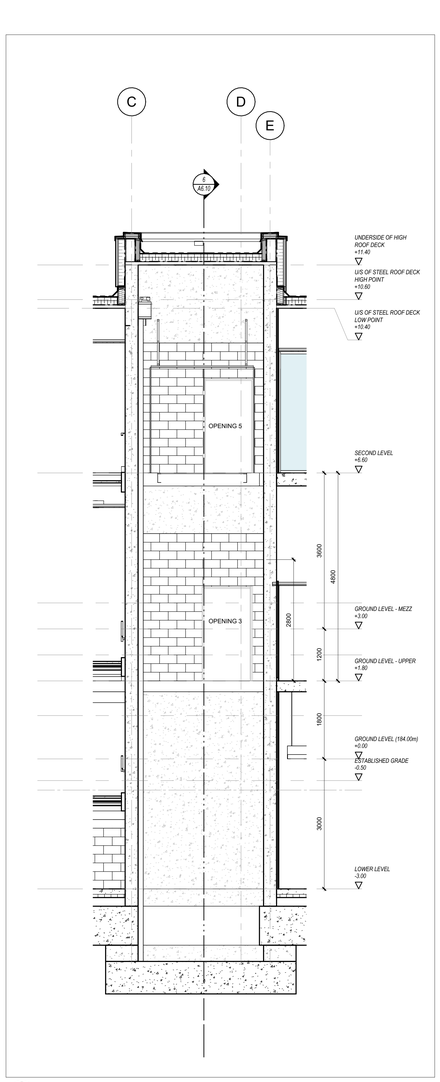

8 A6.10 ELEVATOR - SECTION C
1 : 50

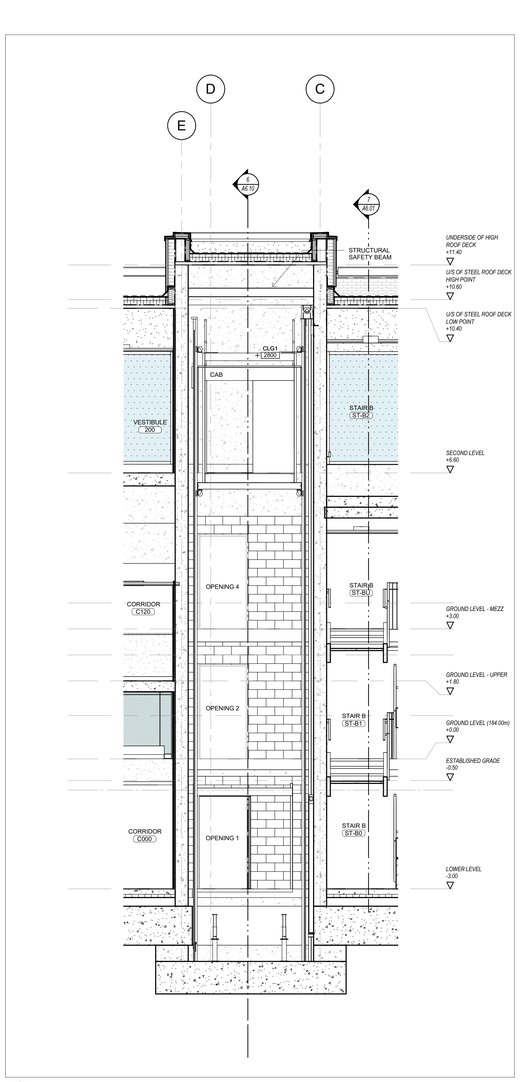

7 A6.10 ELEVATOR - SECTION B
1 : 50

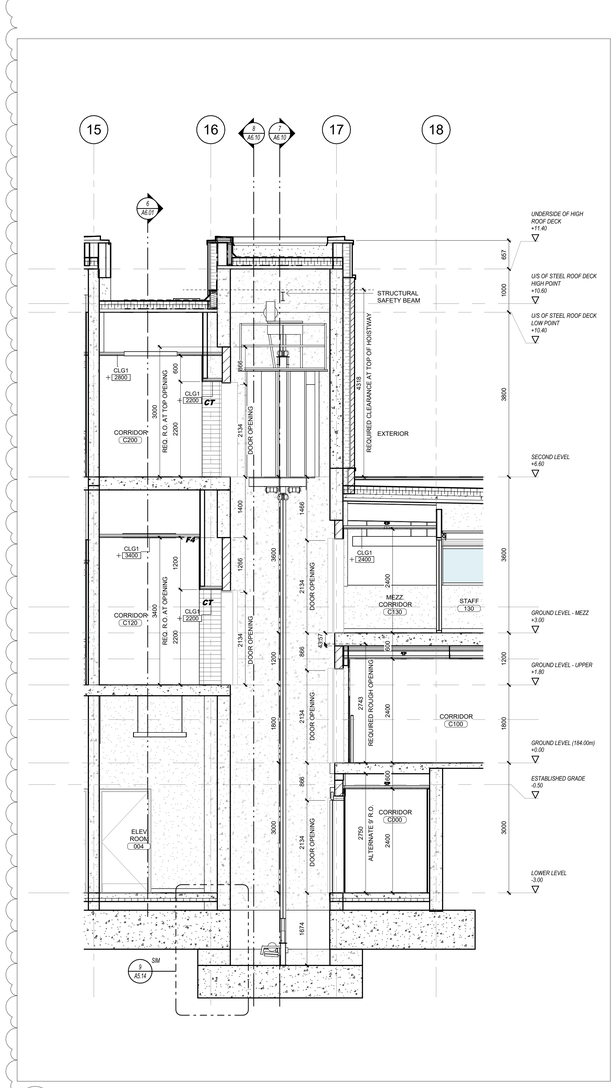

6 A6.10 ELEVATOR - SECTION A
1 : 50

Key to Detail Location

NO. — Detail Number
NO. — Drawing Number

If this sheet is not 46 7/8" x 33 1/8" (1189 x 841 mm) it is a reduced print - Read dwg. accordingly.

Contractors must check and verify all dimensions on the job and report any discrepancies to the Architect before proceeding with the work.

All prints and specifications are the property of the Architect and must be returned at the completion of the work.

Drawings should not be scaled.

No	Date	Revision/Issued
9	2025 12 15	30% CD FOR CLIENT REVIEW
10	2026 03 13	ISSUED FOR PERMIT
11	2026 04 10	75% CD FOR CLIENT REVIEW
14	2026 05 15	90% CD FOR CLIENT REVIEW
15	2026 07 08	ISSUED FOR TENDER
17	2026 07 27	ISSUED FOR ADDENDA 3

consultants

architect — CS&P Architects Inc., 2345 Yonge St., Suite 200, Toronto, ON, M4P 2E5, Phone.416.482.5002, Fax.416.482.5040

civil engineer — SCS Consulting Group Ltd., 30 Centurian Drive, Suite 100, Markham, ON, L3R 8B8, Phone.905.475.1900, Fax.905.475.8335

structural engineer — LEA Consulting Ltd., 40 University Ave, Suite 503, Toronto, ON, M5J 1T1, Phone.905.470.0015

mechanical engineer — Smith + Andersen, 4211 Yonge Street, Toronto, ON, M2P 2A9, Phone.416.487.8151

electrical engineer — Smith + Andersen, 4211 Yonge Street, Toronto, ON, M2P 2A9, Phone.416.487.8151

landscape architect — Quinn Design Associates Inc., 180 John Street, Toronto, ON, M5T 1X5, Phone.416.962.8700

SHS CS&P Architects

THE STERLING HALL SCHOOL

99 Cartwright Avenue, Toronto, ON M6A 1V4

ELEVATOR

scale:	As indicated
date:	10/16/20
drawn:	CS&P
checked by:	CA
project number:	21032
drawing number:	A6.10
	Revision: 17

A0

FILENAME: Autodesk Docs://21032 Sterling Hall/21032_SHS-A-MAIN-25.rvt

DRAWING LAST EDITED: 2026-07-27 4:48:39 PM

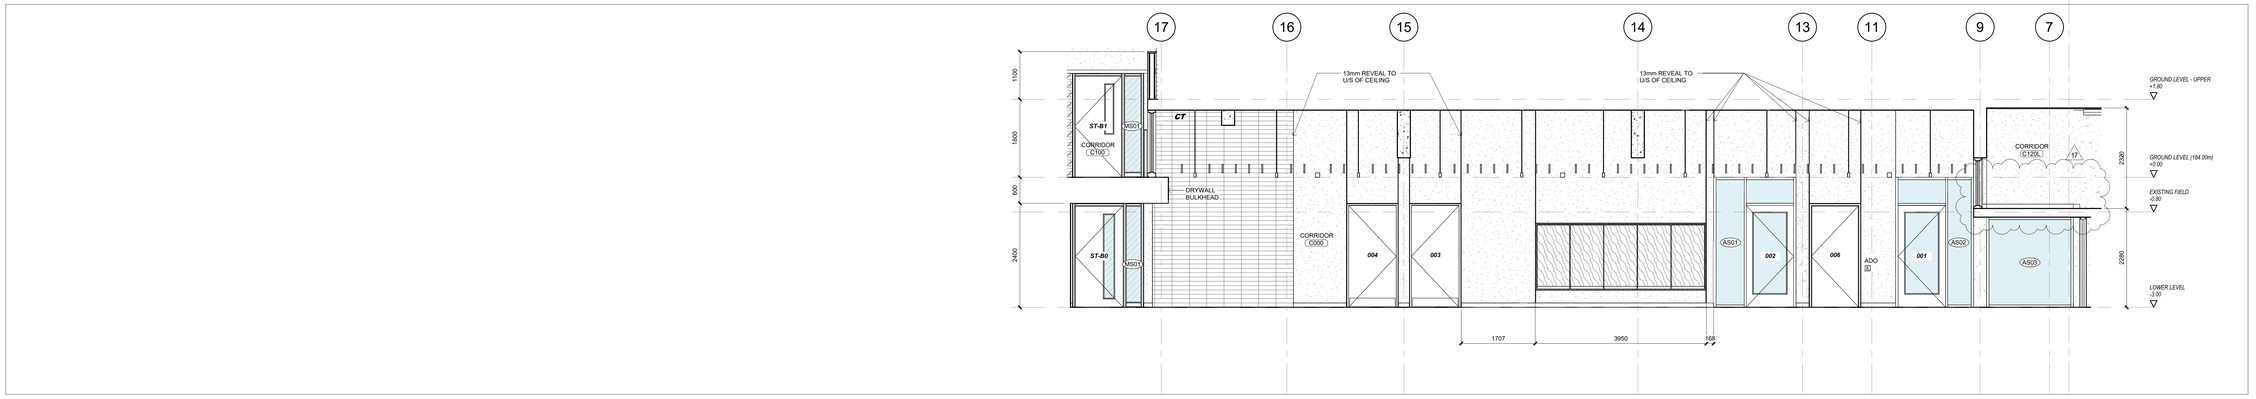

11 A7.10 CORRIDOR C000
1 : 50

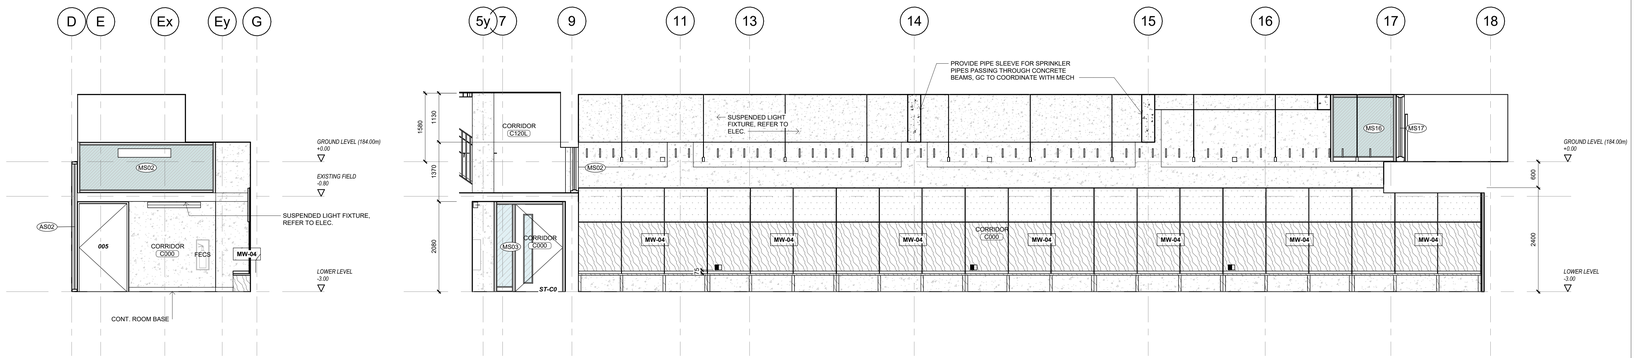

10 A7.10 CORRIDOR C000
1 : 50

9 A7.10 CORRIDOR C000
1 : 50

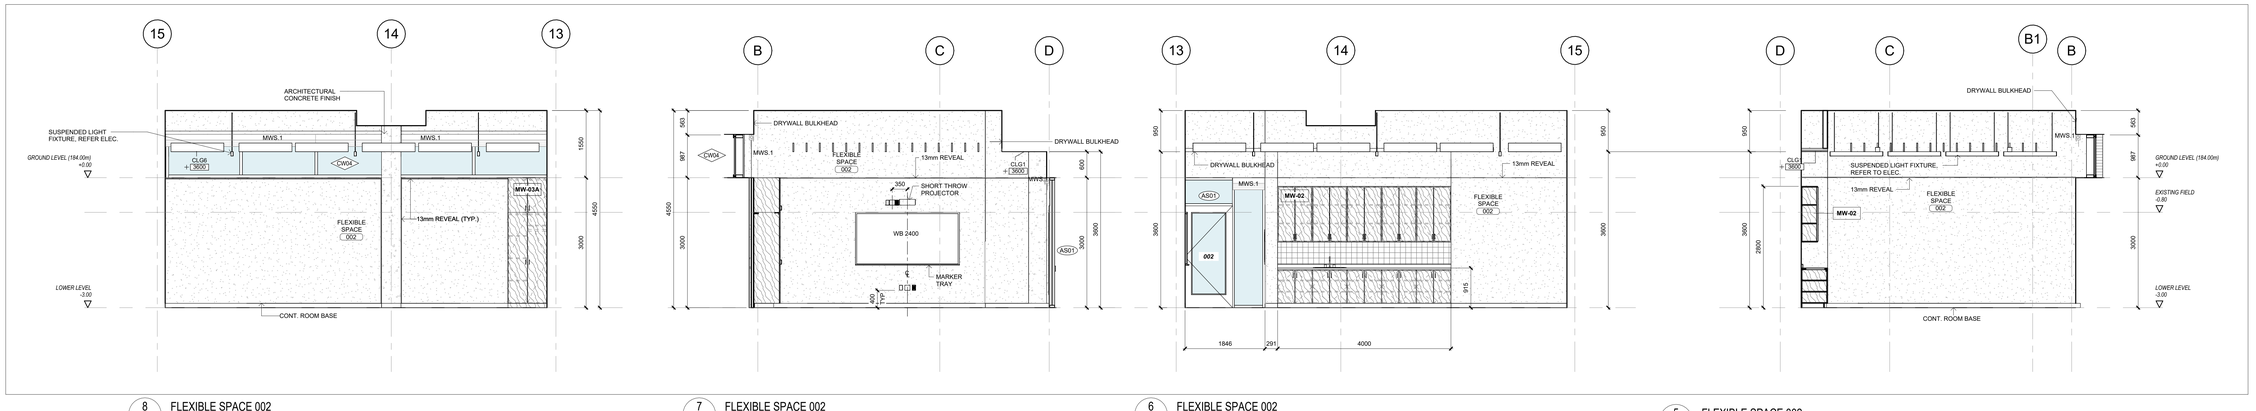

8 A7.10 FLEXIBLE SPACE 002
1 : 50

7 A7.10 FLEXIBLE SPACE 002
1 : 50

6 A7.10 FLEXIBLE SPACE 002
1 : 50

5 A7.10 FLEXIBLE SPACE 002
1 : 50

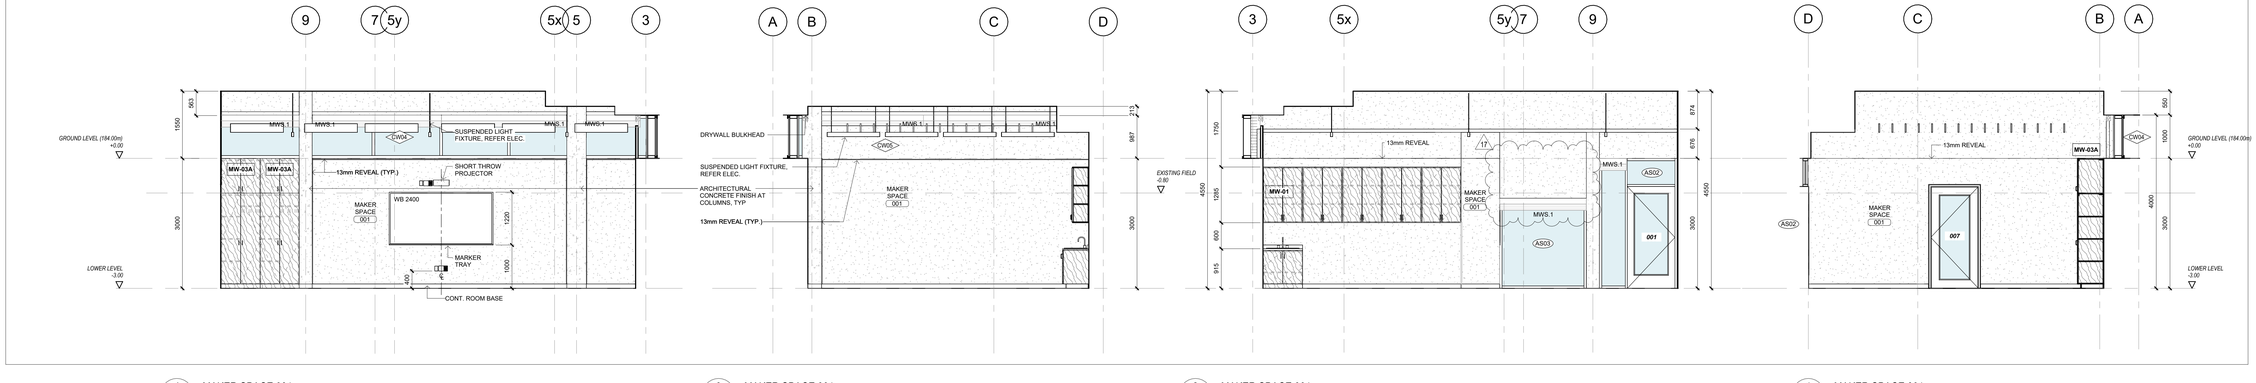

4 A7.10 MAKER SPACE 001
1 : 50

3 A7.10 MAKER SPACE 001
1 : 50

2 A7.10 MAKER SPACE 001
1 : 50

1 A7.10 MAKER SPACE 001
1 : 50

A0

FILENAME: Autodesk Docs://21032 Sterling Hall/21032_SHS-A-MAIN-25.rvt

DRAWING LAST EDITED: 2026-07-27 4:48:47 PM

Key to Detail Location

NO. Detail Number
NO. Drawing Number

If this sheet is not 46 7/8" x 33 1/8" (1189 x 841 mm) it is a reduced print - Read dwg. accordingly.

Contractors must check and verify all dimensions on the job and report any discrepancies to the Architect before proceeding with the work.

All prints and specifications are the property of the Architect and must be returned at the completion of the work.

Drawings should not be scaled.

No	Date	Revision/Issued
9	2025 12 15	30% CD FOR CLIENT REVIEW
11	2026 04 10	75% CD FOR CLIENT REVIEW
14	2026 05 15	90% CD FOR CLIENT REVIEW
15	2026 07 08	ISSUED FOR TENDER
17	2026 07 27	ISSUED FOR ADDENDA 3

consultants

architect
CS&P Architects Inc.
2345 Yonge St., Suite 200
Toronto, ON, M4P 2E5
Phone.416.482.5002
Fax.416.482.5040

civil engineer
SCS Consulting Group Ltd.
30 Centurian Drive, Suite 100
Markham, ON, L3R 8B8
Phone.905.475.1900
Fax.905.475.8335

structural engineer
LEA Consulting Ltd.
40 University Ave, Suite 503
Toronto, ON, M5J 1T1
Phone.905.470.0015

mechanical engineer
Smith + Andersen
4211 Yonge Street
Toronto, ON, M2P 2A9
Phone.416.487.8151

electrical engineer
Smith + Andersen
4211 Yonge Street
Toronto, ON, M2P 2A9
Phone.416.487.8151

landscape architect
Quinn Design Associates Inc.
180 John Street
Toronto, ON, M5T 1X5
Phone.416.962.8700

PROJECT NORTH

SHS CS&P Architects

THE STERLING HALL SCHOOL

99 Cartwright Avenue, Toronto, ON M6A 1V4

INTERIOR ELEVATIONS

scale:	1 : 50
date:	10/09/25
drawn:	CS&P
checked by:	CA
project number:	21032
drawing number:	A7.10
Revision:	17

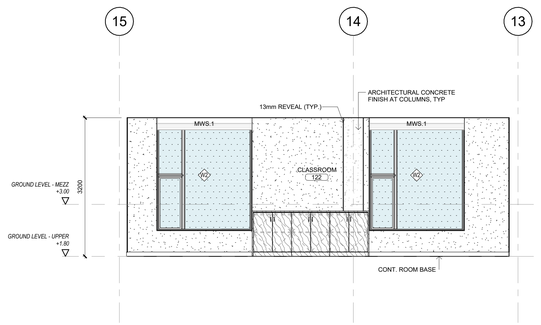

10 A7.12 CLASSROOM 122
1 : 50

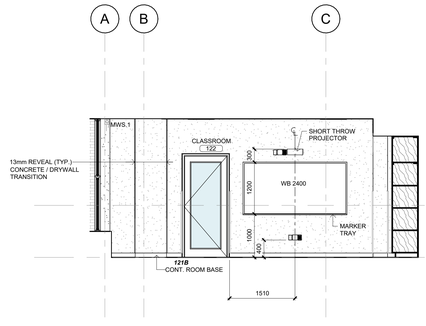

9 A7.12 CLASSROOM 122
1 : 50

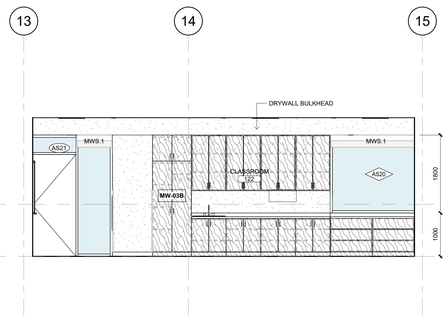

8 A7.12 CLASSROOM 122
1 : 50

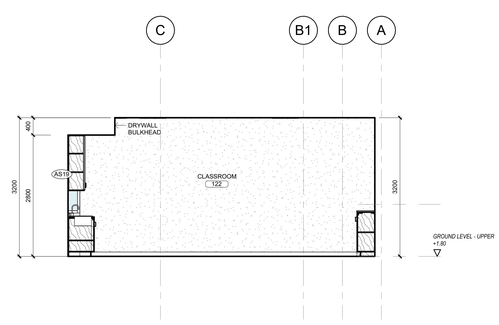

7 A7.12 CLASSROOM 122
1 : 50

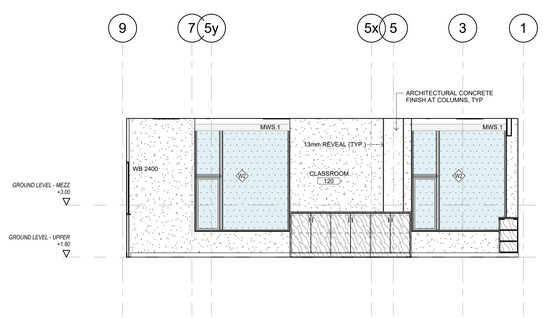

6 A7.12 CLASSROOM 120
1 : 50

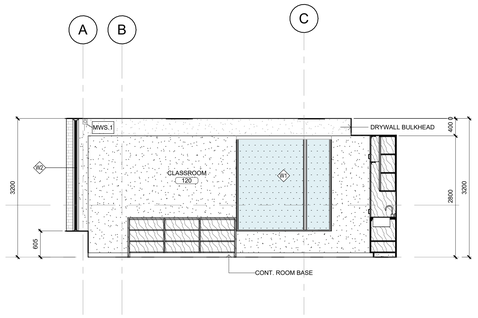

5 A7.12 CLASSROOM 120
1 : 50

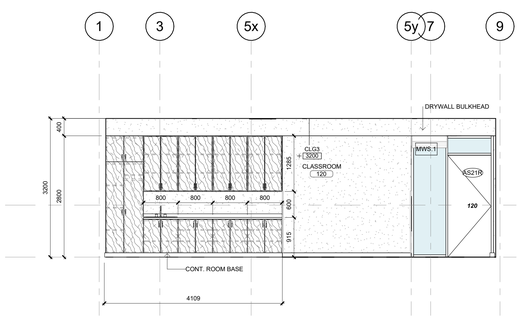

4 A7.12 CLASSROOM 120
1 : 50

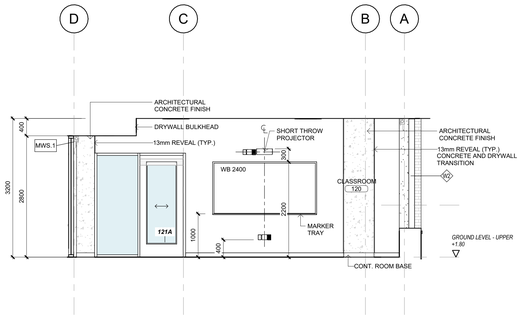

3 A7.12 CLASSROOM 120
1 : 50

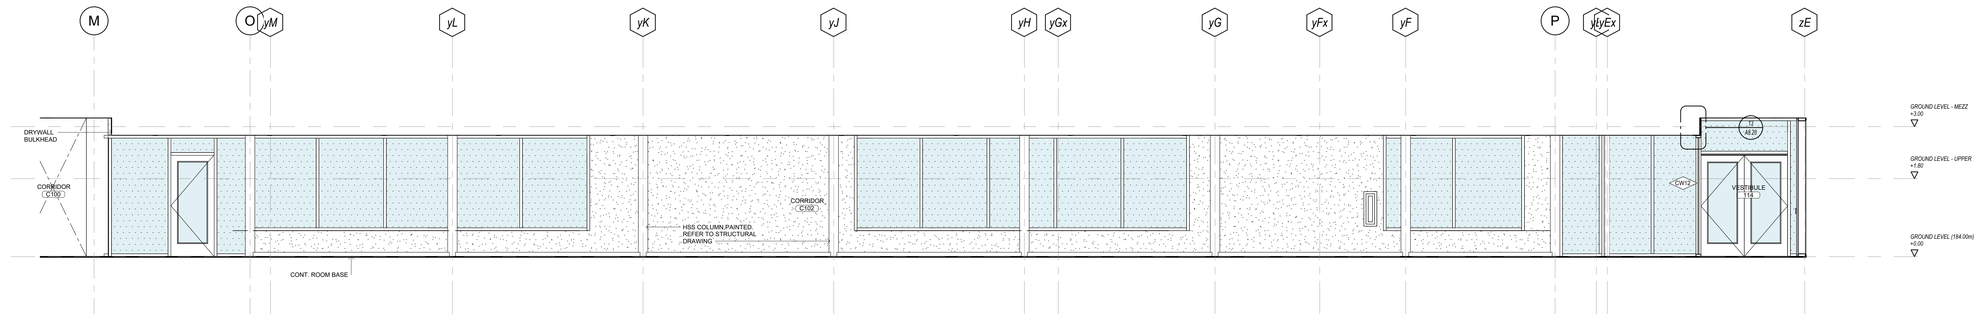

2 A7.12 CORRIDOR C102
1 : 50

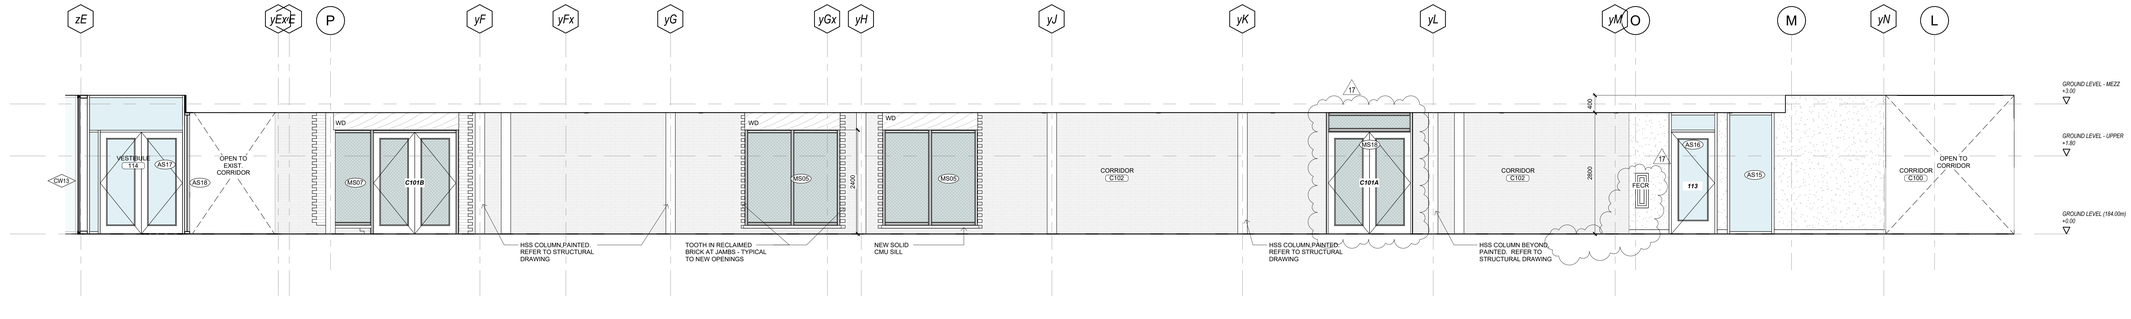

1 A7.12 CORRIDOR C102
1 : 50

A0

FILENAME: Autodesk Docs://21032 Sterling Hall/21032_SHS-A-MAIN-25.rvt

DRAWING LAST EDITED: 2026-07-27 4:48:53 PM

Key to Detail Location

NO. — Detail Number
NO. — Drawing Number

If this sheet is not 46 7/8" x 33 1/8" (1189 x 841 mm) it is a reduced print - Read dwg. accordingly.

Contractors must check and verify all dimensions on the job and report any discrepancies to the Architect before proceeding with the work.

All prints and specifications are the property of the Architect and must be returned at the completion of the work.

Drawings should not be scaled.

No	Date	Revision/Issued
9	2025 12 15	30% CD FOR CLIENT REVIEW
11	2026 04 10	75% CD FOR CLIENT REVIEW
14	2026 05 15	90% CD FOR CLIENT REVIEW
15	2026 07 08	ISSUED FOR TENDER
17	2026 07 27	ISSUED FOR ADDENDA 3

consultants

architect — CS&P Architects Inc.
2345 Yonge St., Suite 200
Toronto, ON, M4P 2E5
Phone.416.482.5002
Fax.416.482.5040

civil engineer — SCS Consulting Group Ltd.
30 Centurian Drive, Suite 100
Markham, ON, L3R 8B8
Phone.905.475.1900
Fax.905.475.8335

structural engineer — LEA Consulting Ltd.
40 University Ave, Suite 503
Toronto, ON, M5J 1T1
Phone.905.470.0015

mechanical engineer — Smith + Andersen
4211 Yonge Street
Toronto, ON, M2P 2A9
Phone.416.487.8151

electrical engineer — Smith + Andersen
4211 Yonge Street
Toronto, ON, M2P 2A9
Phone.416.487.8151

landscape architect — Quinn Design Associates Inc.
180 John Street
Toronto, ON, M5T 1X5
Phone.416.962.8700

PROJECT NORTH

SHS CS&P Architects

THE STERLING HALL SCHOOL

99 Cartwright Avenue, Toronto, ON M6A 1V4

INTERIOR ELEVATIONS

scale:	1 : 50
date:	10/09/25
drawn:	CS&P
checked by:	CA
project number:	21032
drawing number:	A7.12
Revision:	17

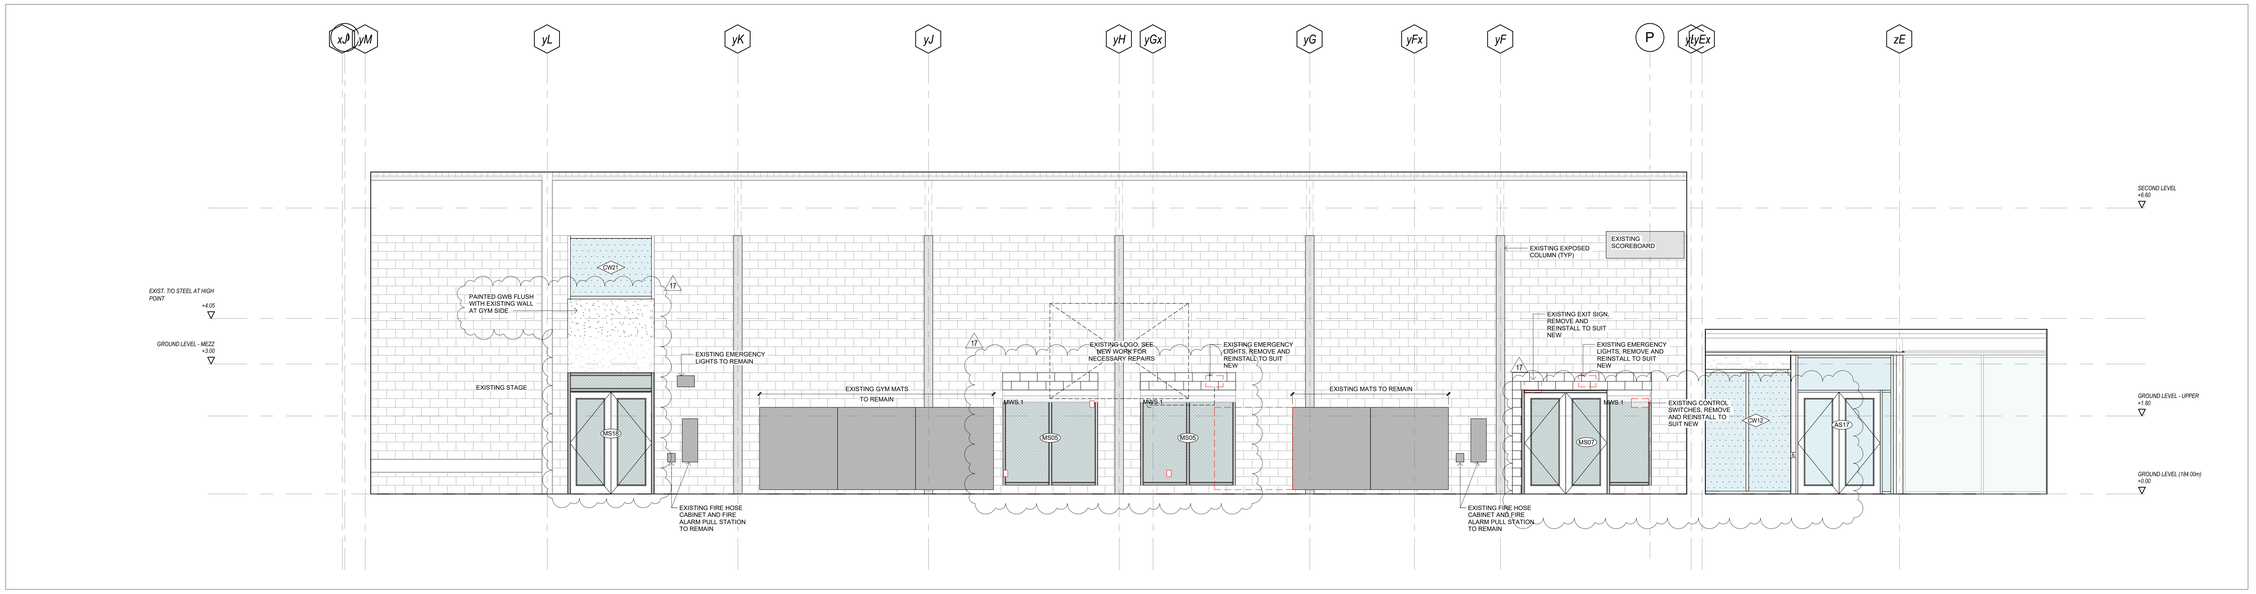

5 A7.15 EXISTING GYM - WEST WALL
1 : 50

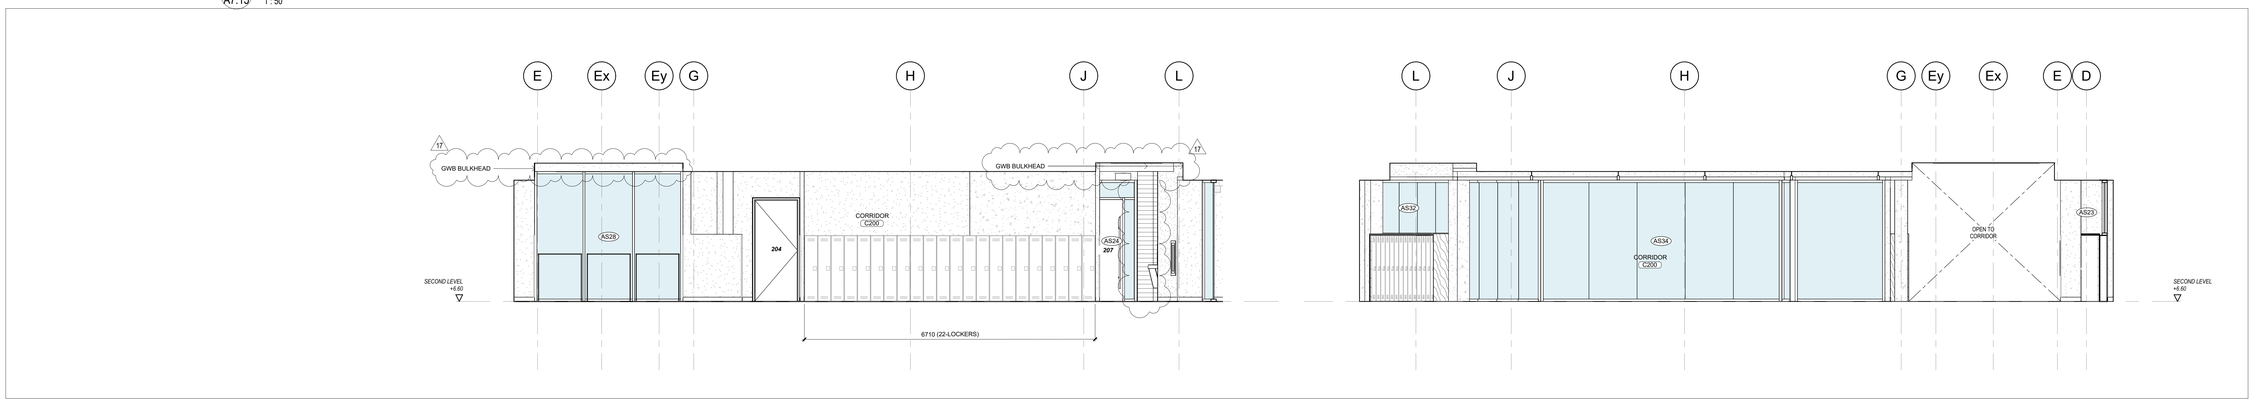

4 A7.15 CORRIDOR C200
1 : 50

3 A7.15 CORRIDOR C200
1 : 50

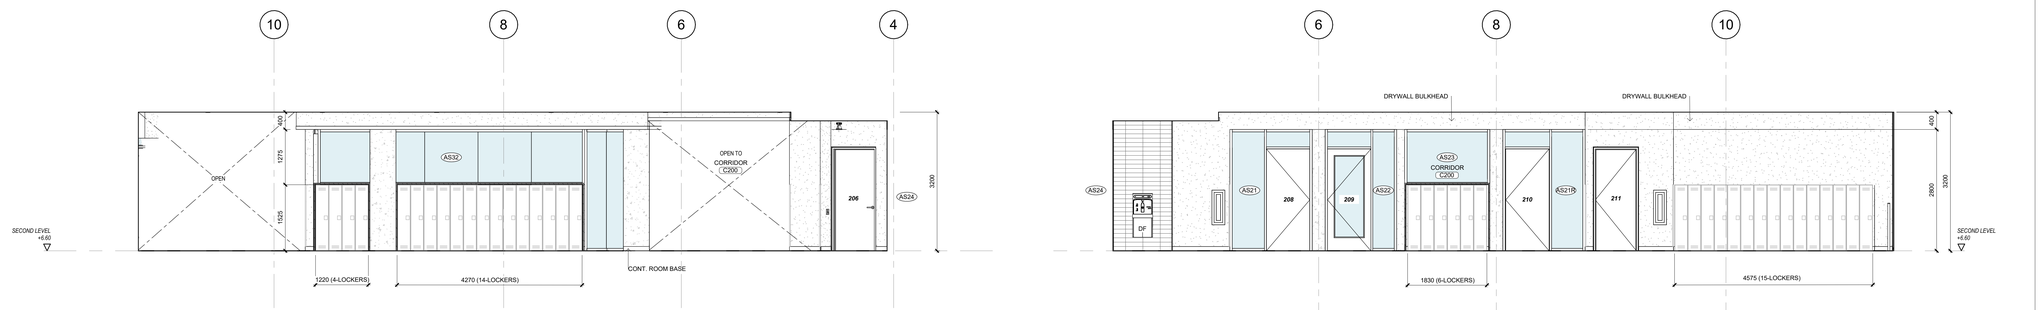

2 A7.15 CORRIDOR C200
1 : 50

1 A7.15 CORRIDOR C200
1 : 50

Key to Detail Location

NO. (Detail Number)
NO. (Drawing Number)

If this sheet is not 46 7/8" x 33 1/8" (1189 x 841 mm) it is a reduced print - Read dwg. accordingly.

Contractors must check and verify all dimensions on the job and report any discrepancies to the Architect before proceeding with the work.

All prints and specifications are the property of the Architect and must be returned at the completion of the work.

Drawings should not be scaled.

No	Date	Revision/Issued
11	2026 04 10	75% CD FOR CLIENT REVIEW
14	2026 05 15	90% CD FOR CLIENT REVIEW
15	2026 07 08	ISSUED FOR TENDER
16	2026 07 17	ISSUED FOR ADDENDA 1
17	2026 07 27	ISSUED FOR ADDENDA 3

consultants

architect — CS&P Architects Inc.
2345 Yonge St., Suite 200
Toronto, ON, M4P 2E5
Phone.416.482.5002
Fax.416.482.5040

civil engineer — SCS Consulting Group Ltd.
30 Centurian Drive, Suite 100
Markham, ON, L3R 8B8
Phone.905.475.1900
Fax.905.475.8335

structural engineer — LEA Consulting Ltd.
40 University Ave, Suite 503
Toronto, ON, M5J 1T1
Phone.905.470.0015

mechanical engineer — Smith + Andersen
4211 Yonge Street
Toronto, ON, M2P 2A9
Phone.416.487.8151

electrical engineer — Smith + Andersen
4211 Yonge Street
Toronto, ON, M2P 2A9
Phone.416.487.8151

landscape architect — Quinn Design Associates Inc.
180 John Street
Toronto, ON, M5T 1X5
Phone.416.962.8700

PROJECT NORTH

SHS CS&P Architects

THE STERLING HALL SCHOOL

99 Cartwright Avenue, Toronto, ON M6A 1V4

INTERIOR ELEVATIONS

scale:	1 : 50
date:	10/09/25
drawn:	CS&P
checked by:	CA
project number:	21032
drawing number:	A7.15
Revision:	17

A0

FILENAME: Autodesk Docs://21032 Sterling Hall/21032_SHS-A-MAIN-25.rvt
DRAWING LAST EDITED: 2026-07-27 4:48:58 PM

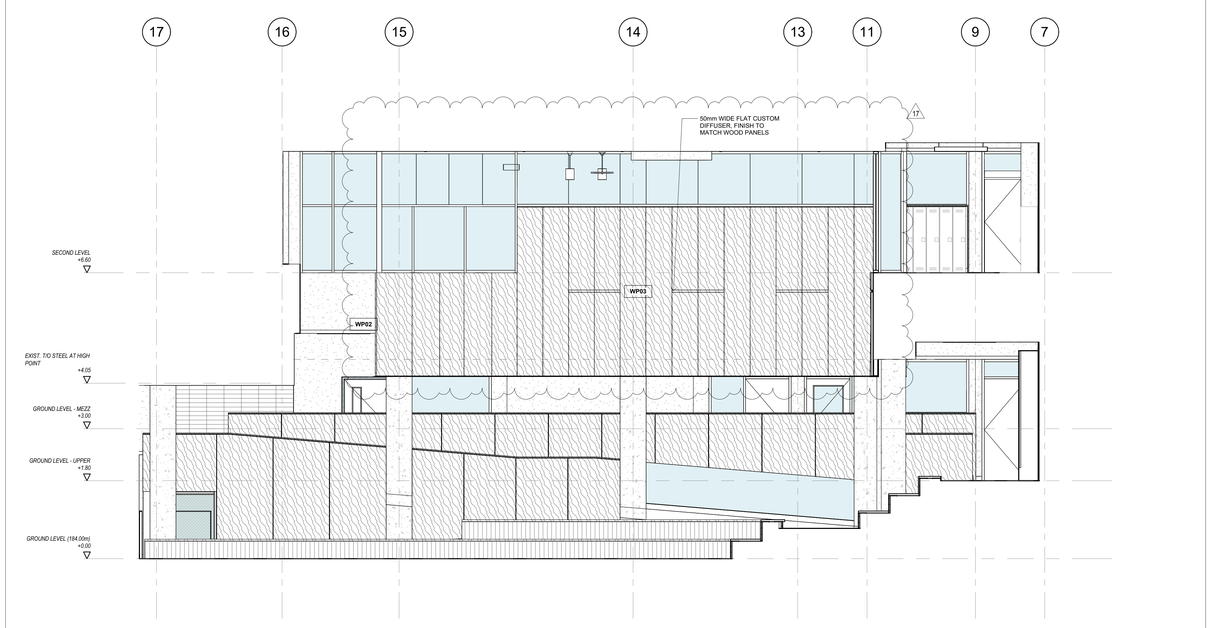

5 A7.20 HEART SPACE 101 - SOUTH
1 : 50

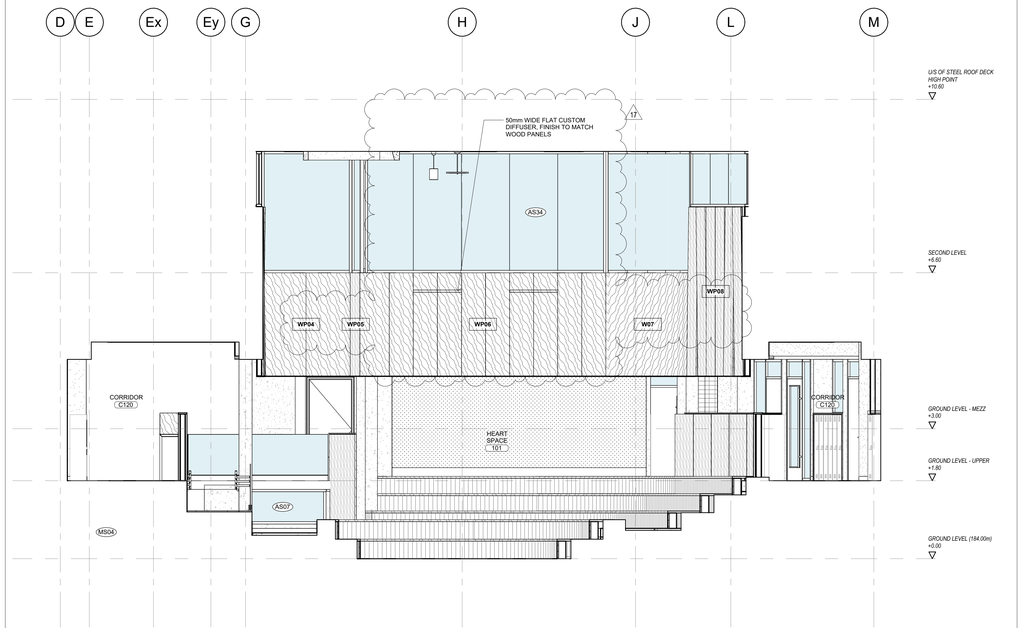

4 A7.20 HEART SPACE 101 - WEST
1 : 50

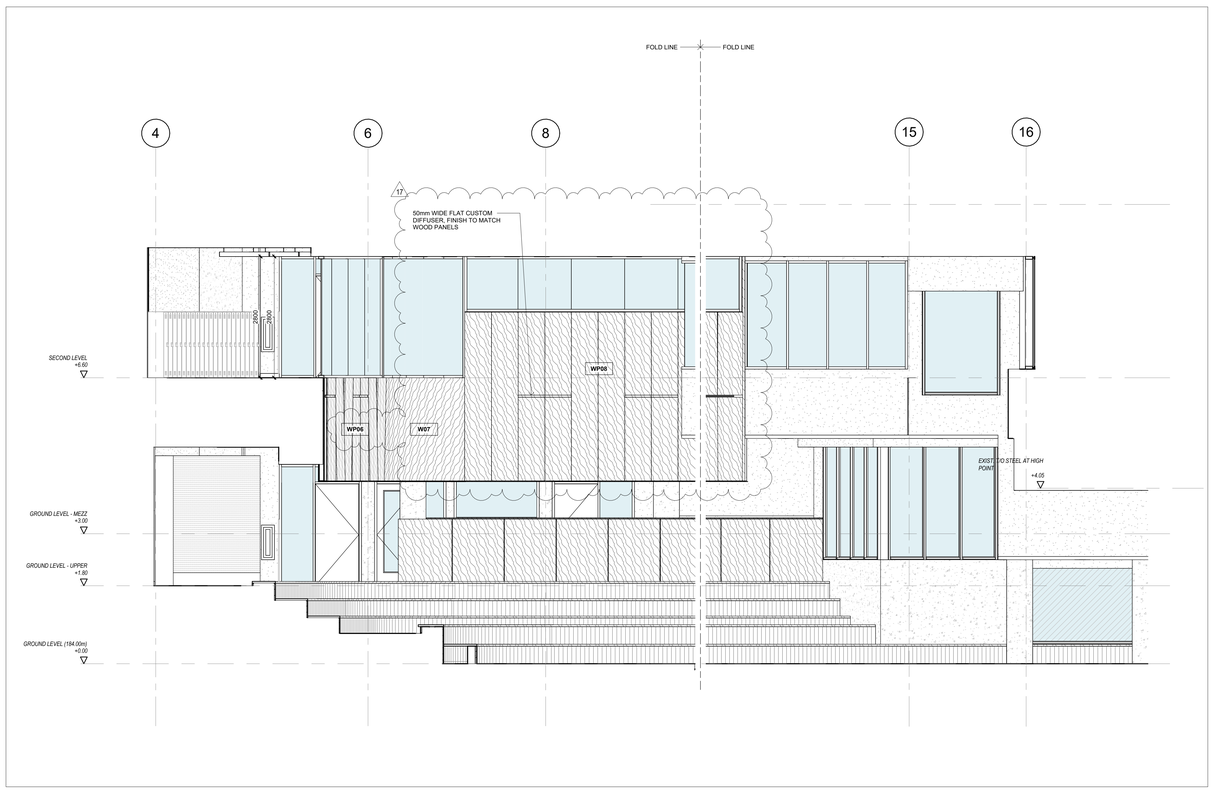

3 A7.20 HEART SPACE 101 - NORTHWEST
1 : 50

2 A7.20 HEART SPACE 101 - NORTH
1 : 50

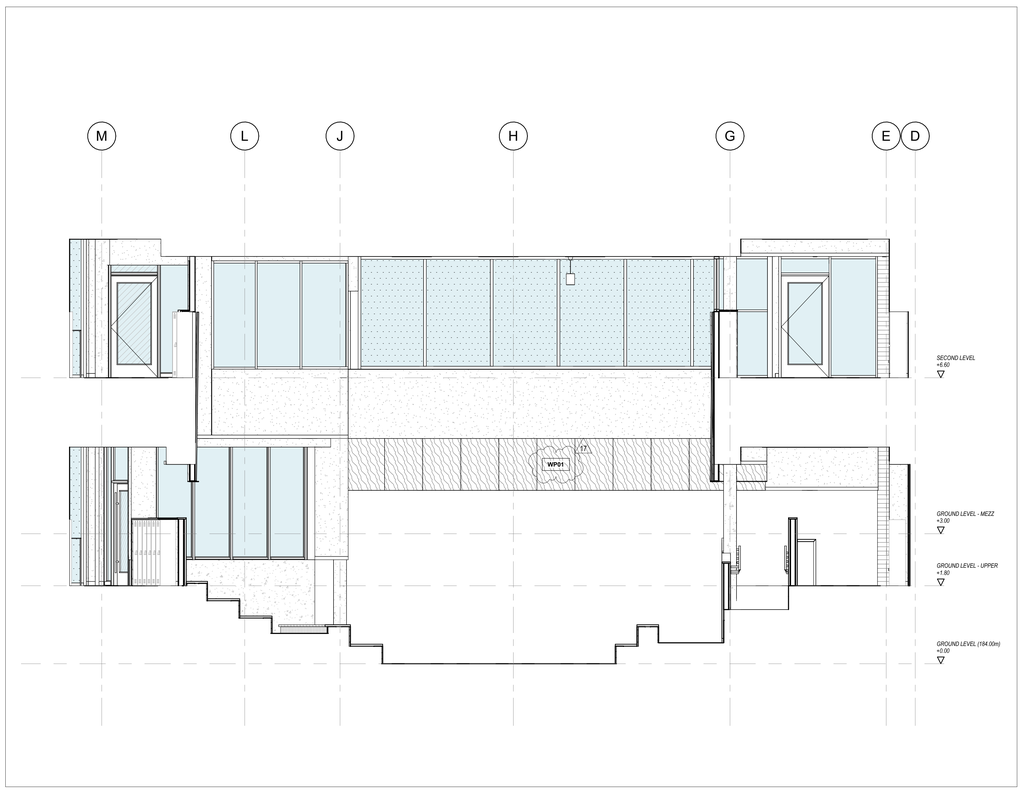

1 A7.20 HEART SPACE 101 - EAST
1 : 50

Key to Detail Location

NO. Detail Number
NO. Drawing Number

If this sheet is not 46 7/8" x 33 1/8" (1189 x 841 mm) it is a reduced print - Read dwg. accordingly.

Contractors must check and verify all dimensions on the job and report any discrepancies to the Architect before proceeding with the work.

All prints and specifications are the property of the Architect and must be returned at the completion of the work.

Drawings should not be scaled.

No	Date	Revision/Issued
11	2026 04 10	75% CD FOR CLIENT REVIEW
12	2026 04 22	ISSUED FOR PERMIT COMMENTS 1
14	2026 05 15	90% CD FOR CLIENT REVIEW
15	2026 07 08	ISSUED FOR TENDER
17	2026 07 27	ISSUED FOR ADDENDA 3

consultants

architect CS&P Architects Inc.
2345 Yonge St., Suite 200
Toronto, ON, M4P 2E5
Phone.416.482.5002
Fax.416.482.5040

civil engineer SCS Consulting Group Ltd.
30 Centurian Drive, Suite 100
Markham, ON, L3R 8B8
Phone.905.475.1900
Fax.905.475.8335

structural engineer LEA Consulting Ltd.
40 University Ave, Suite 503
Toronto, ON, M5J 1T1
Phone.905.470.0015

mechanical engineer Smith + Andersen
4211 Yonge Street
Toronto, ON, M2P 2A9
Phone.416.487.8151

electrical engineer Smith + Andersen
4211 Yonge Street
Toronto, ON, M2P 2A9
Phone.416.487.8151

landscape architect Quinn Design Associates Inc.
180 John Street
Toronto, ON, M5T 1X5
Phone.416.962.8700

SHS CS&P Architects

THE STERLING HALL SCHOOL

99 Cartwright Avenue, Toronto, ON M6A 1V4

INTERIOR ELEVATIONS - HEART SPACE

scale:	1 : 50
date:	01/23/26
drawn:	CS&P
checked by:	CA
project number:	21032
drawing number:	A7.20
	Revision: 17

A0

FILENAME: Autodesk Docs://21032 Sterling Hall/21032_SHS-A-MAIN-25.rvt

DRAWING LAST EDITED: 2026-07-27 4:49:05 PM

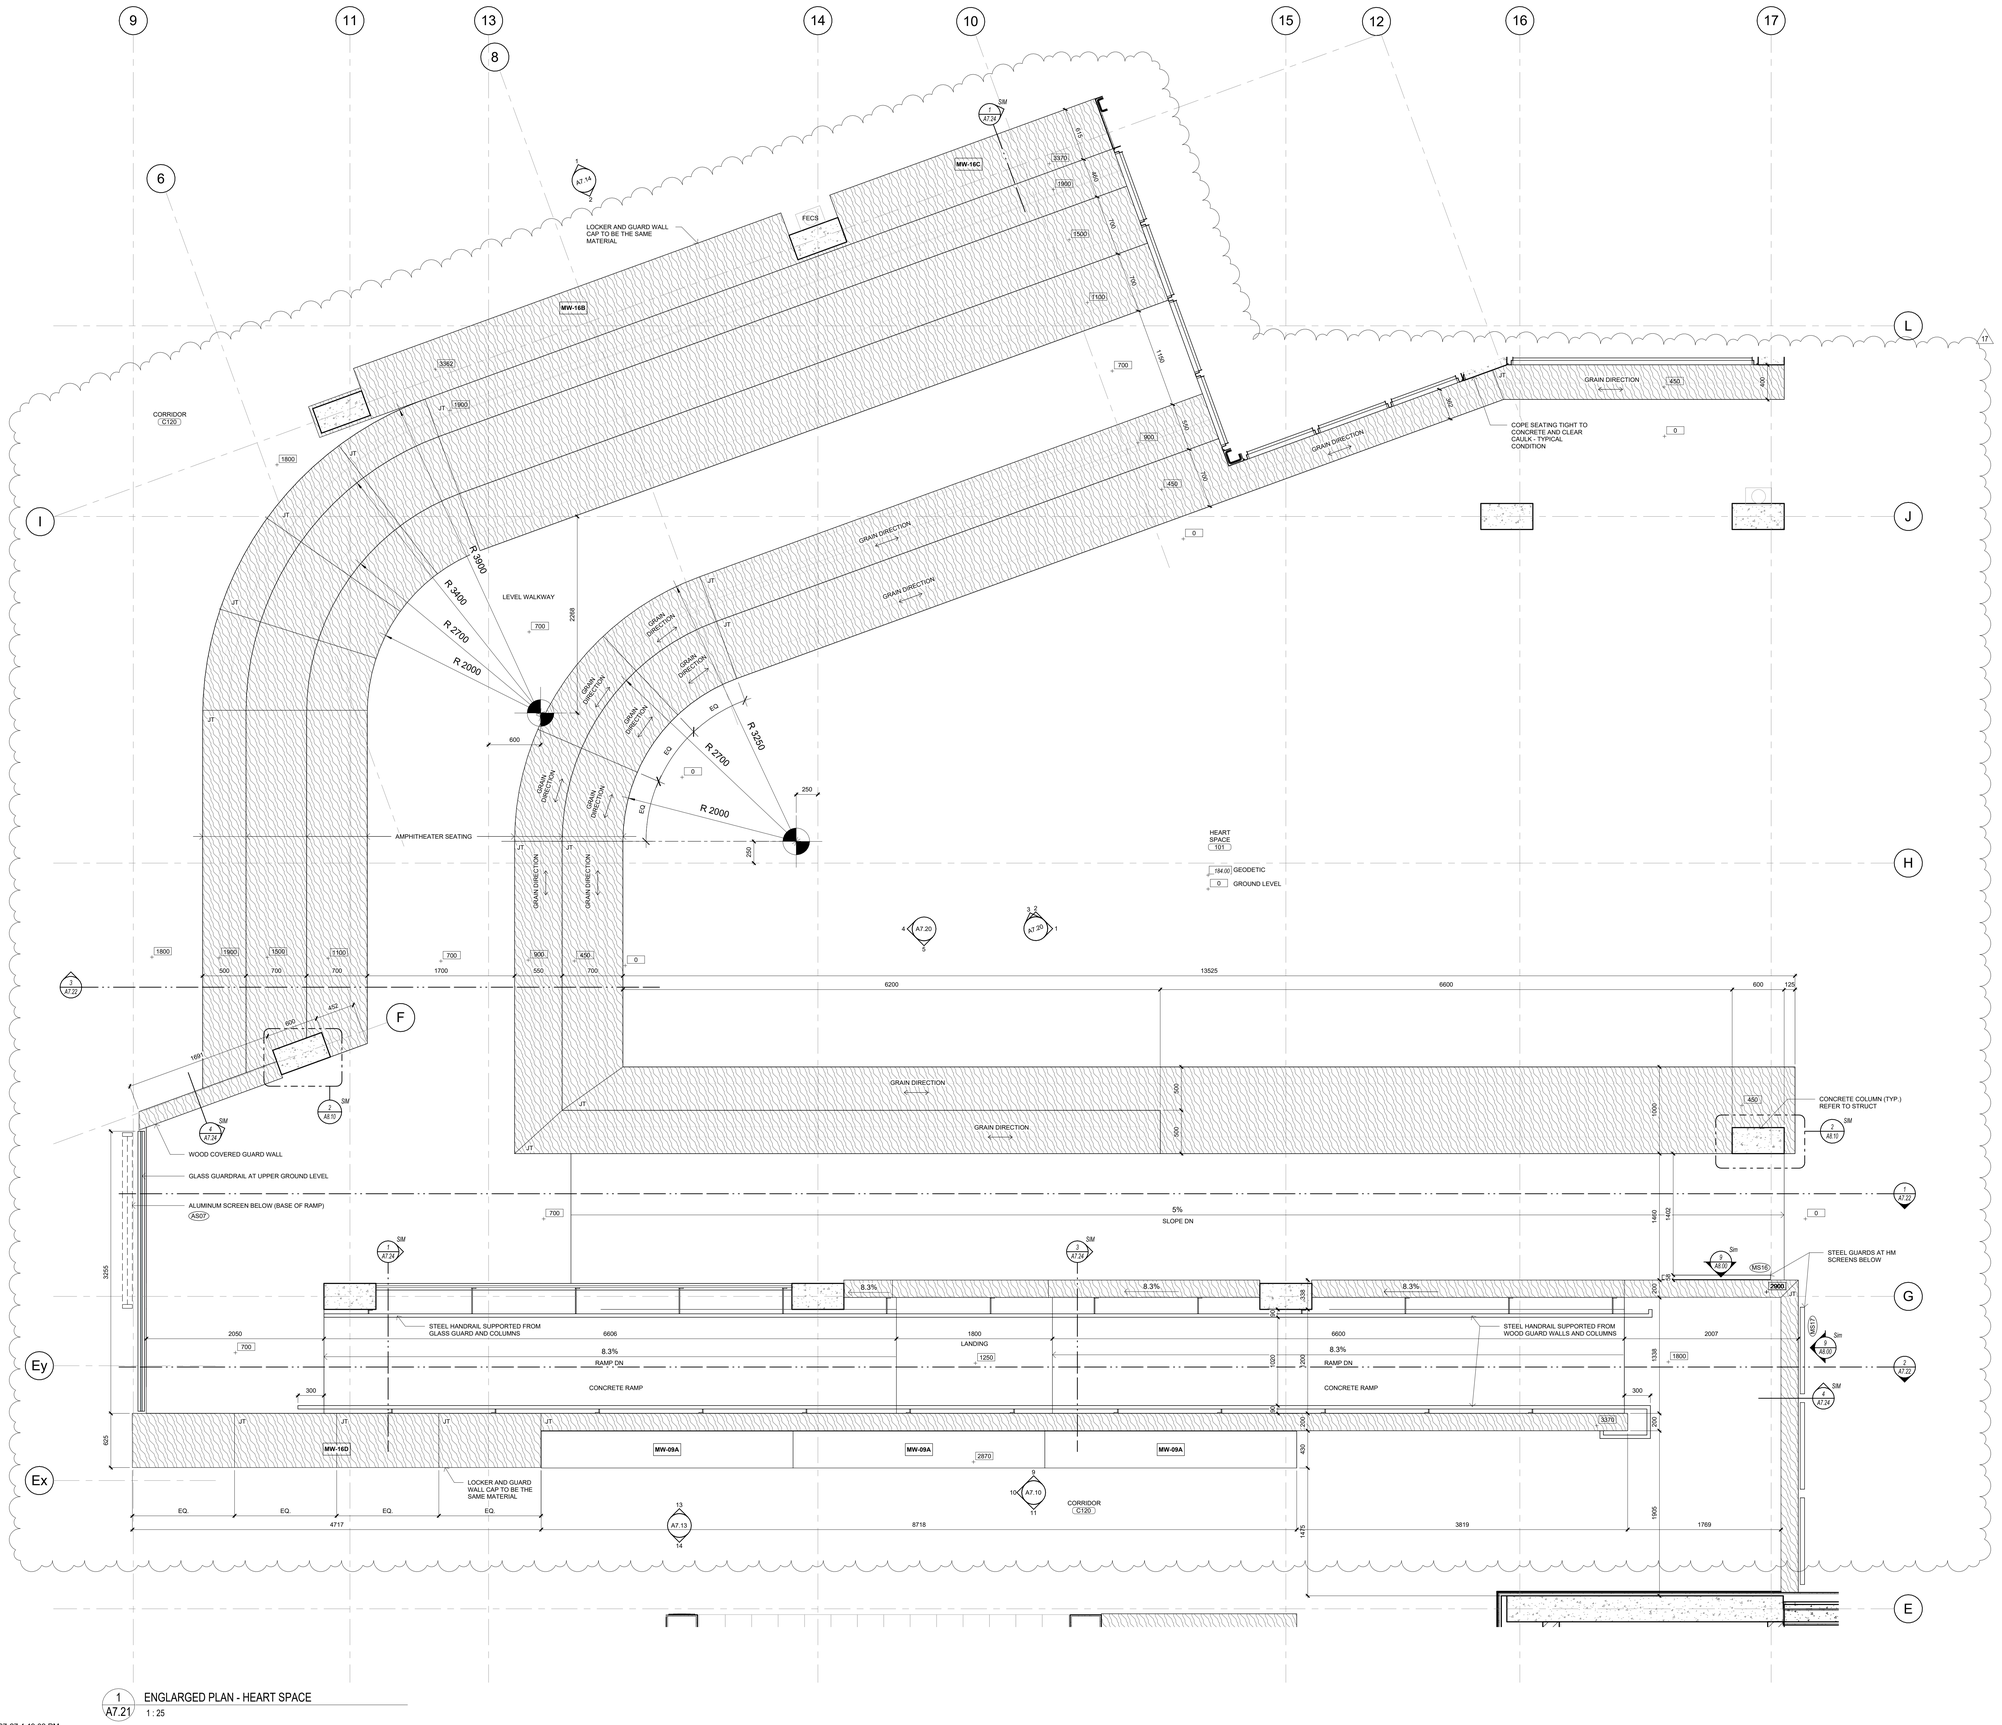

1 ENGLARGED PLAN - HEART SPACE
A7.21 1 : 25

A0

FILENAME: Autodesk Docs://21032 Sterling Hall/21032_SHS-A-MAIN-25.rvt

DRAWING LAST EDITED: 2026-07-27 4:49:08 PM

Key to Detail Location

NO. Detail Number
NO. Drawing Number

If this sheet is not 46 7/8" x 33 1/8" (1189 x 841 mm) it is a reduced print - Read dwg. accordingly.

Contractors must check and verify all dimensions on the job and report any discrepancies to the Architect before proceeding with the work.

All prints and specifications are the property of the Architect and must be returned at the completion of the work.

Drawings should not be scaled.

No	Date	Revision/Issued
11	2026 04 10	75% CD FOR CLIENT REVIEW
12	2026 04 22	ISSUED FOR PERMIT COMMENTS 1
14	2026 05 15	90% CD FOR CLIENT REVIEW
15	2026 07 08	ISSUED FOR TENDER
17	2026 07 27	ISSUED FOR ADDENDA 3

consultants

architect
CS&P Architects Inc.
2345 Yonge St., Suite 200
Toronto, ON, M4P 2E5
Phone.416.482.5002
Fax.416.482.5040

civil engineer
SCS Consulting Group Ltd.
30 Centurian Drive, Suite 100
Markham, ON, L3R 8B8
Phone.905.475.1900
Fax.905.475.8335

structural engineer
LEA Consulting Ltd.
40 University Ave, Suite 503
Toronto, ON, M5J 1T1
Phone.905.470.0015

mechanical engineer
Smith + Andersen
4211 Yonge Street
Toronto, ON, M2P 2A9
Phone.416.487.8151

electrical engineer
Smith + Andersen
4211 Yonge Street
Toronto, ON, M2P 2A9
Phone.416.487.8151

landscape architect
Quinn Design Associates Inc.
160 John Street
Toronto, ON, M5T 1X5
Phone.416.962.8700

PROJECT NORTH

SHS CS&P Architects

THE STERLING HALL SCHOOL

99 Cartwright Avenue, Toronto, ON M6A 1V4

INTERIOR PLAN - HEART SPACE

scale:	1 : 25
date:	10/09/25
drawn:	CS&P
checked by:	CA
project number:	21032
drawing number:	A7.21
Revision:	17

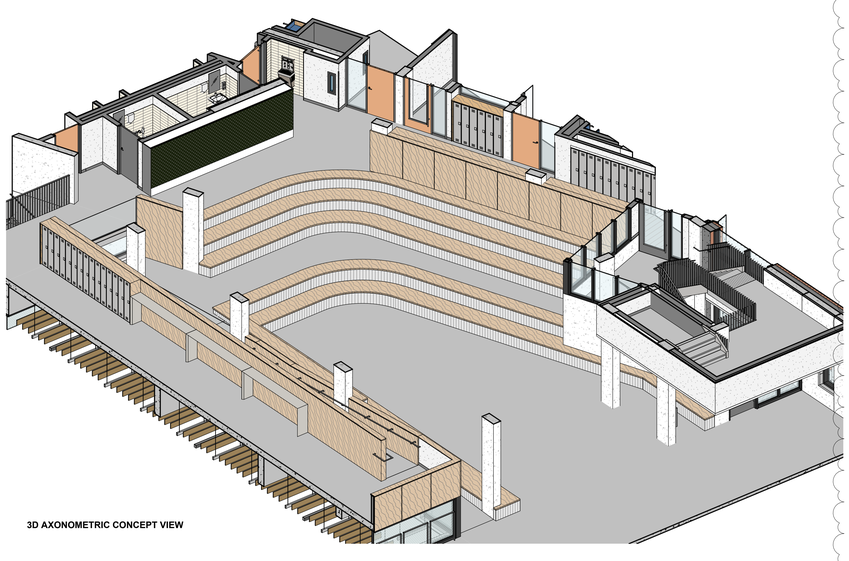

3D AXONOMETRIC CONCEPT VIEW

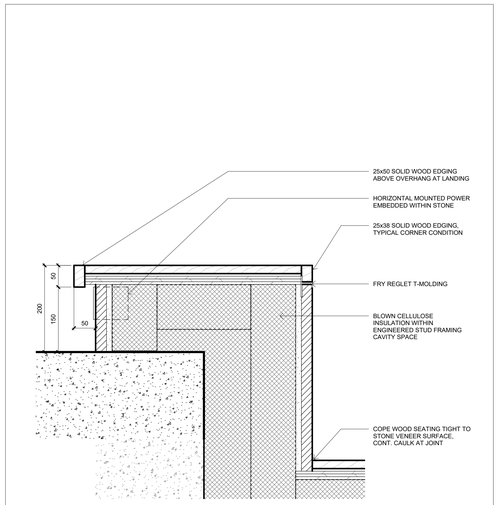

4 A7.22 SECTION DETAIL - HEART SPACE SEATING BENCH AT LANDING

1 : 5

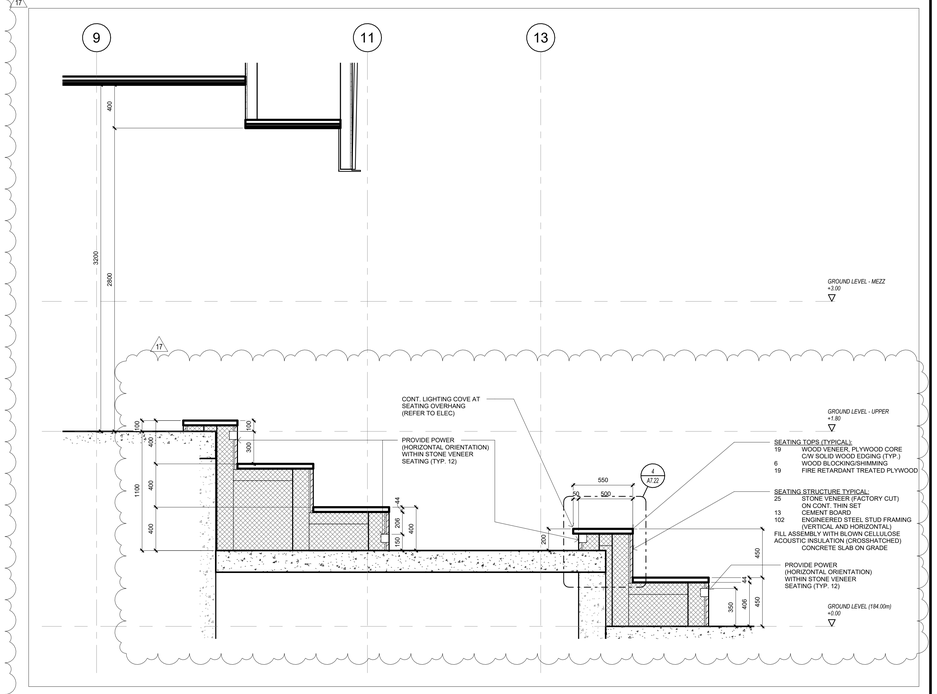

3 A7.22 SECTION - HEART SPACE SEATING

1 : 20

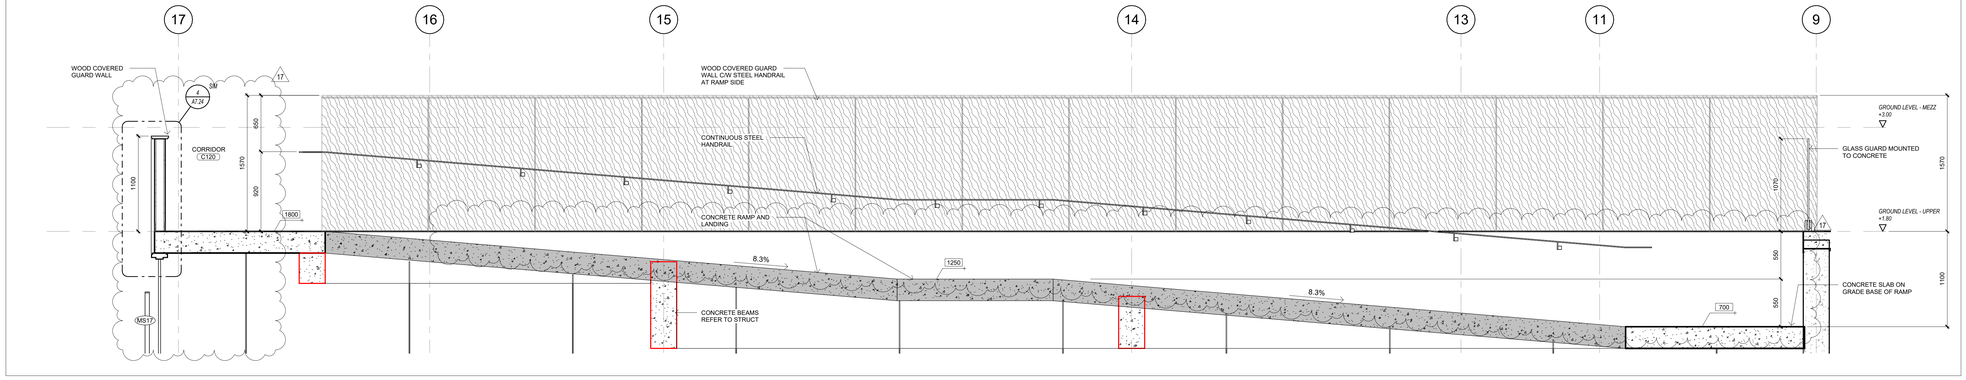

2 A7.22 SECTION - HEART SPACE UPPER GROUND RAMP

1 : 25

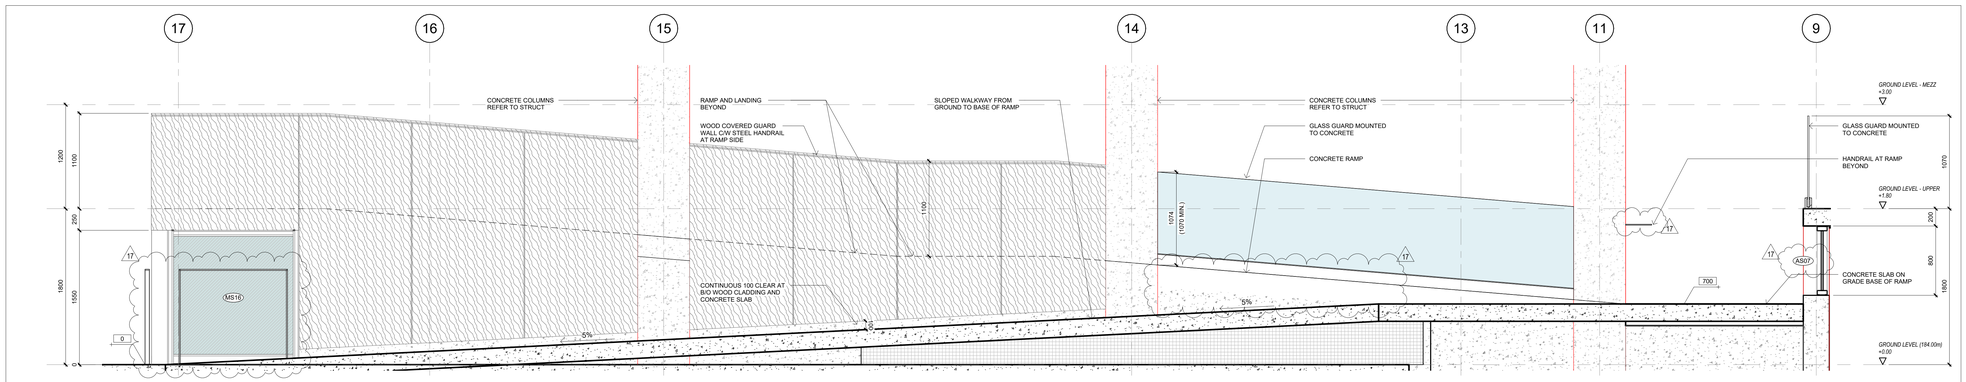

1 A7.22 SECTION - HEART SPACE SLOPED WALKWAY

1 : 25

Key to Detail Location

NO. Detail Number
NO. Drawing Number

If this sheet is not 46 7/8" x 33 1/8" (1189 x 841 mm) it is a reduced print - Read dwg. accordingly.

Contractors must check and verify all dimensions on the job and report any discrepancies to the Architect before proceeding with the work.

All prints and specifications are the property of the Architect and must be returned at the completion of the work.

Drawings should not be scaled.

No	Date	Revision/Issued
11	2026 04 10	75% CD FOR CLIENT REVIEW
12	2026 04 22	ISSUED FOR PERMIT COMMENTS 1
14	2026 05 15	90% CD FOR CLIENT REVIEW
15	2026 07 08	ISSUED FOR TENDER
17	2026 07 27	ISSUED FOR ADDENDA 3

consultants

architect CS&P Architects Inc.
2345 Yonge St., Suite 200
Toronto, ON, M4P 2E5
Phone.416.482.5002
Fax.416.482.5040

civil engineer SCS Consulting Group Ltd.
30 Centurian Drive, Suite 100
Markham, ON, L3R 8B8
Phone.905.475.1900
Fax.905.475.8335

structural engineer LEA Consulting Ltd.
40 University Ave, Suite 503
Toronto, ON, M5J 1T1
Phone.905.470.0015

mechanical engineer Smith + Andersen
4211 Yonge Street
Toronto, ON, M2P 2A9
Phone.416.487.8151

electrical engineer Smith + Andersen
4211 Yonge Street
Toronto, ON, M2P 2A9
Phone.416.487.8151

landscape architect Quinn Design Associates Inc.
160 John Street
Toronto, ON, M5T 1X5
Phone.416.962.8700

PROJECT NORTH

SHS CS&P Architects

THE STERLING HALL SCHOOL

99 Cartwright Avenue, Toronto, ON M6A 1V4

INTERIOR 3D AND SECTIONS - HEART SPACE

scale:	As indicated
date:	10/09/25
drawn:	CS&P
checked by:	CA
project number:	21032
drawing number:	A7.22
Revision:	17

A0

FILENAME: Autodesk Docs://21032 Sterling Hall/21032_SHS-A-MAIN-25.rvt

DRAWING LAST EDITED: 2026-07-27 4:49:13 PM

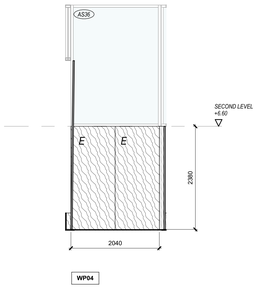

WP04

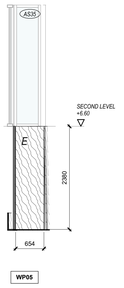

WP05

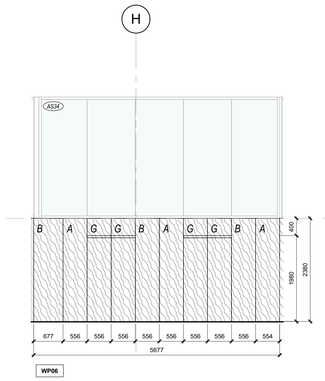

WP06

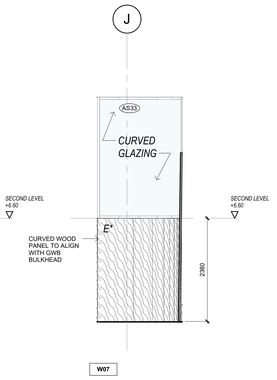

W07

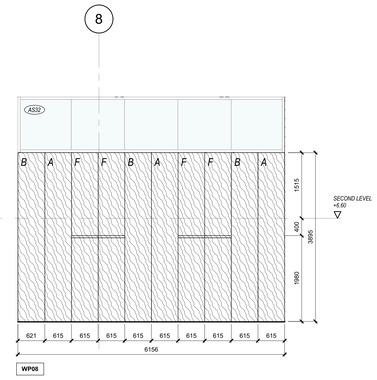

WP08

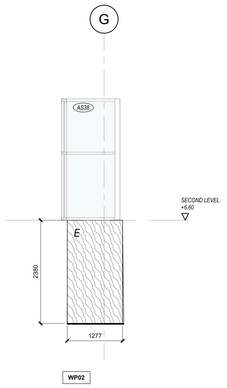

WP02

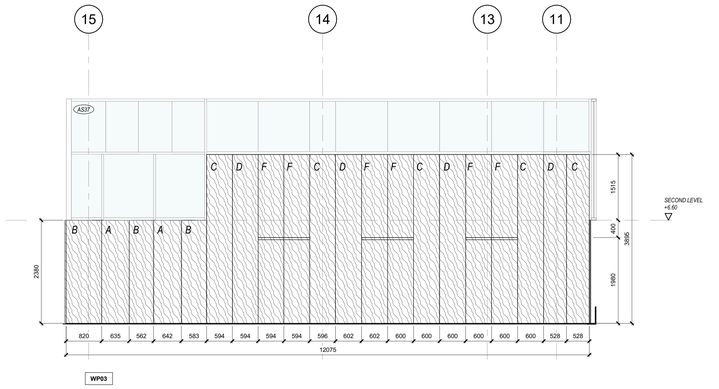

WP03

NOTES:
1. ALL ACOUSTIC WOOD WALL PANELS (WP) ARE TO BE FASTENED TO THE ASSOCIATED BULKHEADS AND BLOCKING TO BE PROVIDED TO ACCOUNT FOR THE SLOPES
2. COORDINATE HVAC OPENINGS AND TRIM ACCORDINGLY.
3. REFER TO SPECIFICATIONS FOR WP INSTALLATION INFORMATION.
4. FINISH TRIM AND EDGINGS NOT PROVIDED BY THE ACOUSTIC WP ARE TO BE MATCHED IN FINISH AND MATERIAL AND APPROVED PRIOR TO FABRICATION.
5. REFER TO A7.24 FOR APPLICABLE PANEL DETAILS.

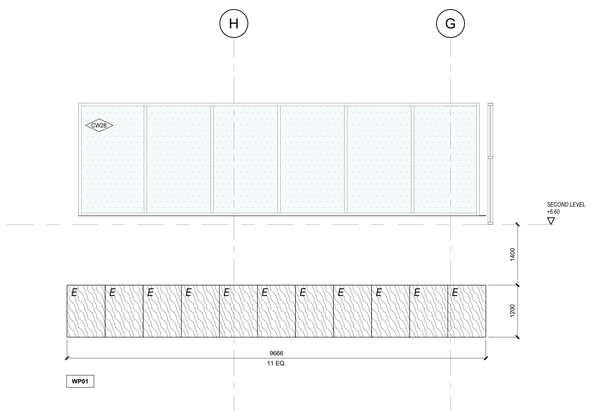

WP01

Key to Detail Location

NO.
NO.
Detail Number
Drawing Number

If this sheet is not 46 7/8" x 33 1/8" (1189 x 841 mm) it is a reduced print - Read dwg. accordingly.

Contractors must check and verify all dimensions on the job and report any discrepancies to the Architect before proceeding with the work.

All prints and specifications are the property of the Architect and must be returned at the completion of the work.

Drawings should not be scaled.

No	Date	Revision/Issued

consultants

architect
CS&P Architects Inc.
2345 Yonge St., Suite 200
Toronto, ON, M4P 2E5
Phone.416.482.5002
Fax.416.482.5040

civil engineer
SCS Consulting Group Ltd.
30 Centurian Drive, Suite 100
Markham, ON, L3R 8B8
Phone.905.475.1900
Fax.905.475.8335

structural engineer
LEA Consulting Ltd.
40 University Ave, Suite 503
Toronto, ON, M5J 1T1
Phone.905.470.0015

mechanical engineer
Smith + Andersen
4211 Yonge Street
Toronto, ON, M2P 2A9
Phone.416.487.8151

electrical engineer
Smith + Andersen
4211 Yonge Street
Toronto, ON, M2P 2A9
Phone.416.487.8151

landscape architect
Quinn Design Associates Inc.
180 John Street
Toronto, ON, M5T 1X5
Phone.416.962.8700

CS&PArchitects

THE STERLING HALL SCHOOL

99 Cartwright Avenue, Toronto, ON M6A 1V4

INTERIOR DETAILS - HEART SPACE PANEL ELEVATIONS

scale:	1 : 50
date:	01/23/26
drawn:	CS&P
checked by:	CA
project number:	21032
drawing number:	A7.23
Revision:	

A0

FILENAME: Autodesk Docs://21032 Sterling Hall/21032_SHS-A-MAIN-25.rvt

_DRAWING LAST EDITED: 2026-07-27 4:49:16 PM

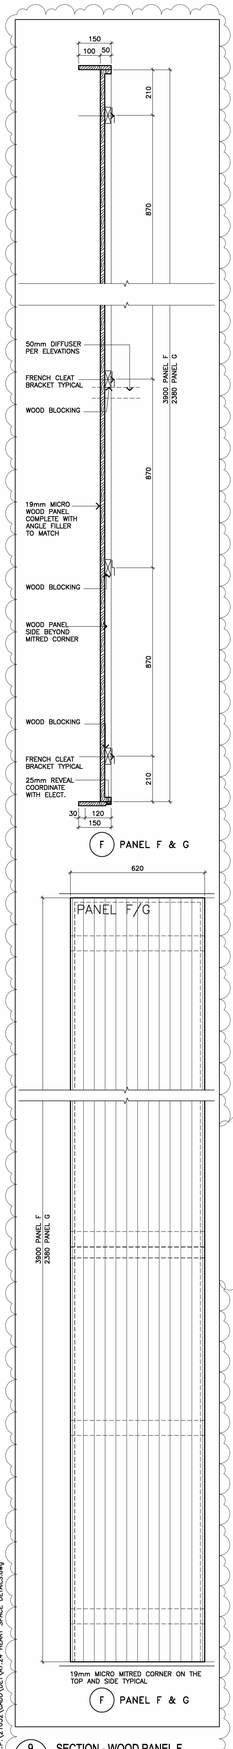

F PANEL F & G

F PANEL F & G

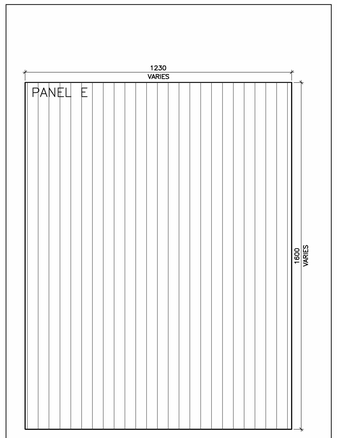

E PANEL E

8 A7.24 SECTION - WOOD PANEL E
1 : 10

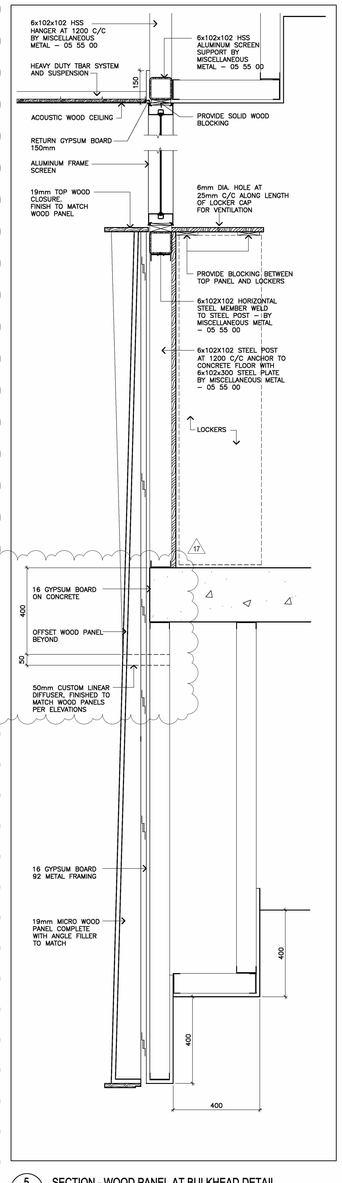

5 A7.24 SECTION - WOOD PANEL AT BULKHEAD DETAIL
1 : 10

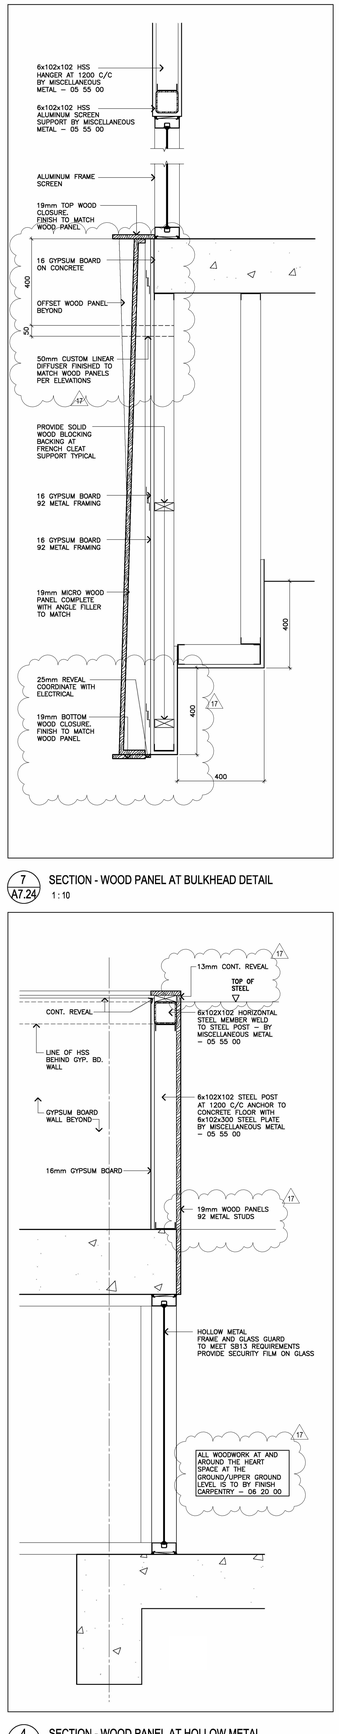

7 A7.24 SECTION - WOOD PANEL AT BULKHEAD DETAIL
1 : 10

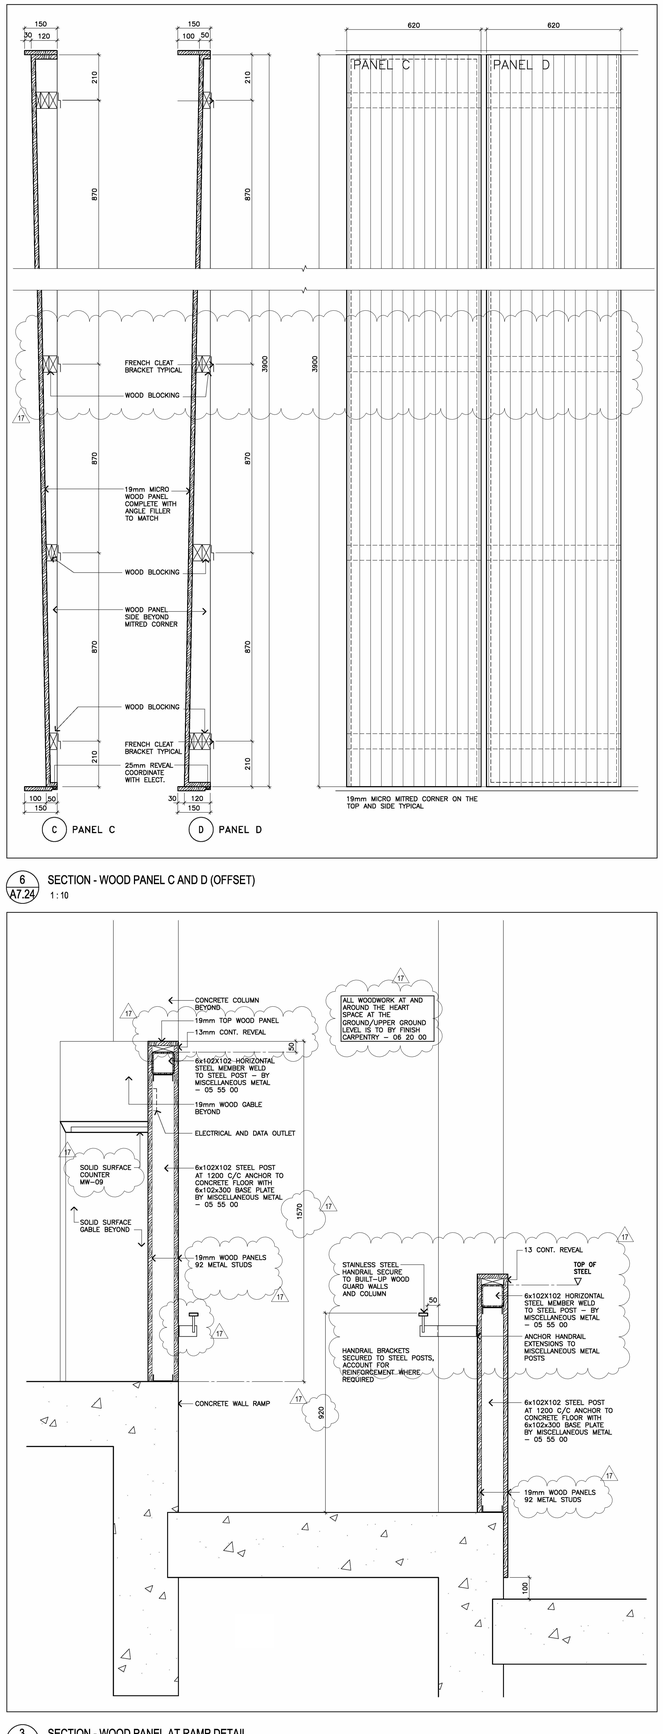

C PANEL C D PANEL D

6 A7.24 SECTION - WOOD PANEL C AND D (OFFSET)
1 : 10

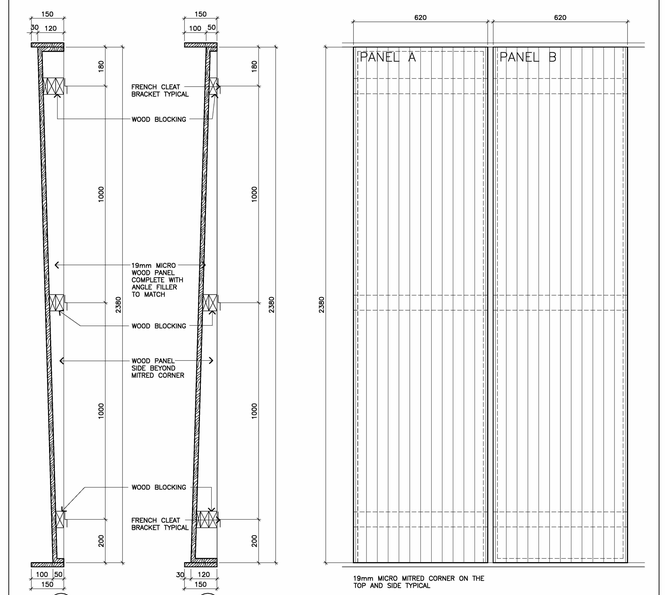

A PANEL A B PANEL B

2 A7.24 SECTION - WOOD PANEL A AND B (OFFSET)
1 : 10

5 A7.24 SECTION - WOOD PANEL AT BULKHEAD DETAIL
1 : 10

3 A7.24 SECTION - WOOD PANEL AT RAMP DETAIL
1 : 10

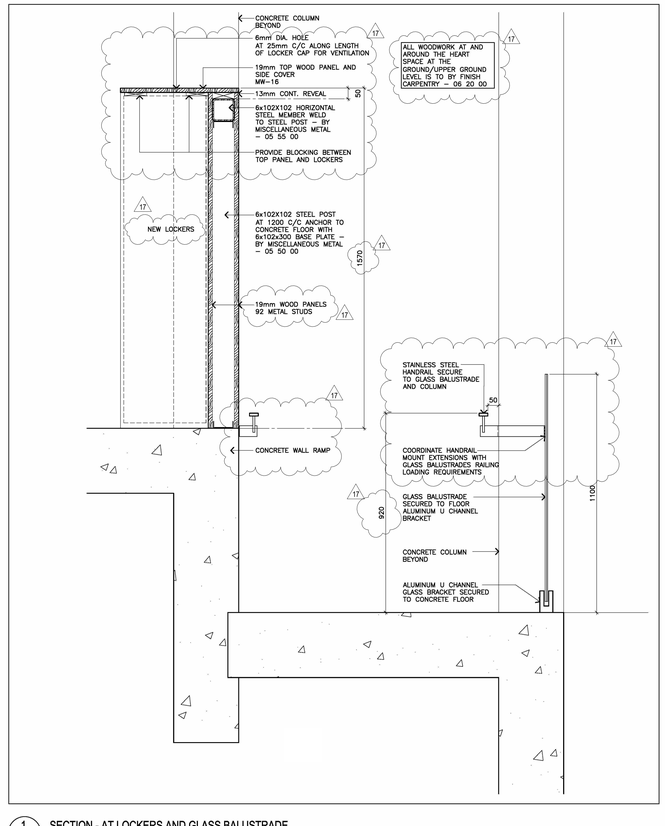

1 A7.24 SECTION - AT LOCKERS AND GLASS BALUSTRADE
1 : 10

Key to Detail Location

NO. Detail Number
NO. Drawing Number

If this sheet is not 46 7/8" x 33 1/8" (1189 x 841 mm) it is a reduced print - Read dwg. accordingly.

Contractors must check and verify all dimensions on the job and report any discrepancies to the Architect before proceeding with the work.

All prints and specifications are the property of the Architect and must be returned at the completion of the work.

Drawings should not be scaled.

No	Date	Revision/Issued
15	2026 07 08	ISSUED FOR TENDER
17	2026 07 27	ISSUED FOR ADDENDA 3

consultants

architect
CS&P Architects Inc.
2345 Yonge St., Suite 200
Toronto, ON, M4P 2E5
Phone.416.482.5002
Fax.416.482.5040

civil engineer
SCS Consulting Group Ltd.
30 Centurian Drive, Suite 100
Markham, ON, L3R 8B8
Phone.905.475.1900
Fax.905.475.8335

structural engineer
LEA Consulting Ltd.
40 University Ave, Suite 503
Toronto, ON, M5J 1T1
Phone.905.470.0015

mechanical engineer
Smith + Andersen
4211 Yonge Street
Toronto, ON, M2P 2A9
Phone.416.487.8151

electrical engineer
Smith + Andersen
4211 Yonge Street
Toronto, ON, M2P 2A9
Phone.416.487.8151

landscape architect
Quinn Design Associates Inc.
180 John Street
Toronto, ON, M5T 1X5
Phone.416.962.8700

SHS
CS&PArchitects

THE STERLING HALL SCHOOL

99 Cartwright Avenue, Toronto, ON M6A 1V4

INTERIOR DETAILS - HEART SPACE DETAILS

scale:	1 : 10
date:	06/23/26
drawn:	CS&P
checked by:	CA
project number:	21032
drawing number:	A7.24
	Revision: 17

A0

FILENAME: Autodesk Docs://21032 Sterling Hall/21032_SHS-A-MAIN-25.rvt
FILENAME:P:\21032\CAD\[ATV]A7.24_HEART SPACE DETAILS.dwg
DRAWING LAST EDITED: 2026-07-27 4:49:24 PM

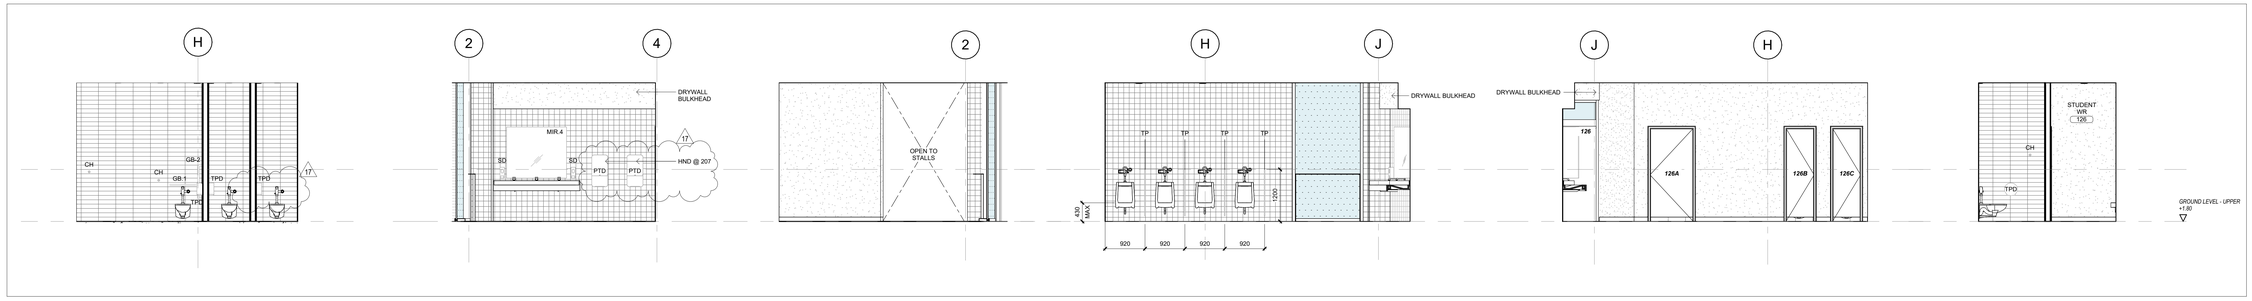

23 A7.50 ELEVATION STUDENT WR 126 AND 207
1 : 50

22 A7.50 ELEVATION STUDENT WR 126 AND 207
1 : 50

21 A7.50 ELEVATION STUDENT WR 126 AND 207
1 : 50

20 A7.50 ELEVATION STUDENT WR 126 AND 207
1 : 50

19 A7.50 ELEVATION STUDENT WR 126 AND 207
1 : 50

18 A7.50 ELEVATION STUDENT WR 126 AND 207
1 : 50

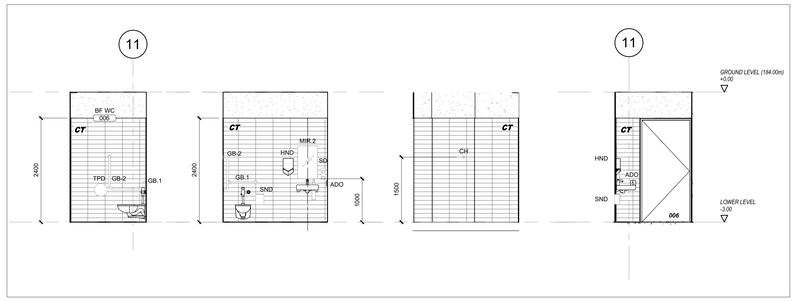

17 A7.50 ELEVATION WR 006
1 : 50

16 A7.50 ELEVATION WR 006
1 : 50

15 A7.50 ELEVATION WR 006
1 : 50

14 A7.50 ELEVATION WR 006
1 : 50

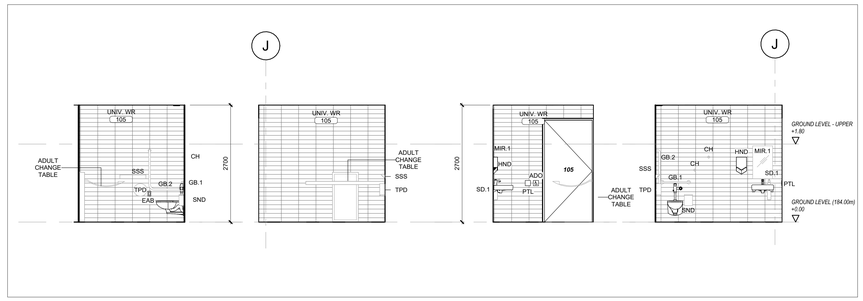

13 A7.50 ELEVATION UNIV.WR 105
1 : 50

12 A7.50 ELEVATION UNIV.WR 105
1 : 50

11 A7.50 ELEVATION UNIV.WR 105
1 : 50

10 A7.50 ELEVATION UNIV.WR 105
1 : 50

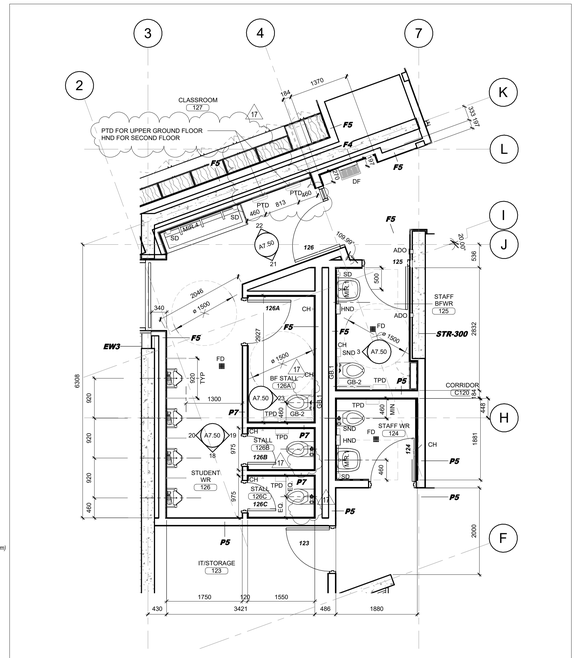
3
4
7
2
K
L
I
J
CLASSROOM
127
17
PTD FOR UPPER GROUND FLOOR
HND FOR SECOND FLOOR
1370
184
F5
F4
F5
F5
DF
SD
PTD
PTD
405
405
813
SD
MIR.4
A7.50
21
126
ADO
125
F5
STAFF WR
124
STAFF
BFWR
125
STR-300
2832
CORRIDOR
C120
EW3
F5
F5
F5
FD
ø 1500
CH
SND 3
A7.50
GB-2
TPD
P5
TPD
460
MIR
STAFF WR
124
FD
HND
ADO
CH
P7
P5
1881
1300
BF STALL
126A
A7.50
X3
TPD
460
GB-2
P7
2027
2A
A7.50
19
CH
STALL
126B
17
P7
126B
STUDENT WR
126
CH
TPD
STALL
126C
P7
126C
975
P5
P5
123
IT/STORAGE
123
2000
F
1750
120
1550
430
3421
486
1880
6308
920
920
920
460
340
2048
ø 1500
1050
F5
EW3
FD
TYP
TYP
TYP

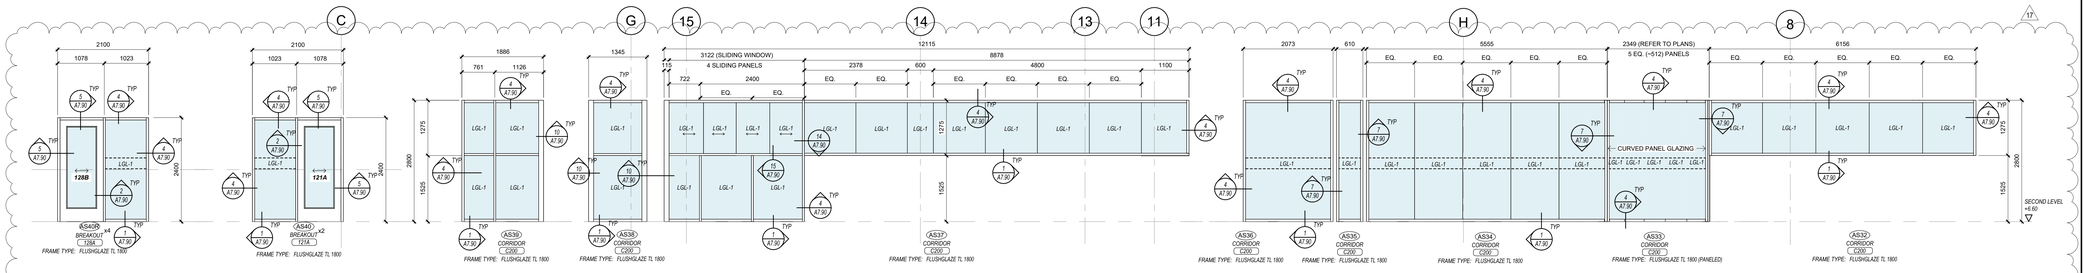

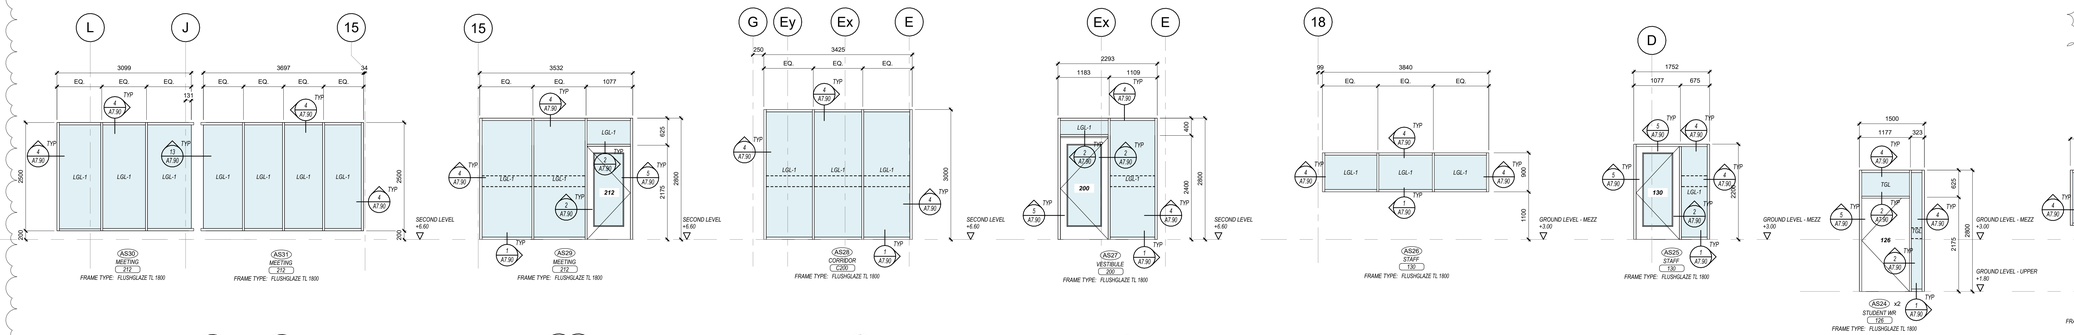

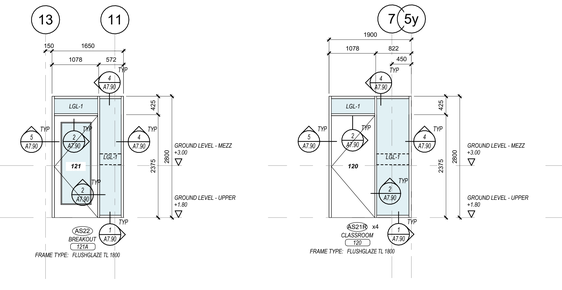

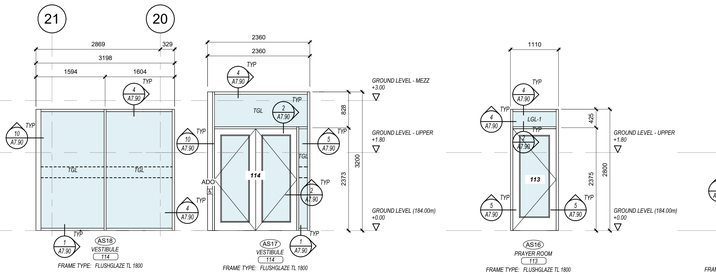

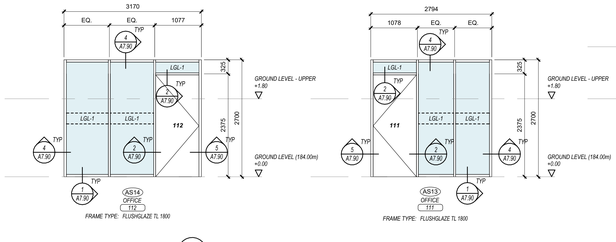

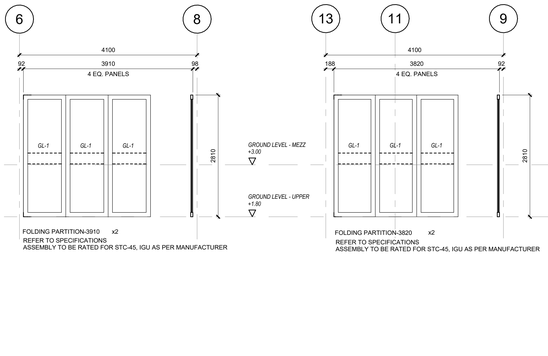

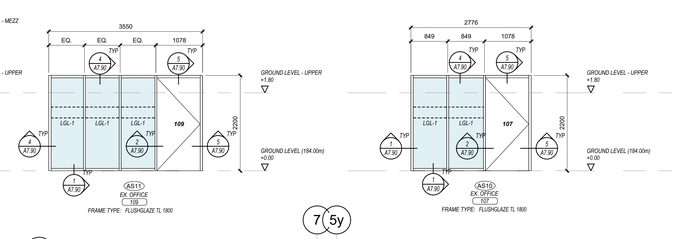

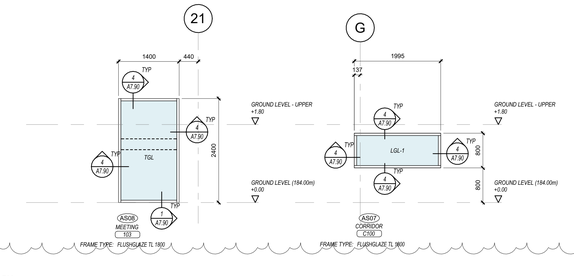

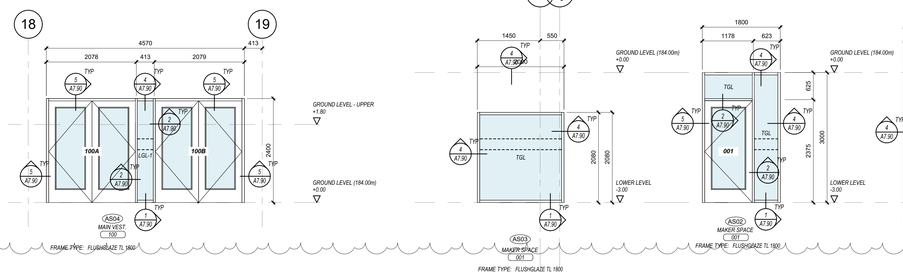

GLAZING LEGEND

- GL-1 — GL-1 INSULATED GLASS UNIT - VISION GLASS
- GL-2 — GL-2 INSULATED GLASS UNIT - BIRD FRIT
- FRGL — FRGL FIRE RATED GLASS
- FRS — FRS FIRE RATED GLASS C/W SECURITY FILM
- FRNT — FRNT FIRE RATED SAFETY GLASS
- LGL-1 — LGL-1 LAMINATED GLASS
- LGL-2 — LGL-2 LAMINATED GLASS - BIRD FRIT
- TGL — TGL TEMPERED GLASS
- SB — SB SHADOW BOX GL-2 AND METAL SPANDREL PANEL
- SGL — SGL INSULATED SPANDREL PANEL
- CAPPED MULLION
- SSG — SSG SILICONE STRUCTURAL GLAZED MULLION
- SILICONE JOINT (NON-STRUCTURAL)
- OPERABLE WINDOW/GLAZING UNIT
- VISION STRIP FILM
- ALC — ALC ALUMINUM CLOSURE PANEL REFER TO DETAILS FOR INSULATION MATERIAL, MILLION FINISH

Key to Detail Location

NO. / NO. — Detail Number / Drawing Number

If this sheet is not 46 7/8" x 33 1/8" (1189 x 841 mm) It is a reduced print - Read dwg. accordingly.

Contractors must check and verify all dimensions on the job and report any discrepancies to the Architect before proceeding with the work.

All prints and specifications are the property of the Architect and must be returned at the completion of the work.

Drawings should not be scaled.

No	Date	Revision/Issued
15	2026 07 08	ISSUED FOR TENDER
16	2026 07 17	ISSUED FOR ADDENDA 1
17	2026 07 27	ISSUED FOR ADDENDA 3

consultants

architect — CS&P Architects Inc., 2345 Yonge St., Suite 200, Toronto, ON, M4P 2E5, Phone.416.482.5002, Fax.416.482.5040

civil engineer — SCS Consulting Group Ltd., 30 Centurian Drive, Suite 100, Markham, ON, L3R 8B8, Phone.905.475.1900, Fax.905.475.8335

structural engineer — LEA Consulting Ltd., 40 University Ave, Suite 503, Toronto, ON, M5J 1T1, Phone.905.470.0015

mechanical engineer — Smith + Andersen, 4211 Yonge Street, Toronto, ON, M2P 2A9, Phone.416.487.8151

electrical engineer — Smith + Andersen, 4211 Yonge Street, Toronto, ON, M2P 2A9, Phone.416.487.8151

landscape architect — Quinn Design Associates Inc., 180 John Street, Toronto, ON, M5T 1X5, Phone.416.962.8700

PROJECT NORTH

SHS CS&PArchitects

THE STERLING HALL SCHOOL

99 Cartwright Avenue, Toronto, ON M6A 1V4

INTERIOR SCREEN ELEVATIONS

scale:	1 : 50
date:	10/09/25
drawn:	CS&P
checked by:	CA
project number:	21032
drawing number:	A7.80
Revision:	17

A0

FILENAME: Autodesk Docs://21032 Sterling Hall/21032_SHS-A-MAIN-26.rvt

DRAWING LAST EDITED: 2026-07-27 4:49:52 PM

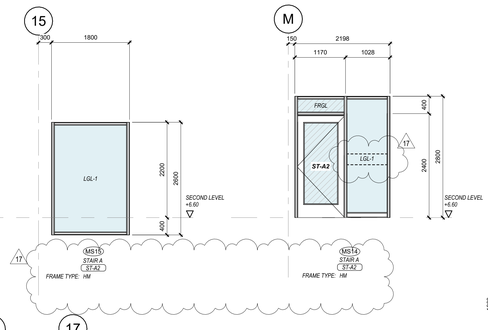

GLAZING LEGEND

- GL-1 — GL-1 INSULATED GLASS UNIT - VISION GLASS
- GL-2 — GL-2 INSULATED GLASS UNIT - BIRD FRIT
- FRGL — FRGL FIRE RATED GLASS
- FRS — FRS FIRE RATED GLASS C/W SECURITY FILM
- FRNT — FRNT FIRE RATED SAFETY GLASS
- LGL-1 — LGL-1 LAMINATED GLASS
- LGL-2 — LGL-2 LAMINATED GLASS - BIRD FRIT
- TGL — TGL TEMPERED GLASS
- SB — SB SHADOW BOX GL-2 AND METAL SPANDREL PANEL
- SGL — SGL INSULATED SPANDREL PANEL
- CAPPED MULLION
- SSG — SILICONE STRUCTURAL GLAZED MULLION
- SILICONE JOINT (NON-STRUCTURAL)
- OPERABLE WINDOW/GLAZING UNIT
- VISION STRIP FILM
- ALC — ALC ALUMINUM CLOSURE PANEL REFER TO DETAILS FOR INSULATION MATCH MULLION FINISH

17

Key to Detail Location

NO. / NO. — Detail Number / Drawing Number

If this sheet is not 46 7/8" x 33 1/8" (1189 x 841 mm) it is a reduced print - Read dwg. accordingly.

Contractors must check and verify all dimensions on the job and report any discrepancies to the Architect before proceeding with the work.

All prints and specifications are the property of the Architect and must be returned at the completion of the work.

Drawings should not be scaled.

No	Date	Revision/Issued
15	2026 07 08	ISSUED FOR TENDER
16	2026 07 17	ISSUED FOR ADDENDA 1
17	2026 07 27	ISSUED FOR ADDENDA 3

consultants

architect — CS&P Architects Inc.
2345 Yonge St., Suite 200
Toronto, ON, M4P 2E5
Phone.416.482.5002
Fax.416.482.5040

civil engineer — SCS Consulting Group Ltd.
30 Centurian Drive, Suite 100
Markham, ON, L3R 8B8
Phone.905.475.1900
Fax.905.475.8335

structural engineer — LEA Consulting Ltd.
40 University Ave, Suite 503
Toronto, ON, M5J 1T1
Phone.905.470.0015

mechanical engineer — Smith + Andersen
4211 Yonge Street
Toronto, ON, M2P 2A9
Phone.416.487.8151

electrical engineer — Smith + Andersen
4211 Yonge Street
Toronto, ON, M2P 2A9
Phone.416.487.8151

landscape architect — Quinn Design Associates Inc.
180 John Street
Toronto, ON, M5T 1X5
Phone.416.962.8700

PROJECT NORTH

SHS CS&P Architects

THE STERLING HALL SCHOOL

99 Cartwright Avenue, Toronto, ON M6A 1V4

INTERIOR SCREEN ELEVATIONS

scale:	1 : 50
date:	10/09/25
drawn:	CS&P
checked by:	CA
project number:	21032
drawing number:	A7.81
	Revision: 17

A0

FILENAME: Autodesk Docs://21032 Sterling Hall/21032_SHS-A-MAIN-25.rvt

DRAWING LAST EDITED: 2026-07-27 4:49:59 PM

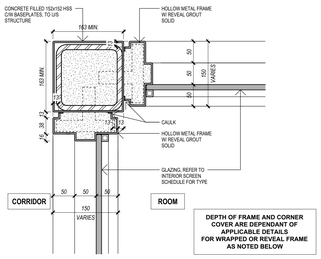

16 A7.90 PLAN DETAIL - HOLLOW METAL FRAME CORNER
1 : 5

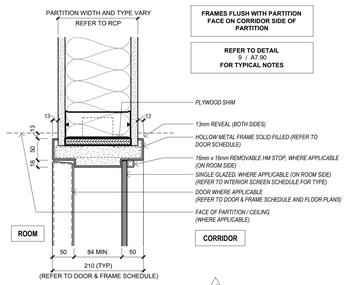

12 A7.90 SECTION DETAIL - HM FRAME JAMB @ WRAPPED STUD PARTITION
1 : 5

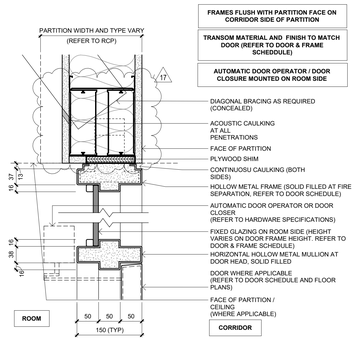

9 A7.90 SECTION DETAIL - TYPICAL HM FRAME HEAD W/ TRANSOM
1 : 5

6 A7.90 PLAN SECTION DETAIL - MID MULLION HM
1 : 5

3 A7.90 SECTION DETAIL -HM AT SILL/FLOOR
1 : 5

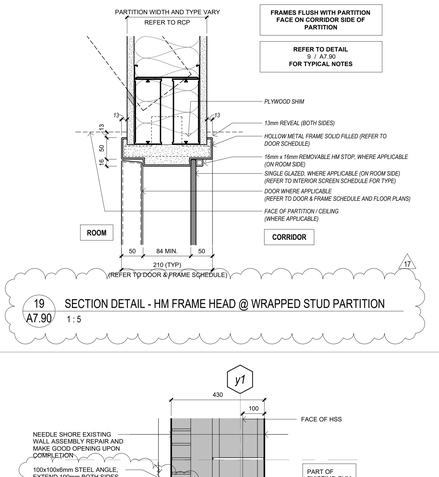

19 A7.90 SECTION DETAIL - HM FRAME HEAD @ WRAPPED STUD PARTITION
1 : 5

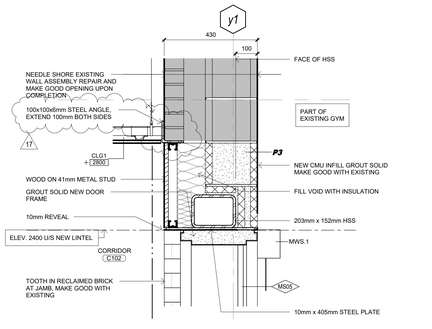

18 A7.90 SECTION DETAIL - NEW OPENING AT GYM - HEAD
1 : 10

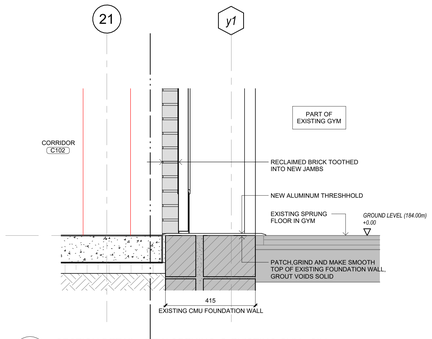

17 A7.90 SECTION DETAIL - NEW OPENING @ EXISTING GYM - SILL
1 : 10

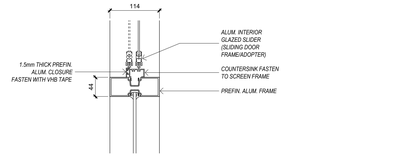

15 A7.90 SECTION DETAIL - SLIDING WINDOW SILL DETAIL AT ALUMINUM FRAME (AS37)
1 : 5

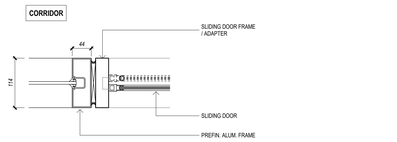

14 A7.90 PLAN DETAIL - SLIDING WINDOW AT ALUMINUM FRAME (AS37)
1 : 5

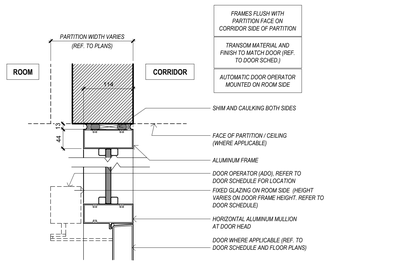

11 A7.90 SECTION DETAIL - ALUM FRAMEHEAD W/ TRANSOM MULLION
1 : 5

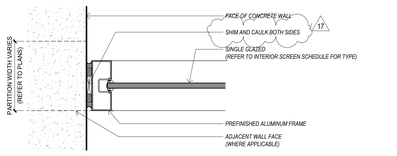

8 A7.90 PLAN DETAIL - ALUMINUM FRAME AT CONCRETE WALL
1 : 5

5 A7.90 PLAN/SECTION DETAIL - ALUMINUM FRAME SWING DOOR JAMB @ PARTITION
1 : 5

2 A7.90 PLAN/SECTION DETAIL - ALUMINUM FRAME JAMB @ DOOR AND GLAZING
1 : 5

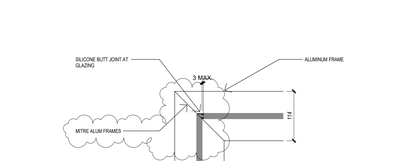

13 A7.90 PLAN/ SECTION DETAIL - ALUMINUM FRAME CORNER BUTT JOINT
1 : 5

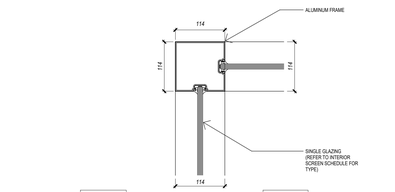

10 A7.90 PLAN/ SECTION DETAIL - ALUMINUM FRAME CORNER
1 : 5

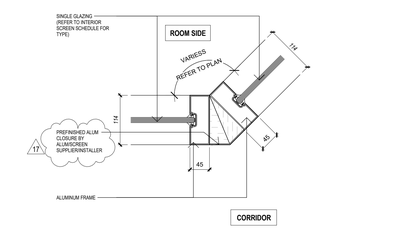

7 A7.90 PLAN DETAIL - ALUMINUM FRAME WITH GLAZING
1 : 5

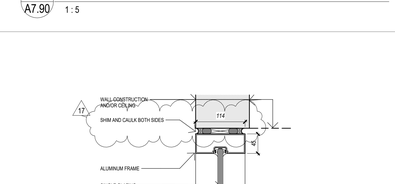

4 A7.90 PLAN/SECTION DETAIL - ALUMINUM FRAME HEAD AND JAMB
1 : 5

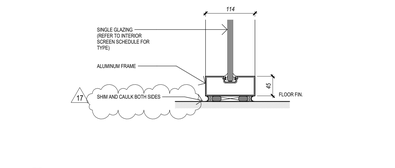

1 A7.90 SECTION DETAIL - ALUMINUM FRAME TYPE BASE
1 : 5

Key to Detail Location

NO. Detail Number
NO. Drawing Number

If this sheet is not 46 7/8" x 33 1/8" (1189 x 841 mm) it is a reduced print - Read dwg. accordingly.

Contractors must check and verify all dimensions on the job and report any discrepancies to the Architect before proceeding with the work.

All prints and specifications are the property of the Architect and must be returned at the completion of the work.

Drawings should not be scaled.

No	Date	Revision/Issued
10	2026 03 13	ISSUED FOR PERMIT
15	2026 07 08	ISSUED FOR TENDER
16	2026 07 17	ISSUED FOR ADDENDA 1
17	2026 07 27	ISSUED FOR ADDENDA 3

consultants

architect CS&P Architects Inc.
2345 Yonge St., Suite 200
Toronto, ON, M4P 2E5
Phone.416.482.5002
Fax.416.482.5040

civil engineer SCS Consulting Group Ltd.
30 Centurian Drive, Suite 100
Markham, ON, L3R 8B8
Phone.905.475.1900
Fax.905.475.8335

structural engineer LEA Consulting Ltd.
40 University Ave, Suite 503
Toronto, ON, M5J 1T1
Phone.905.470.0015

mechanical engineer Smith + Andersen
4211 Yonge Street
Toronto, ON, M2P 2A9
Phone.416.487.8151

electrical engineer Smith + Andersen
4211 Yonge Street
Toronto, ON, M2P 2A9
Phone.416.487.8151

landscape architect Quinn Design Associates Inc.
180 John Street
Toronto, ON, M5T 1X5
Phone.416.962.8700

CS&P Architects

THE STERLING HALL SCHOOL

99 Cartwright Avenue, Toronto, ON M6A 1V4

INTERIOR FRAME DETAILS

scale:	As indicated
date:	10/09/25
drawn:	CS&P
checked by:	CA
project number:	21032
drawing number:	A7.90
	Revision: 17

A0

FILENAME: Autodesk Docs://21032 Sterling Hall/21032_SHS-A-MAIN-25.rvt

DRAWING LAST EDITED: 2026-07-27 4:50:03 PM

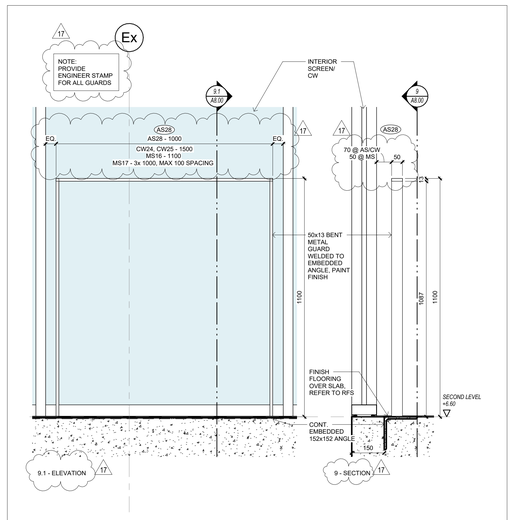

9 A8.00 STEEL GUARDS AT SCREENS
1 : 10

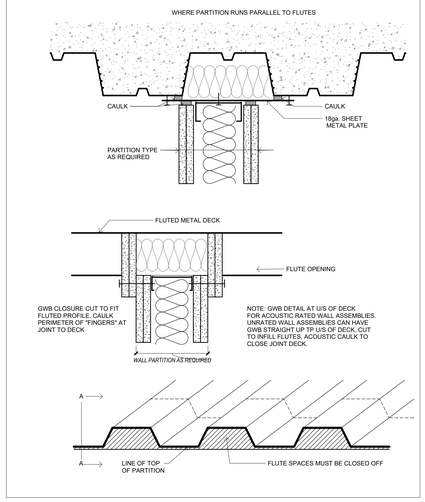

8 A8.00 DETAIL - TYPICAL PARTITION AT FLUTTED DECK
1 : 10

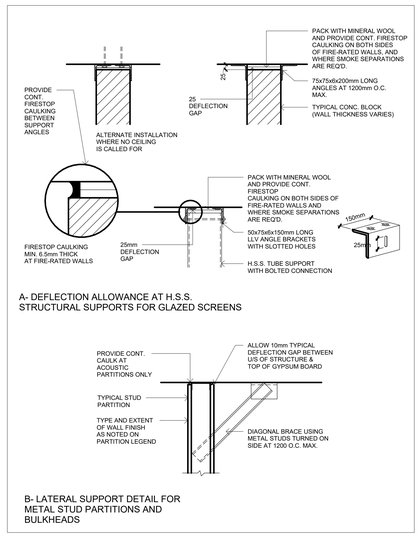

7 A8.00 LATERAL SUPPORT DETAILS
1 : 10

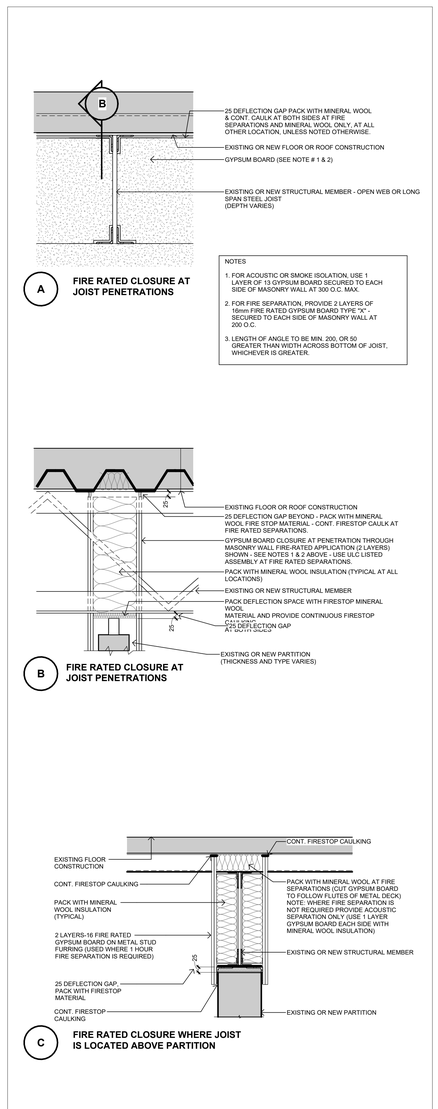

6 A8.00 DETAIL - FIRE RATED PARTITIONS AT DECK/SLAB
1 : 10

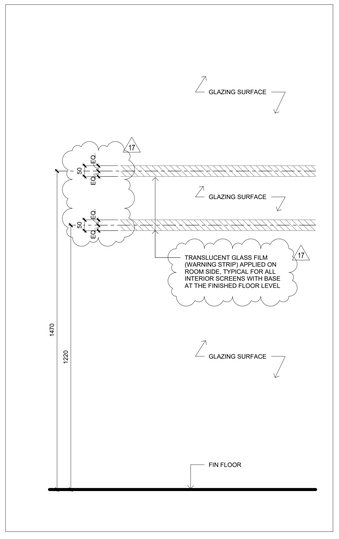

5 A8.00 TYPICAL WARNING STRIP GLAZING DETAIL
1 : 10

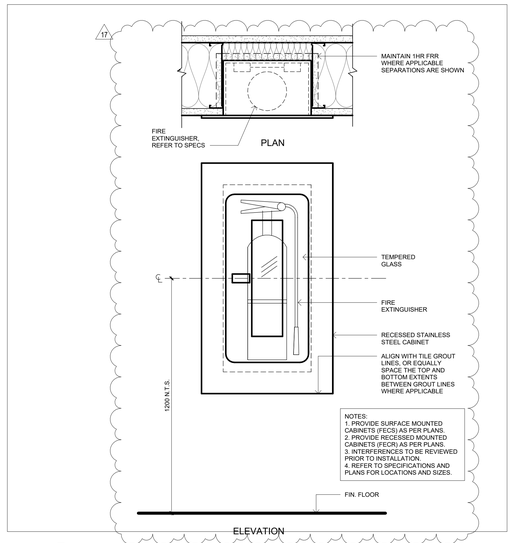

4 A8.00 TYPICAL DETAIL - RECESSED FIRE EXTINGUISHER CABINET
1 : 5

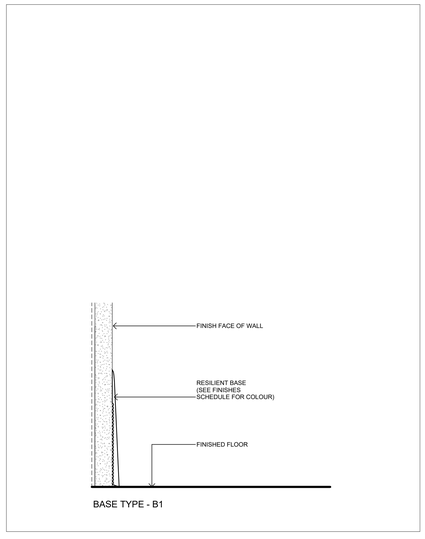

3 A8.00 BASES
1 : 2

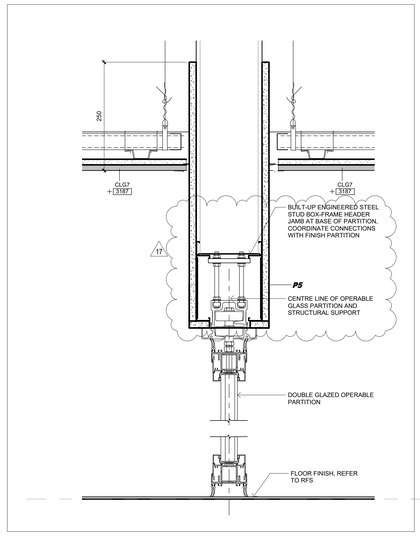

2 A8.00 SECTION DETAIL - TYPICAL FOLDING PARTITON
1 : 5

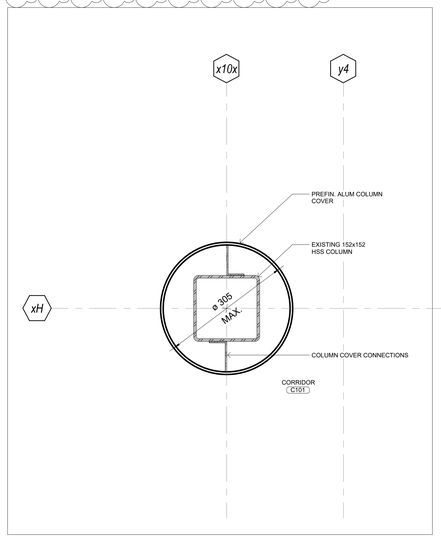

1 A8.00 INT.PLAN DETAIL - COLUMN COVER AT CORRIDOR C101
1 : 5

Key to Detail Location

NO.
NO.
Detail Number
Drawing Number

If this sheet is not 46 7/8" x 33 1/8" (1189 x 841 mm) it is a reduced print - Read dwg. accordingly.

Contractors must check and verify all dimensions on the job and report any discrepancies to the Architect before proceeding with the work.

All prints and specifications are the property of the Architect and must be returned at the completion of the work.

Drawings should not be scaled.

No	Date	Revision/Issued
16	2026 07 17	ISSUED FOR ADDENDA 1
17	2026 07 27	ISSUED FOR ADDENDA 3

consultants

architect
CS&P Architects Inc.
2345 Yonge St., Suite 200
Toronto, ON, M4P 2E5
Phone.416.482.5002
Fax.416.482.5040

civil engineer
SCS Consulting Group Ltd.
30 Centurian Drive, Suite 100
Markham, ON, L3R 8B8
Phone.905.475.1900
Fax.905.475.8335

structural engineer
LEA Consulting Ltd.
40 University Ave, Suite 503
Toronto, ON, M5J 1T1
Phone.905.470.0015

mechanical engineer
Smith + Andersen
4211 Yonge Street
Toronto, ON, M2P 2A9
Phone.416.487.8151

electrical engineer
Smith + Andersen
4211 Yonge Street
Toronto, ON, M2P 2A9
Phone.416.487.8151

landscape architect
Quinn Design Associates Inc.
180 John Street
Toronto, ON, M5T 1X5
Phone.416.962.8700

PROJECT NORTH

SHS CS&P Architects

THE STERLING HALL SCHOOL

99 Cartwright Avenue, Toronto, ON M6A 1V4

TYPICAL DETAILS

scale:	As indicated
date:	08/14/19
drawn:	CS&P
checked by:	CA
project number:	21032
drawing number:	A8.00
	Revision: 17

A0

FILENAME: Autodesk Docs://21032 Sterling Hall/21032_SHS-A-MAIN-25.rvt

DRAWING LAST EDITED: 2026-07-27 4:50:06 PM

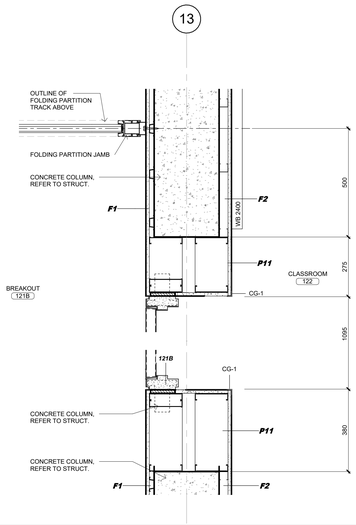

7 A8.10 INT.PLAN DETAIL - BREAKROOM AND CLASSROOM TYP.

1 : 10

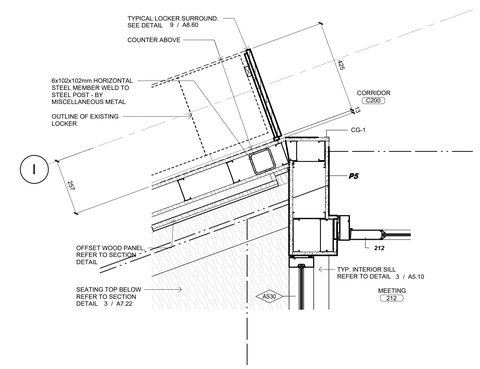

6 A8.10 INT. PLAN DETAIL - LOCKER AT MEETING ROOM 202

1 : 10

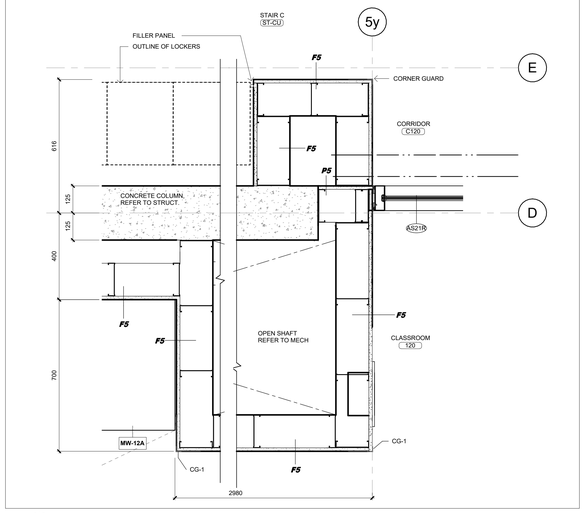

5 A8.10 INT.PLAN DETAIL - AT STAIR C GRID 5y/L

1 : 10

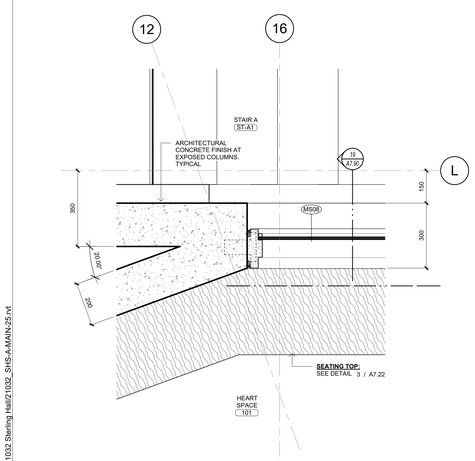

4 A8.10 INT.PLAN DEAIL - AT STAIR A GRID 16/L

1 : 10

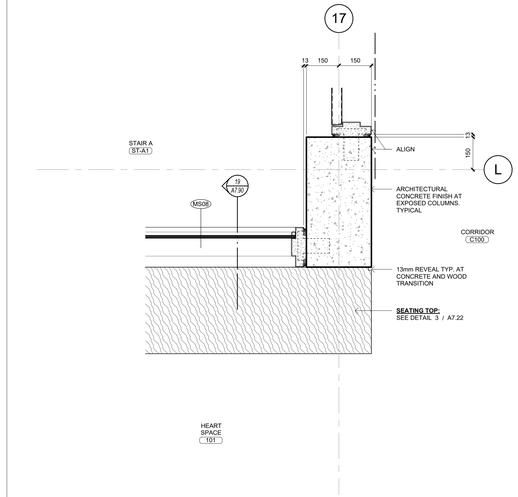

3 A8.10 INT.PLAN DETAIL - AT STAIR A GRID 17/L

1 : 10

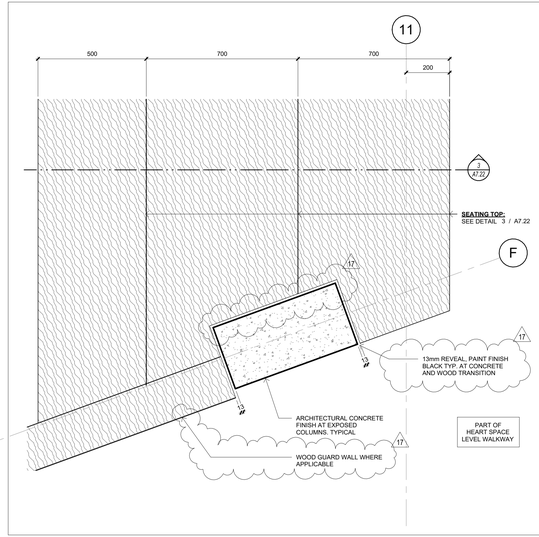

2 A8.10 INT.PLAN DETAIL - SEATING TOP AT LEVEL WALKWAY

1 : 10

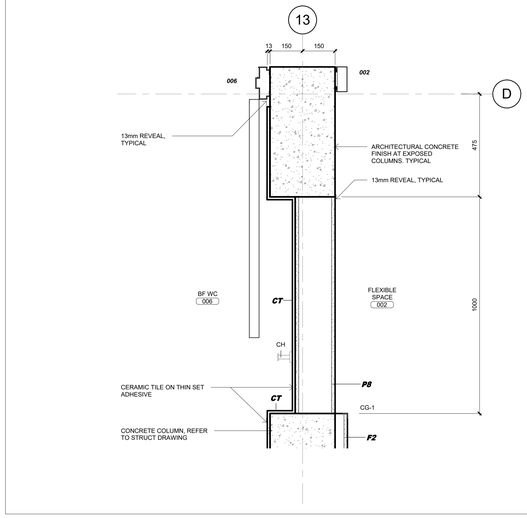

1 A8.10 INT. PLAN DETAIL - CERAMIC TILE AT BF WC 006

1 : 10

Key to Detail Location

NO. Detail Number
NO. Drawing Number

If this sheet is not 46 7/8" x 33 1/8" (1189 x 841 mm) it is a reduced print - Read dwg. accordingly.

Contractors must check and verify all dimensions on the job and report any discrepancies to the Architect before proceeding with the work.

All prints and specifications are the property of the Architect and must be returned at the completion of the work.

Drawings should not be scaled.

No	Date	Revision/Issued
16	2026 07 17	ISSUED FOR ADDENDA 1
17	2026 07 27	ISSUED FOR ADDENDA 3

consultants

architect
CS&P Architects Inc.
2345 Yonge St., Suite 200
Toronto, ON, M4P 2E5
Phone.416.482.5002
Fax.416.482.5040

civil engineer
SCS Consulting Group Ltd.
30 Centurian Drive, Suite 100
Markham, ON, L3R 8B8
Phone.905.475.1900
Fax.905.475.8335

structural engineer
LEA Consulting Ltd.
40 University Ave, Suite 503
Toronto, ON, M5J 1T1
Phone.905.470.0015

mechanical engineer
Smith + Andersen
4211 Yonge Street
Toronto, ON, M2P 2A9
Phone.416.487.8151

electrical engineer
Smith + Andersen
4211 Yonge Street
Toronto, ON, M2P 2A9
Phone.416.487.8151

landscape architect
Quinn Design Associates Inc.
180 John Street
Toronto, ON, M5T 1X5
Phone.416.962.8700

PROJECT NORTH N

SHS CS&P Architects

THE STERLING HALL SCHOOL

99 Cartwright Avenue, Toronto, ON M6A 1V4

INTERIOR PLAN DETAILS

scale:	1 : 10
date:	10/16/20
drawn:	CS&P
checked by:	CA
project number:	21032
drawing number:	A8.10
Revision:	17

A0

FILENAME: Autodesk Docs://21032 Sterling Hall/21032_SHS-A-MAIN-25.rvt

DRAWING LAST EDITED: 2026-07-27 4:50:11 PM

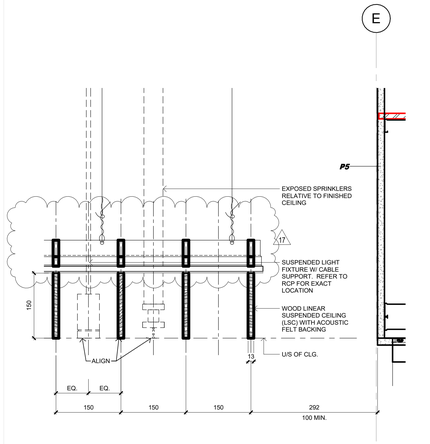

15 A8.20 TYP. SECTION DETAIL - CLG5 LINEAR SUSPENDED CEILING (LSC)
1 : 5

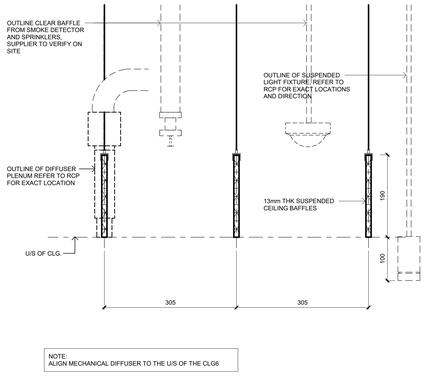

NOTE:
ALIGN MECHANICAL DIFFUSER TO THE U/S OF THE CLG6

14 A8.20 TYP. SECTION DETAIL - CLG6 LOWER LEVEL CEILING BAFFLE
1 : 5

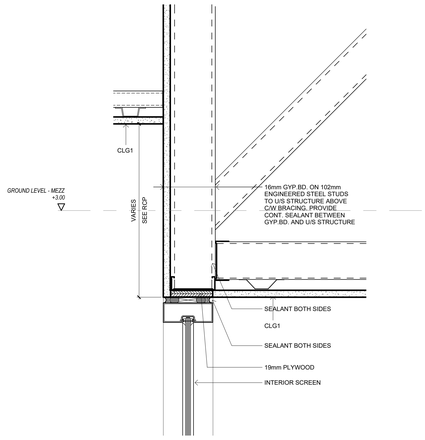

13 A8.20 SECTION DETAIL - INT. SCREEN HEADER @ CEILING HEIGHT CHANGE
1 : 5

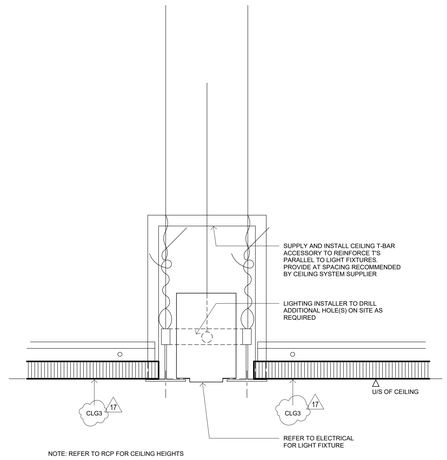

NOTE: REFER TO RCP FOR CEILING HEIGHTS

12 A8.20 TYPICAL DETAIL - RECESSED LIGHT SUPPORT IN ACT CEILING
1 : 2

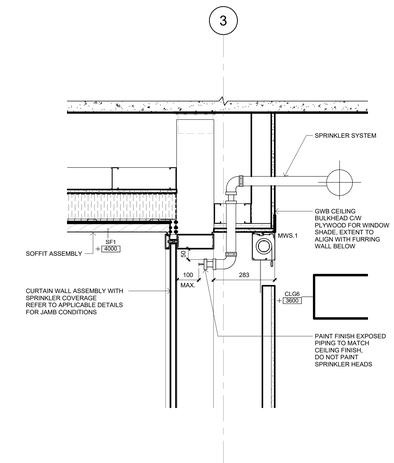

11 A8.20 SECTION SPRINKLER AT LOWER LEVEL CURTAIN WALL
1 : 10

10 A8.20 SECTION SPRINKLER AT WINDOW
1 : 10

9 A8.20 SECTION DELUGE SPRINKLER BULKHEADS AT INTERIOR SCREENS
1 : 10

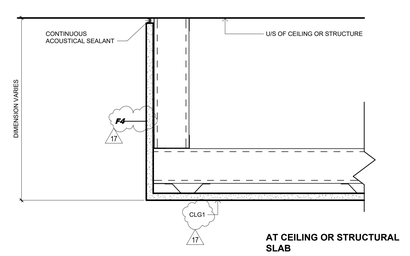

AT METAL DECK CONDITION

AT CEILING OR STRUCTURAL SLAB

8 A8.20 TYPICAL GYPSUM BOARD BULKHEAD DETAIL
1 : 5

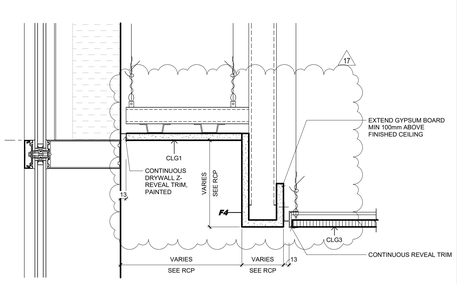

7 A8.20 TYPICAL CEILING COVE DETAIL ALONG CURTAINWALL
1 : 5

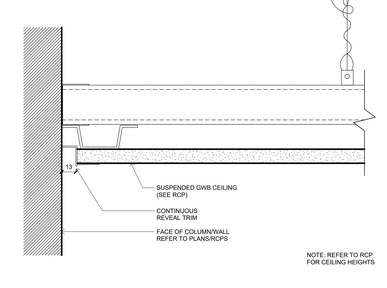

NOTE: REFER TO RCP FOR CEILING HEIGHTS

6 A8.20 TYPICAL REVEAL AT AT WALL + COLUMN GYPSUM BOARD CEILING
1 : 2

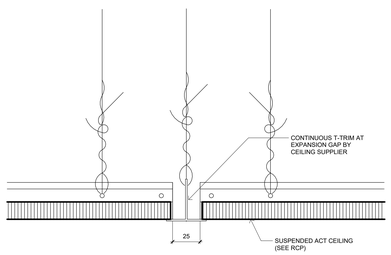

5 A8.20 TYPICAL SECTION DETAIL EXPANSION JOINT AT ACT CEILING
1 : 2

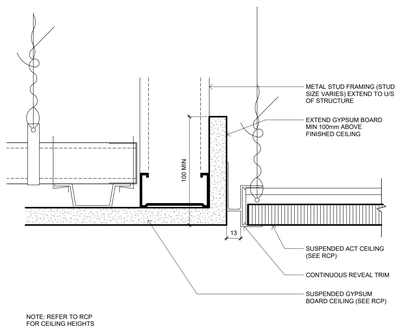

NOTE: REFER TO RCP FOR CEILING HEIGHTS

4 A8.20 TYPICAL SECTION TRANSITION AT CEILING TYPE CHANGE
1 : 2

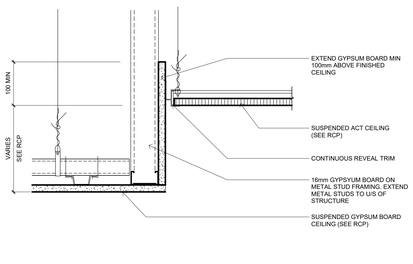

3 A8.20 TYPICAL SECTION DETAIL GB CEILING TO ACT W HEIGHT DIFFERENCE
1 : 5

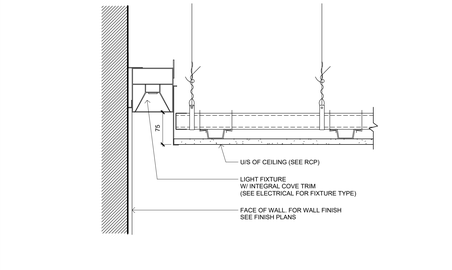

2 A8.20 TYPICAL LIGHT COVE SECTION DETAIL (LCV)
1 : 5

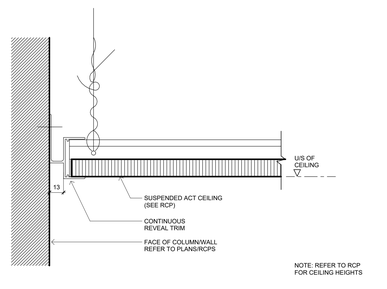

NOTE: REFER TO RCP FOR CEILING HEIGHTS

1 A8.20 TYPICAL REVEAL AT WALL + COLUMN WITH ACOUSTIC CEILING TILE
1 : 2

Key to Detail Location

NO. — Detail Number
NO. — Drawing Number

If this sheet is not 46 7/8" x 33 1/8" (1189 x 841 mm) it is a reduced print - Read dwg. accordingly.

Contractors must check and verify all dimensions on the job and report any discrepancies to the Architect before proceeding with the work.

All prints and specifications are the property of the Architect and must be returned at the completion of the work.

Drawings should not be scaled.

No	Date	Revision/Issued
11	2026 04 10	75% CD FOR CLIENT REVIEW
14	2026 05 15	90% CD FOR CLIENT REVIEW
15	2026 07 08	ISSUED FOR TENDER
16	2026 07 17	ISSUED FOR ADDENDA 1
17	2026 07 27	ISSUED FOR ADDENDA 3

consultants

architect
CS&P Architects Inc.
2345 Yonge St., Suite 200
Toronto, ON, M4P 2E5
Phone.416.482.5002
Fax.416.482.5040

civil engineer
SCS Consulting Group Ltd.
30 Centurian Drive, Suite 100
Markham, ON, L3R 8B8
Phone.905.475.1900
Fax.905.475.8335

structural engineer
LEA Consulting Ltd.
40 University Ave, Suite 503
Toronto, ON, M5J 1T1
Phone.905.470.0015

mechanical engineer
Smith + Andersen
4211 Yonge Street
Toronto, ON, M2P 2A9
Phone.416.487.8151

electrical engineer
Smith + Andersen
4211 Yonge Street
Toronto, ON, M2P 2A9
Phone.416.487.8151

landscape architect
Quinn Design Associates Inc.
180 John Street
Toronto, ON, M5T 1X5
Phone.416.962.8700

SHS CS&P Architects

THE STERLING HALL SCHOOL

99 Cartwright Avenue, Toronto, ON M6A 1V4

CEILING DETAILS

scale:	As indicated
date:	10/16/20
drawn:	CS&P
checked by:	CA
project number:	21032
drawing number:	A8.20
	Revision:17

A0

FILENAME: Autodesk Docs://21032 Sterling Hall/21032_SHS-A-MAIN-25.rvt

_DRAWING LAST EDITED: 2026-07-27 4:50:15 PM

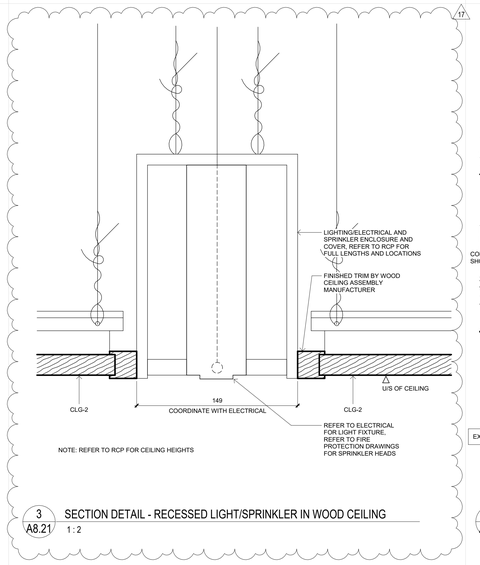

3 A8.21 SECTION DETAIL - RECESSED LIGHT/SPRINKLER IN WOOD CEILING

1 : 2

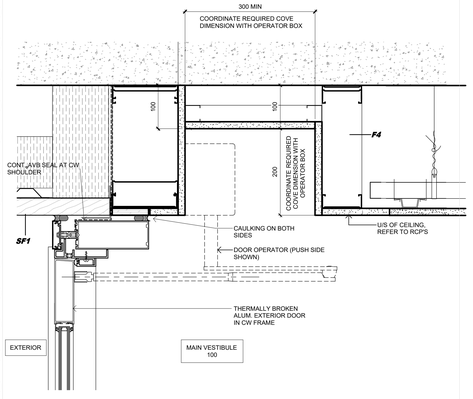

2 A8.21 SECTION COVE AT DOOR X100 A/B

1 : 5

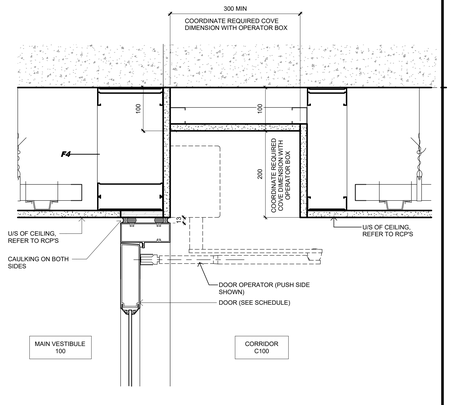

1 A8.21 SECTION COVE AT DOOR 100 A/B

1 : 5

Key to Detail Location

NO.
NO.
Detail Number
Drawing Number

If this sheet is not 46 7/8" x 33 1/8" (1189 x 841 mm) it is a reduced print - Read dwg. accordingly.

Contractors must check and verify all dimensions on the job and report any discrepancies to the Architect before proceeding with the work.

All prints and specifications are the property of the Architect and must be returned at the completion of the work.

Drawings should not be scaled.

No	Date	Revision/Issued
16	2026 07 17	ISSUED FOR ADDENDA 1
17	2026 07 27	ISSUED FOR ADDENDA 3

consultants

architect — CS&P Architects Inc.
2345 Yonge St., Suite 200
Toronto, ON, M4P 2E5
Phone.416.482.5002
Fax.416.482.5040

civil engineer — SCS Consulting Group Ltd.
30 Centurian Drive, Suite 100
Markham, ON, L3R 8B8
Phone.905.475.1900
Fax.905.475.8335

structural engineer — LEA Consulting Ltd.
40 University Ave, Suite 503
Toronto, ON, M5J 1T1
Phone.905.470.0015

mechanical engineer — Smith + Andersen
4211 Yonge Street
Toronto, ON, M2P 2A9
Phone.416.487.8151

electrical engineer — Smith + Andersen
4211 Yonge Street
Toronto, ON, M2P 2A9
Phone.416.487.8151

landscape architect — Quinn Design Associates Inc.
180 John Street
Toronto, ON, M5T 1X5
Phone.416.962.8700

PROJECT NORTH

SHS CS&P Architects

THE STERLING HALL SCHOOL

99 Cartwright Avenue, Toronto, ON M6A 1V4

CEILING DETAILS

scale:	As indicated
date:	07/09/26
drawn:	ET
checked by:	CA
project number:	21032
drawing number:	A8.21
	Revision: 17

A0

FILENAME: Autodesk Docs://21032 Sterling Hall/21032_SHS-A-MAIN-25.rvt

DRAWING LAST EDITED: 2026-07-27 4:50:16 PM

3D VIEW

THE 3D VIEW /PERSPECTIVE IS FOR REFERENCE ONLY AND DOES NOT FORM PART OF THE CONTRACT. IT IS INCLUDED TO SHOW THE GENERAL DESIGN INTENT FOR COORDINATION PURPOSES ONLY. THE FINAL PRODUCT MAY NOT BE AS EXACTLY AS SHOWN.

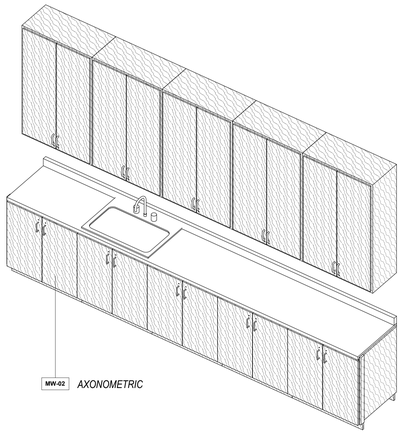

MW-02 *AXONOMETRIC*

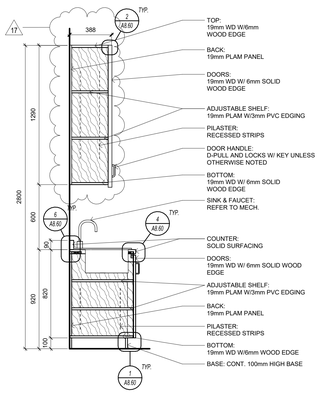

2.5 SECTION

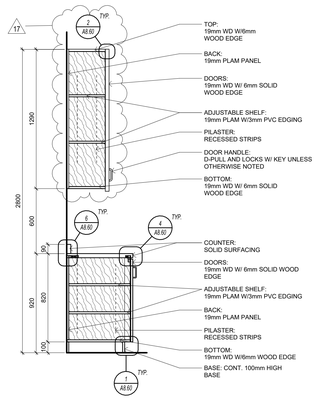

2.4 SECTION

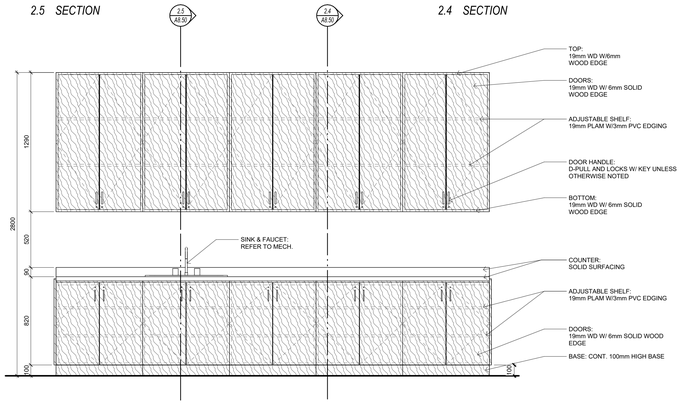

2.3 ELEVATION

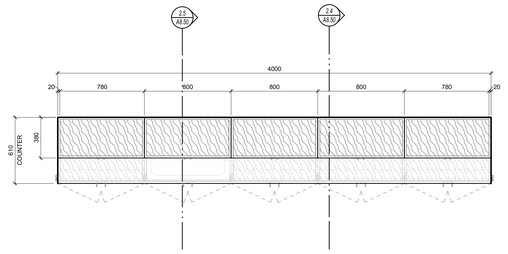

2.2 UPPER PLAN

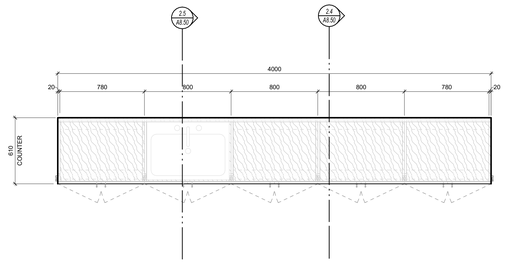

2.1 PLAN

2 A8.50 MW-02

3D VIEW

THE 3D VIEW /PERSPECTIVE IS FOR REFERENCE ONLY AND DOES NOT FORM PART OF THE CONTRACT. IT IS INCLUDED TO SHOW THE GENERAL DESIGN INTENT FOR COORDINATION PURPOSES ONLY. THE FINAL PRODUCT MAY NOT BE AS EXACTLY AS SHOWN.

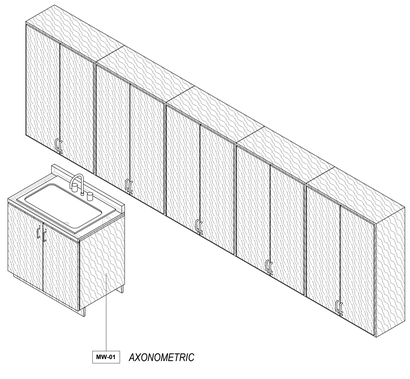

MW-01 *AXONOMETRIC*

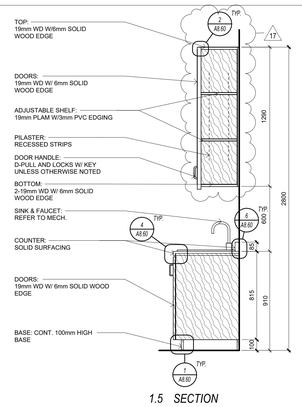

1.5 SECTION

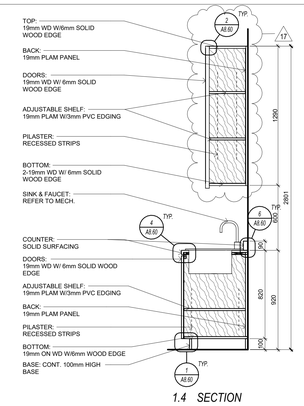

1.4 SECTION

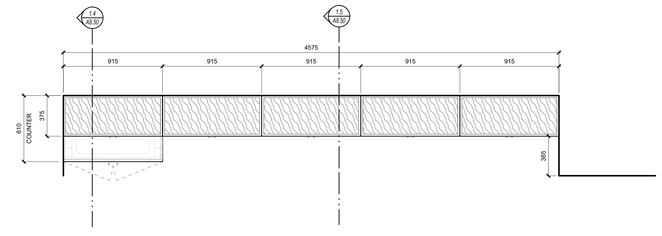

1.2 UPPER PLAN

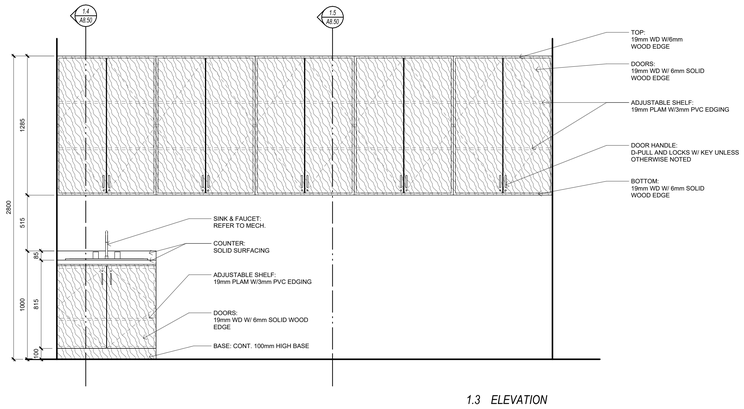

1.3 ELEVATION

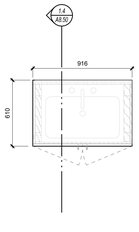

1.1 PLAN

1 A8.50 MW-01

Key to Detail Location

NO. / NO. — Detail Number / Drawing Number

If this sheet is not 46 7/8" x 33 1/8" (1189 x 841 mm) it is a reduced print - Read dwg. accordingly.

Contractors must check and verify all dimensions on the job and report any discrepancies to the Architect before proceeding with the work.

All prints and specifications are the property of the Architect and must be returned at the completion of the work.

Drawings should not be scaled.

No	Date	Revision/Issued
15	2026 07 08	ISSUED FOR TENDER
17	2026 07 27	ISSUED FOR ADDENDA 3

consultants

architect — CS&P Architects Inc., 2345 Yonge St., Suite 200, Toronto, ON, M4P 2E5, Phone.416.482.5002, Fax.416.482.5040

civil engineer — SCS Consulting Group Ltd., 30 Centurian Drive, Suite 100, Markham, ON, L3R 8B8, Phone.905.475.1900, Fax.905.475.8335

structural engineer — LEA Consulting Ltd., 40 University Ave, Suite 503, Toronto, ON, M5J 1T1, Phone.905.470.0015

mechanical engineer — Smith + Andersen, 4211 Yonge Street, Toronto, ON, M2P 2A9, Phone.416.487.8151

electrical engineer — Smith + Andersen, 4211 Yonge Street, Toronto, ON, M2P 2A9, Phone.416.487.8151

landscape architect — Quinn Design Associates Inc., 180 John Street, Toronto, ON, M5T 1X5, Phone.416.962.8700

SHS CS&P Architects

THE STERLING HALL SCHOOL

99 Cartwright Avenue, Toronto, ON M6A 1V4

MILLWORK

scale:	1 : 20
date:	06/01/26
drawn:	CS&P
checked by:	CA
project number:	21032
drawing number:	A8.50
Revision:	17

A0

FILENAME: Autodesk Docs://21032 Sterling Hall/21032_SHS-A-MAIN-25.rvt

_DRAWING LAST EDITED: 2026-07-27 4:50:20 PM

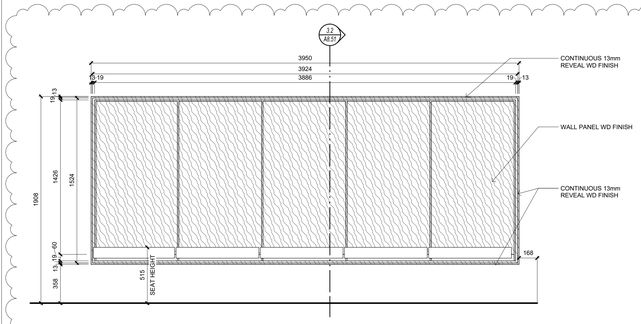

3D VIEW

THE 3D VIEW /PERSPECTIVE IS FOR REFERENCE ONLY AND DOES NOT FORM PART OF THE CONTRACT. IT IS INCLUDED TO SHOW THE GENERAL DESIGN INTENT FOR COORDINATION PURPOSES ONLY. THE FINAL PRODUCT MAY NOT BE AS EXACTLY AS SHOWN.

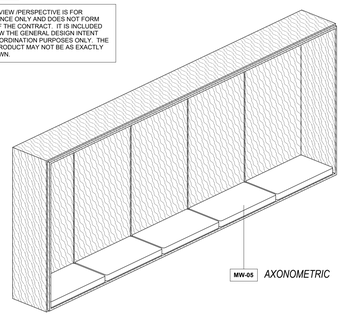

MW-05 AXONOMETRIC

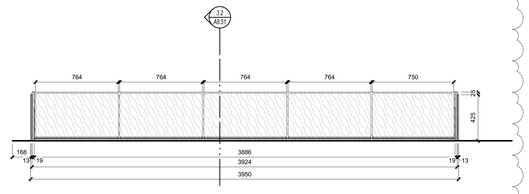

3 A8.51 MW-05

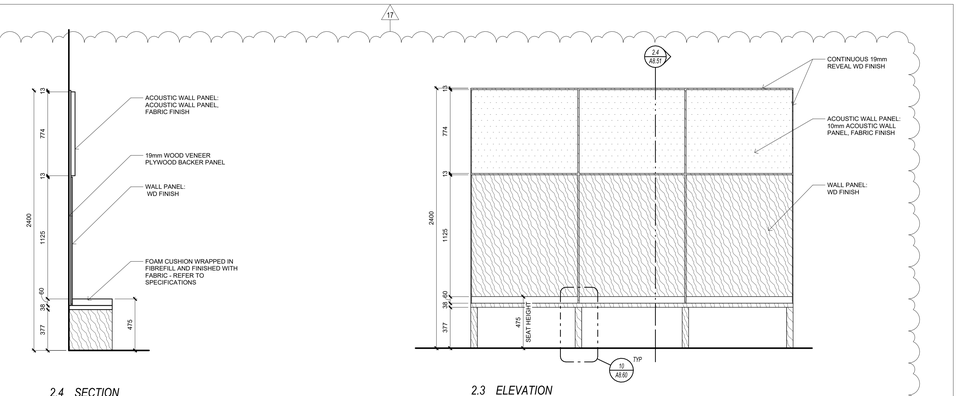

3D VIEW

THE 3D VIEW /PERSPECTIVE IS FOR REFERENCE ONLY AND DOES NOT FORM PART OF THE CONTRACT. IT IS INCLUDED TO SHOW THE GENERAL DESIGN INTENT FOR COORDINATION PURPOSES ONLY. THE FINAL PRODUCT MAY NOT BE AS EXACTLY AS SHOWN.

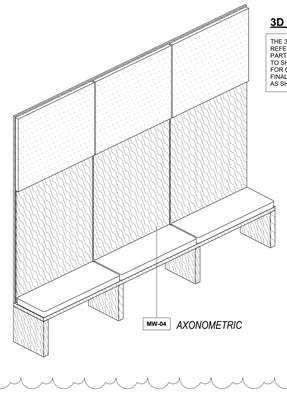

MW-04 AXONOMETRIC

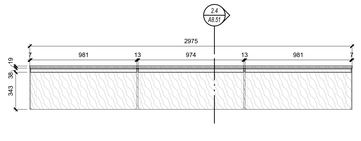

2 A8.51 MW-04

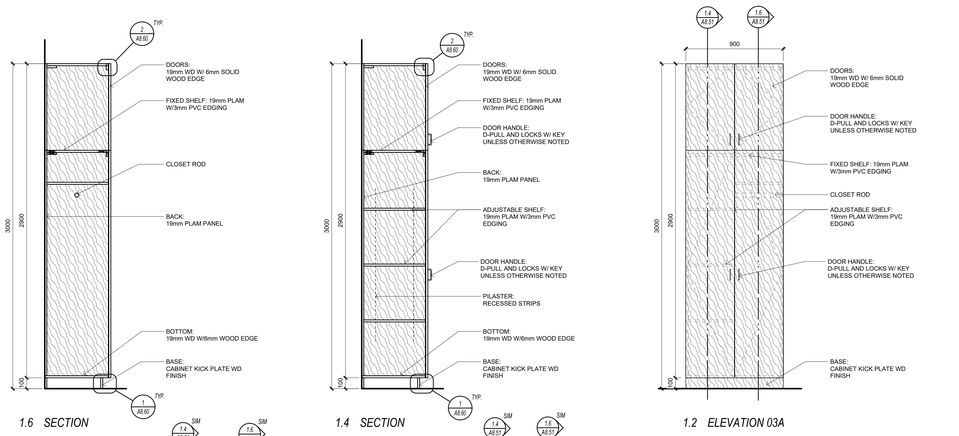

3D VIEW

THE 3D VIEW /PERSPECTIVE IS FOR REFERENCE ONLY AND DOES NOT FORM PART OF THE CONTRACT. IT IS INCLUDED TO SHOW THE GENERAL DESIGN INTENT FOR COORDINATION PURPOSES ONLY. THE FINAL PRODUCT MAY NOT BE AS EXACTLY AS SHOWN.

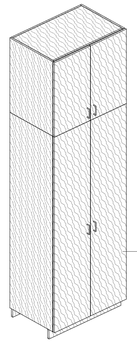

MW-03A AXONOMETRIC

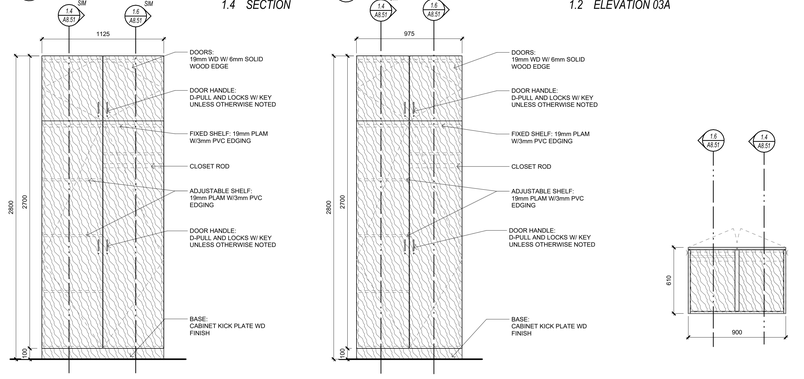

1 A8.51 MW-03A, MW-03B AND MW-03C

Key to Detail Location

NO. Detail Number
NO. Drawing Number

If this sheet is not 46 7/8" x 33 1/8" (1189 x 841 mm) it is a reduced print - Read dwg. accordingly.

Contractors must check and verify all dimensions on the job and report any discrepancies to the Architect before proceeding with the work.

All prints and specifications are the property of the Architect and must be returned at the completion of the work.

Drawings should not be scaled.

No	Date	Revision/Issued
15	2026 07 08	ISSUED FOR TENDER
16	2026 07 17	ISSUED FOR ADDENDA 1
17	2026 07 27	ISSUED FOR ADDENDA 3

consultants

architect
CS&P Architects Inc.
2345 Yonge St., Suite 200
Toronto, ON, M4P 2E5
Phone.416.482.5002
Fax.416.482.5040

civil engineer
SCS Consulting Group Ltd.
30 Centurian Drive, Suite 100
Markham, ON, L3R 8B8
Phone.905.475.1900
Fax.905.475.8335

structural engineer
LEA Consulting Ltd.
40 University Ave, Suite 503
Toronto, ON, M5J 1T1
Phone.905.470.0015

mechanical engineer
Smith + Andersen
4211 Yonge Street
Toronto, ON, M2P 2A9
Phone.416.487.8151

electrical engineer
Smith + Andersen
4211 Yonge Street
Toronto, ON, M2P 2A9
Phone.416.487.8151

landscape architect
Quinn Design Associates Inc.
180 John Street
Toronto, ON, M5T 1X5
Phone.416.962.8700

SHS CS&P Architects

THE STERLING HALL SCHOOL

99 Cartwright Avenue, Toronto, ON M6A 1V4

MILLWORK

scale:	1 : 20
date:	06/01/26
drawn:	CS&P
checked by:	CA
project number:	21032
drawing number:	A8.51
	Revision: 17

A0

FILENAME: Autodesk Docs://21032 Sterling Hall/21032_SHS-A-MAIN-25.rvt

DRAWING LAST EDITED: 2026-07-27 4:50:24 PM

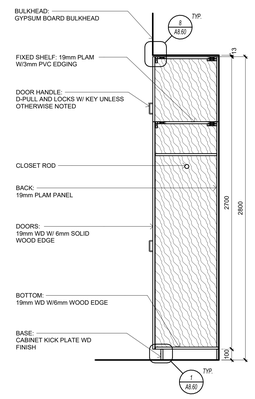

1.5 SECTION

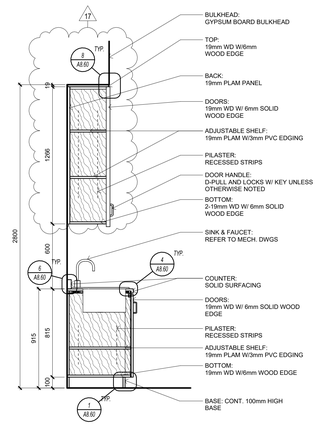

1.4 SECTION

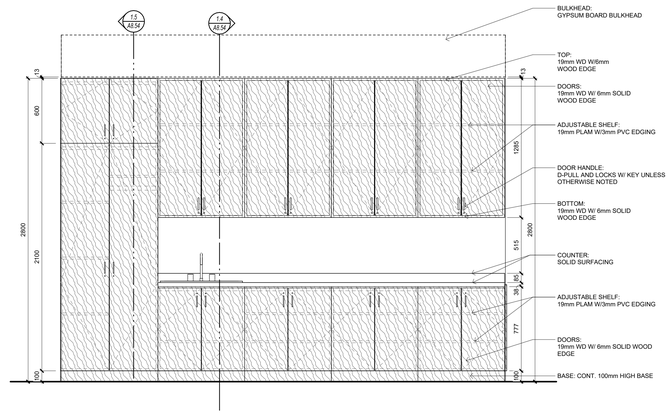

1.3 ELEVATION

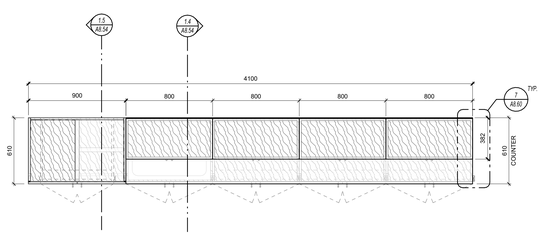

1.2 UPPER PLAN

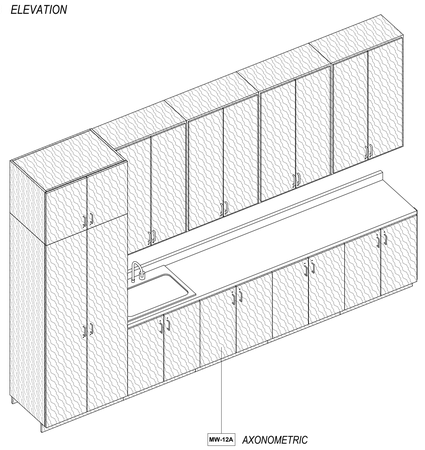

MW-12A *AXONOMETRIC*

3D VIEW

THE 3D VIEW /PERSPECTIVE IS FOR REFERENCE ONLY AND DOES NOT FORM PART OF THE CONTRACT. IT IS INCLUDED TO SHOW THE GENERAL DESIGN INTENT FOR COORDINATION PURPOSES ONLY. THE FINAL PRODUCT MAY NOT BE AS EXACTLY AS SHOWN.

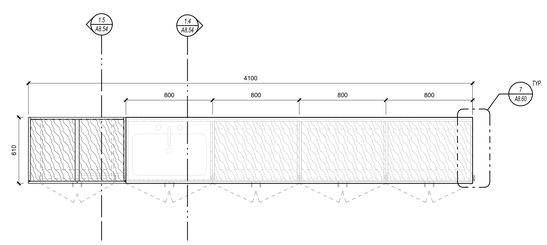

1.1 PLAN

Key to Detail Location

NO.
NO.
Detail Number
Drawing Number

If this sheet is not 46 7/8" x 33 1/8" (1189 x 841 mm) it is a reduced print - Read dwg. accordingly.

Contractors must check and verify all dimensions on the job and report any discrepancies to the Architect before proceeding with the work.

All prints and specifications are the property of the Architect and must be returned at the completion of the work.

Drawings should not be scaled.

No	Date	Revision/Issued
15	2026 07 08	ISSUED FOR TENDER
16	2026 07 17	ISSUED FOR ADDENDA 1
17	2026 07 27	ISSUED FOR ADDENDA 3

consultants

architect
CS&P Architects Inc.
2345 Yonge St., Suite 200
Toronto, ON, M4P 2E5
Phone.416.482.5002
Fax.416.482.5040

civil engineer
SCS Consulting Group Ltd.
30 Centurian Drive, Suite 100
Markham, ON, L3R 8B8
Phone.905.475.1900
Fax.905.475.8335

structural engineer
LEA Consulting Ltd.
40 University Ave, Suite 503
Toronto, ON, M5J 1T1
Phone.905.470.0015

mechanical engineer
Smith + Andersen
4211 Yonge Street
Toronto, ON, M2P 2A9
Phone.416.487.8151

electrical engineer
Smith + Andersen
4211 Yonge Street
Toronto, ON, M2P 2A9
Phone.416.487.8151

landscape architect
Quinn Design Associates Inc.
160 John Street
Toronto, ON, M5T 1X5
Phone.416.962.8700

CS&P Architects

THE STERLING HALL SCHOOL

99 Cartwright Avenue, Toronto, ON M6A 1V4

MILLWORK

scale:	1 : 20
date:	06/01/26
drawn:	CS&P
checked by:	CA
project number:	21032
drawing number:	A8.54
	Revision: 17

1
A8.54
MW-12A

A0

FILENAME: Autodesk Docs://21032 Sterling Hall/21032_SHS-A-MAIN-25.rvt

DRAWING LAST EDITED: 2026-07-27 4:50:31 PM

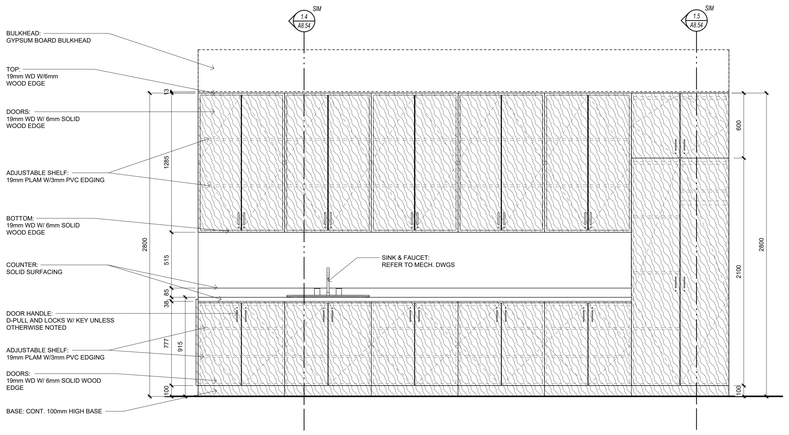

1.8 ELEVATION MW-12E

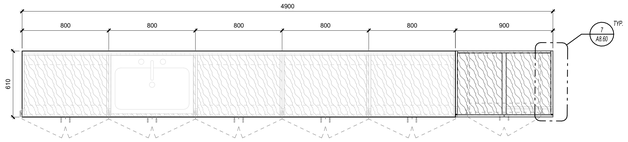

1.7 PLAN MW-12E

1.6 ELEVATION MW-12D

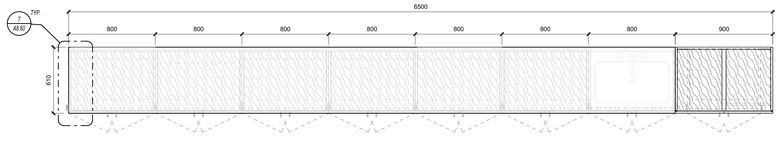

1.5 PLAN MW-12D

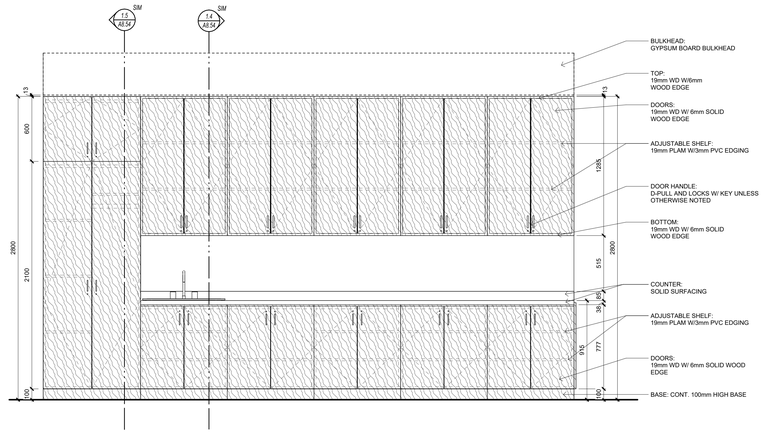

1.4 ELEVATION MW-12C

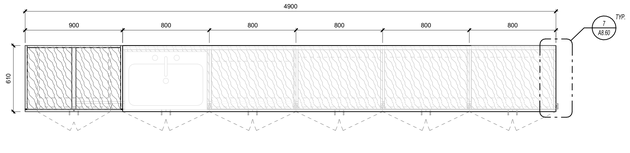

1.3 PLAN MW-12C

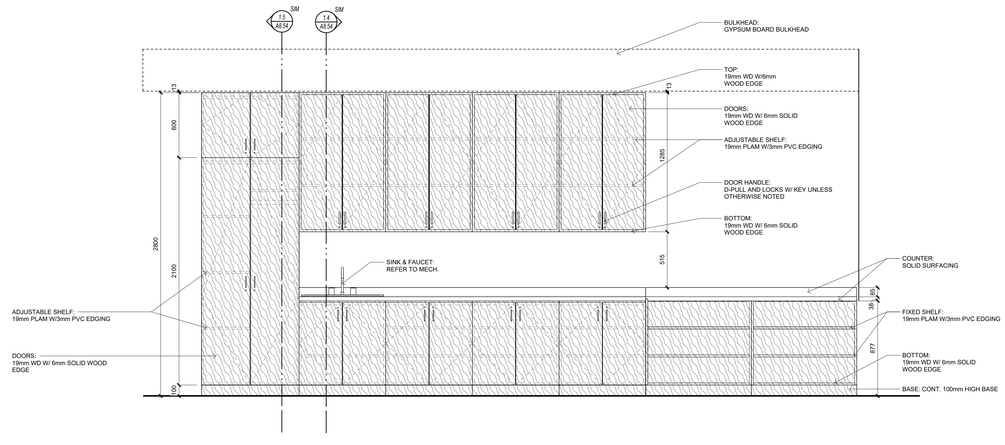

1.2 ELEVATION MW-12B

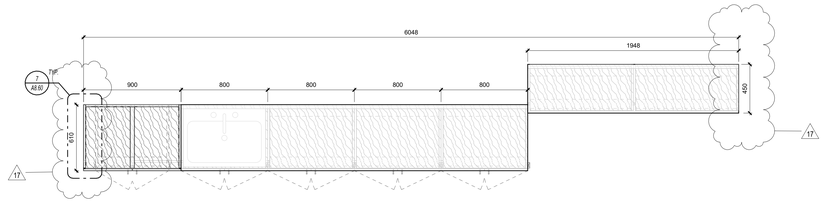

1.1 PLAN MW-12B

Key to Detail Location

NO.
NO.
Detail Number
Drawing Number

If this sheet is not 46 7/8" x 33 1/8" (1189 x 841 mm) it is a reduced print - Read dwg. accordingly.

Contractors must check and verify all dimensions on the job and report any discrepancies to the Architect before proceeding with the work.

All prints and specifications are the property of the Architect and must be returned at the completion of the work.

Drawings should not be scaled.

No	Date	Revision/Issued
15	2026 07 08	ISSUED FOR TENDER
16	2026 07 17	ISSUED FOR ADDENDA 1
17	2026 07 27	ISSUED FOR ADDENDA 3

consultants

architect
CS&P Architects Inc.
2345 Yonge St., Suite 200
Toronto, ON, M4P 2E5
Phone.416.482.5002
Fax.416.482.5040

civil engineer
SCS Consulting Group Ltd.
30 Centurian Drive, Suite 100
Markham, ON, L3R 8B8
Phone.905.475.1900
Fax.905.475.8335

structural engineer
LEA Consulting Ltd.
40 University Ave, Suite 503
Toronto, ON, M5J 1T1
Phone.905.470.0015

mechanical engineer
Smith + Andersen
4211 Yonge Street
Toronto, ON, M2P 2A9
Phone.416.487.8151

electrical engineer
Smith + Andersen
4211 Yonge Street
Toronto, ON, M2P 2A9
Phone.416.487.8151

landscape architect
Quinn Design Associates Inc.
180 John Street
Toronto, ON, M5T 1X5
Phone.416.962.8700

SHS
CS&P Architects

THE STERLING HALL SCHOOL

99 Cartwright Avenue, Toronto, ON M6A 1V4

MILLWORK

scale:	1 : 20
date:	06/01/26
drawn:	CS&P
checked by:	CA
project number:	21032
drawing number:	A8.55
	Revision: 17

1 / A8.55 MW-12B, MW-12C, MW-12D AND MW-12E
1 : 20

A0

FILENAME: Autodesk Docs://21032 Sterling Hall/21032_SHS-A-MAIN-25.rvt

DRAWING LAST EDITED: 2026-07-27 4:50:34 PM

3D VIEW

THE 3D VIEW /PERSPECTIVE IS FOR REFERENCE ONLY AND DOES NOT FORM PART OF THE CONTRACT. IT IS INCLUDED TO SHOW THE GENERAL DESIGN INTENT FOR COORDINATION PURPOSES ONLY. THE FINAL PRODUCT MAY NOT BE AS EXACTLY AS SHOWN.

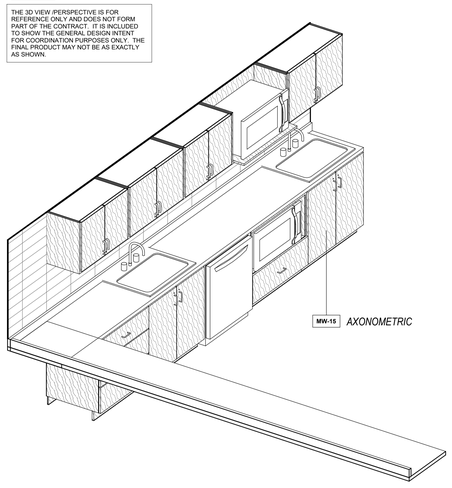

MW-15 *AXONOMETRIC*

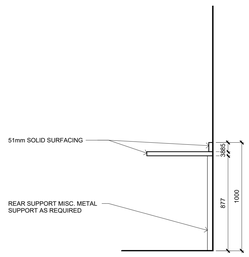

3.5 SECTION

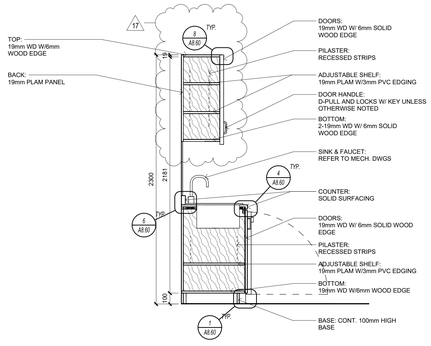

3.4 SECTION

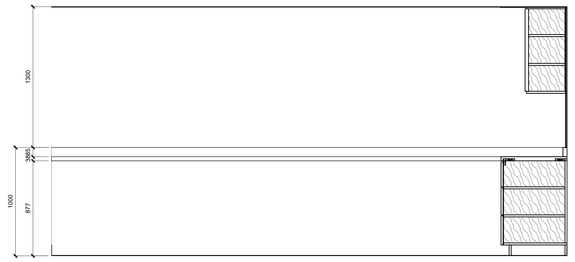

3.3 ELEVATION 2

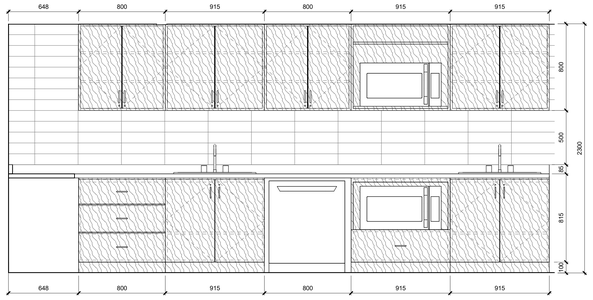

3.2 ELEVATION

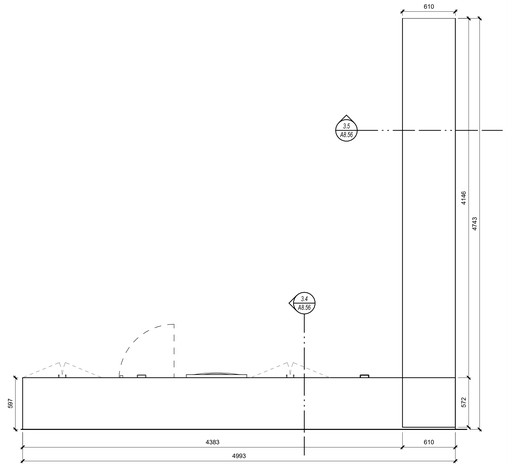

3.1 PLAN

Key to Detail Location

NO. / NO. — Detail Number / Drawing Number

If this sheet is not 46 7/8" x 33 1/8" (1189 x 841 mm) it is a reduced print - Read dwg. accordingly.

Contractors must check and verify all dimensions on the job and report any discrepancies to the Architect before proceeding with the work.

All prints and specifications are the property of the Architect and must be returned at the completion of the work.

Drawings should not be scaled.

No	Date	Revision/Issued
15	2026 07 08	ISSUED FOR TENDER
16	2026 07 17	ISSUED FOR ADDENDA 1
17	2026 07 27	ISSUED FOR ADDENDA 3

consultants

architect — CS&P Architects Inc.
2345 Yonge St., Suite 200
Toronto, ON, M4P 2E5
Phone.416.482.5002
Fax.416.482.5040

civil engineer — SCS Consulting Group Ltd.
30 Centurian Drive, Suite 100
Markham, ON, L3R 8B8
Phone.905.475.1900
Fax.905.475.8335

structural engineer — LEA Consulting Ltd.
40 University Ave, Suite 503
Toronto, ON, M5J 1T1
Phone.905.470.0015

mechanical engineer — Smith + Andersen
4211 Yonge Street
Toronto, ON, M2P 2A9
Phone.416.487.8151

electrical engineer — Smith + Andersen
4211 Yonge Street
Toronto, ON, M2P 2A9
Phone.416.487.8151

landscape architect — Quinn Design Associates Inc.
180 John Street
Toronto, ON, M5T 1X5
Phone.416.962.8700

CS&P Architects

THE STERLING HALL SCHOOL

99 Cartwright Avenue, Toronto, ON M6A 1V4

MILLWORK

scale:	As indicated
date:	06/01/26
drawn:	CS&P
checked by:	CA
project number:	21032
drawing number:	A8.56
	Revision: 17

3 / A8.56 MW-15

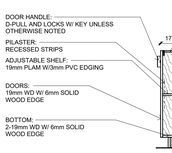

4.3 SECTION

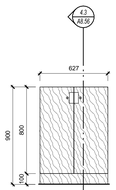

4.2 ELEVATION

3D VIEW

THE 3D VIEW /PERSPECTIVE IS FOR REFERENCE ONLY AND DOES NOT FORM PART OF THE CONTRACT. IT IS INCLUDED TO SHOW THE GENERAL DESIGN INTENT FOR COORDINATION PURPOSES ONLY. THE FINAL PRODDUCT MAY NOT BE AS EXACTLY AS SHOWN.

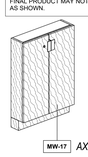

MW-17 *AXONOMETRIC*

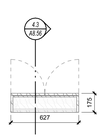

4.1 PLAN

4 / A8.56 MW-17

51mm SOLID SURFACING
MITRED EDGE
51mm SOLID SURFACING
REAR SUPPORT MISC. METAL SUPPORT AS REQUIRED

2.3 SECTION

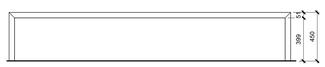

2.2 ELEVATION

3D VIEW

THE 3D VIEW /PERSPECTIVE IS FOR REFERENCE ONLY AND DOES NOT FORM PART OF THE CONTRACT. IT IS INCLUDED TO SHOW THE GENERAL DESIGN INTENT FOR COORDINATION PURPOSES ONLY. THE FINAL PRODUCT MAY NOT BE AS EXACTLY AS SHOWN.

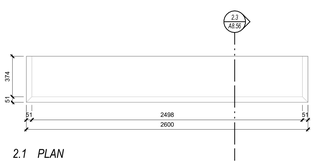

2.1 PLAN

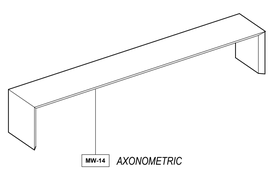

MW-14 *AXONOMETRIC*

2 / A8.56 MW-14

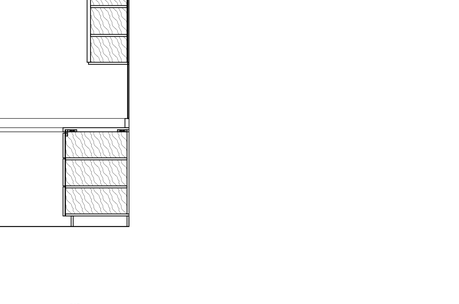

1.4 SECTION

1.3 MW-13B ELEVATION

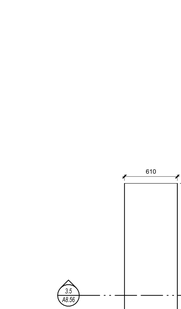

1.2 MW-13A ELEVATION

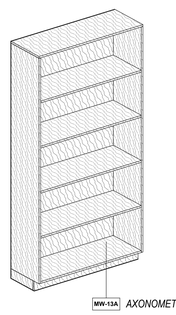

MW-13A *AXONOMETRIC*

3D VIEW

THE 3D VIEW /PERSPECTIVE IS FOR REFERENCE ONLY AND DOES NOT FORM PART OF THE CONTRACT. IT IS INCLUDED TO SHOW THE GENERAL DESIGN INTENT FOR COORDINATION PURPOSES ONLY. THE FINAL PRODUCT MAY NOT BE AS EXACTLY AS SHOWN.

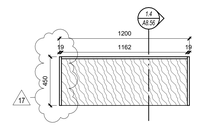

1.1 PLAN

1 / A8.56 MW-13

A0

FILENAME: Autodesk Docs://21032 Sterling Hall/21032_SHS-A-MAIN-25.rvt

DRAWING LAST EDITED: 2026-07-27 4:50:42 PM

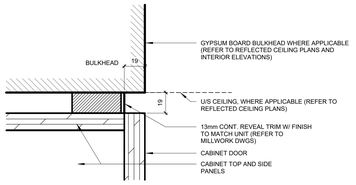

8 A8.60 SECTION DETAIL - TYP. CABINET TOP REVEAL AT CLG/BULKHEAD

1 : 2

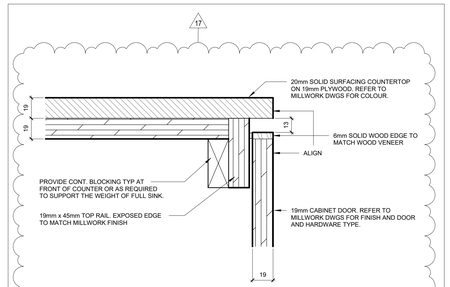

4 A8.60 SECTION DETAIL - TYP. SOLID SURFACING CABINET TOP

1 : 2

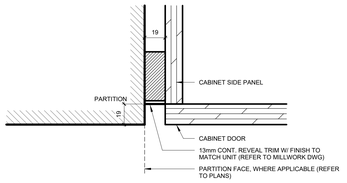

7 A8.60 PLAN DETAIL - TYP. CABINET SIDE REVEAL AT PARTITION

1 : 2

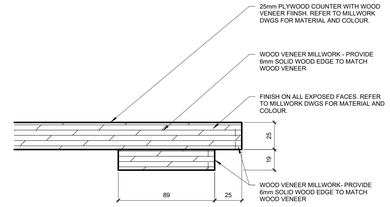

3 A8.60 SECTION DETAIL - TYP. CLASSROOM (WINDOW WALL) COUNTER TOPS

1 : 2

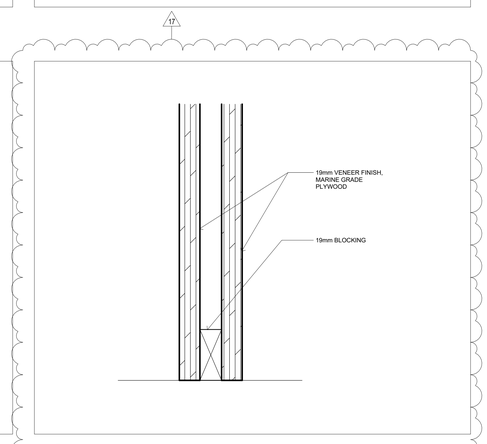

10 A8.60 SECTION DETAIL - TYP. GABLE

1 : 2

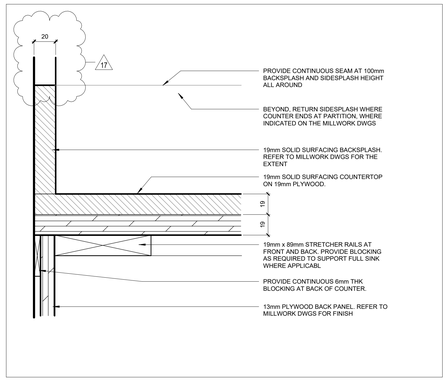

6 A8.60 SECTION DETAIL - TYP. SOLID SURFACING COUNTER BACKSPLASH

1 : 2

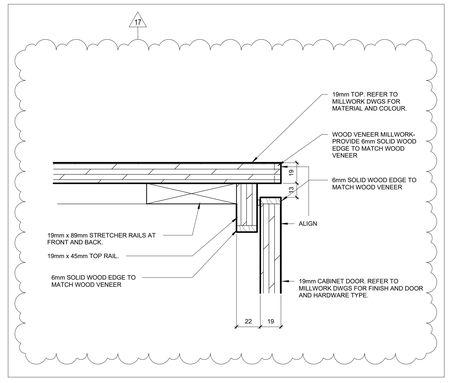

2 A8.60 SECTION DETAIL - TYP. CABINET TOP WITHHOUT BULKHEAD

1 : 2

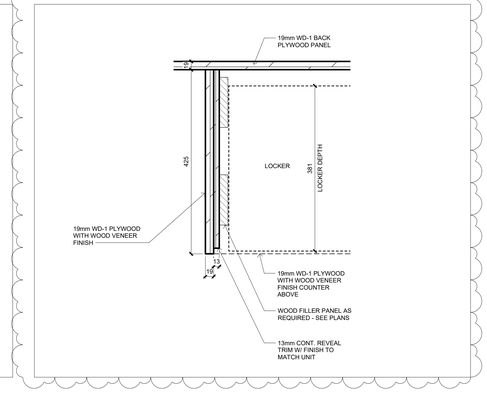

9 A8.60 PLAN DETAIL - TYP. LOCKER SURROUND

1 : 5

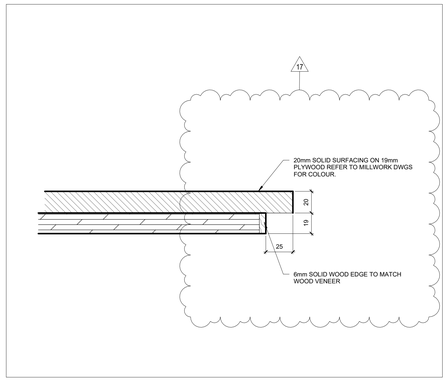

5 A8.60 SECTION DETAIL - TYP. SOLID SURFACING FOR OPEN SHELVING

1 : 2

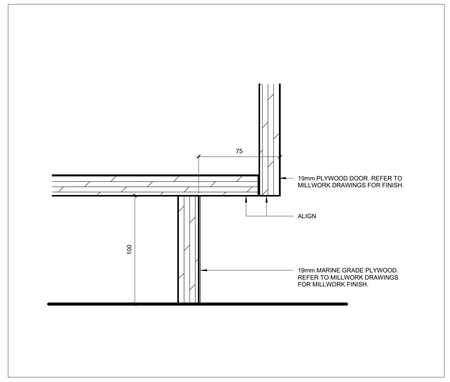

1 A8.60 SECTION DETAIL - TYP. BASE CONDITION

1 : 2

Key to Detail Location

NO. — Detail Number
NO. — Drawing Number

If this sheet is not 46 7/8" x 33 1/8" (1189 x 841 mm) it is a reduced print - Read dwg. accordingly.

Contractors must check and verify all dimensions on the job and report any discrepancies to the Architect before proceeding with the work.

All prints and specifications are the property of the Architect and must be returned at the completion of the work.

Drawings should not be scaled.

No	Date	Revision/Issued
15	2026.07.08	ISSUED FOR TENDER
17	2026.07.27	ISSUED FOR ADDENDA 3

consultants

architect — CS&P Architects Inc.
2345 Yonge St., Suite 200
Toronto, ON, M4P 2E5
Phone.416.482.5002
Fax.416.482.5040

civil engineer — SCS Consulting Group Ltd.
30 Centurian Drive, Suite 100
Markham, ON, L3R 8B8
Phone.905.475.1900
Fax.905.475.8335

structural engineer — LEA Consulting Ltd.
40 University Ave, Suite 503
Toronto, ON, M5J 1T1
Phone.905.470.0015

mechanical engineer — Smith + Andersen
4211 Yonge Street
Toronto, ON, M2P 2A9
Phone.416.487.8151

electrical engineer — Smith + Andersen
4211 Yonge Street
Toronto, ON, M2P 2A9
Phone.416.487.8151

landscape architect — Quinn Design Associates Inc.
180 John Street
Toronto, ON, M5T 1X5
Phone.416.962.8700

SHS CS&P Architects

THE STERLING HALL SCHOOL

99 Cartwright Avenue, Toronto, ON M6A 1V4

MILLWORK DETAILS

scale:	As indicated
date:	10/09/25
drawn:	CS&P
checked by:	CA
project number:	21032
drawing number:	A8.60
	Revision: 17

A0

FILENAME: Autodesk Docs://21032 Sterling Hall/21032_SHS-A-MAIN-25.rvt

DRAWING LAST EDITED: 2026-07-27 4:50:44 PM

DOOR SCHEDULE

DOOR NUMBER	ROOM NAME	DOOR					GLAZING MATERIAL	FRAME			FIRE RATING	STC RATING	HARDWARE												NOTES
		TYPE	WIDTH	HEIGHT	MATERIAL	FINISH		MATERIAL	FINISH	DEPTH			ADO	CR	DA	DC	EL	ES	FED	HOD	K	LBM	MLK	MRX	
LOWER LEVEL																									
001	MAKER SPACE	C	1100	2350	WD.1	CLEAR	TGL	ALUM	ANOD																AS02
002	FLEXIBLE SPACE	C	1100	2350	WD.1	CLEAR	TGL	ALUM	ANOD																AS01
003	ELEC. CLOSET	A	1100	2350	HM	PT	-	HM	PT	210	45MIN														
004	ELEV ROOM	A	1100	2350	HM	PT	-	HM	PT	150	45MIN														
005	MECHANICAL	A	1100	2030	HM	PT	-	HM	PT	150	45MIN														LOW CEILING BELOW SLAB, OBC MINIMUM HEIGHT MUST BE MAINTAINED
006	BF WC	A	1100	2350	WD.1	CLEAR	-	HM	PT	150			•			•									
007	SECURE STORAGE	C	1100	2350	WD.1	CLEAR	TGL	HM	PT	150															
E-0	CORRIDOR																								REFER TO ELEVATOR SPECIFICATIONS
ST-B0	STAIR B	B	1100	2350	HM	PT	FRGL	HM	PT		45MIN								•						MS01
ST-C0	STAIR C	B	1100	2030	HM	PT	FRGL	HM	PT		45MIN								•						MS03, LOW CEILING BELOW SLAB, OBC MINIMUM HEIGHT MUST BE MAINTAINED
WEST ENTRY FFE																									
ST-C1	STAIR C	B	1100	2150	HM	PT	FRGL	HM	PT		45MIN														
GROUND LEVEL (184.00m)																									
100A	MAIN VEST.	2x C	2000	2350	ALUM	ANOD	TGL	ALUM	ANOD	0			•			•									AS04
100B	MAIN VEST.	2x C	2000	2350	ALUM	ANOD	TGL	ALUM	ANOD	0			•			•									AS04
103	MEETING	C	1000	2350	WD.1	CLEAR	TGL	ALUM	ANOD	150															
104	WR	A	950	2350	WD.1	CLEAR	-	HM	PT	150															
104A	STALL	A	650	2150	HM	PT	-	HM	PT	150															
104B	STALL	A	650	2150	HM	PT	-	HM	PT	150															
104C	STALL	A	650	2150	HM	PT	-	HM	PT	150															
104D	CLOSET	A	580	2150	HM	PT	-	HM	PT	150															
105	UNIV. WR	A	1100	2350	HM	CLEAR	-	HM	PT	150			•			•									
106	EX. IT	A	1030	2350	EX. HM	PT	-	EX. HM	PT	150															EXISTING DOOR AND FRAME TO BE REINSTATED, REFINISHED
107	EX. OFFICE	A	1000	2150	WD.1	CLEAR	TGL	ALUM	ANOD																AS10
109	EX. OFFICE	A	1000	2150	WD.1	CLEAR	TGL	ALUM	ANOD																AS11
110	EX. MECHANICAL	2x A	1800	2350	EX. HM	PT	-	EX. HM	PT	150	45MIN														EXISTING DOOR AND FRAME TO BE REINSTATED, REFINISHED
111	OFFICE	A	1000	2350	WD.1	CLEAR	-	ALUM	ANOD																AS13
112	OFFICE	A	1000	2350	WD.1	CLEAR	-	ALUM	ANOD																AS14
113	PRAYER ROOM	C	1000	2350	ALUM	ANOD	TGL	ALUM	ANOD																AS16, DOOR GLAZING TO BE FULLY FROSTED FILM
114	VESTIBULE	2x C	1900	2350	ALUM	ANOD	TGL	ALUM	ANOD	0															AS17
115		2x C	1900	2350	ALUM	ANOD	TGL	ALUM	ANOD	0															
C101A	CORRIDOR	2x C	1900	2350	HM	PT	FRNT	HM	PT	355	30MIN														MS18, THRESHOLD TO BE 400MM + DOOR WIDTH
C101B	CORRIDOR	2x C	1900	2350	HM	PT	FRNT	HM	PT	355	30MIN														MS07, THRESHOLD TO BE 400MM x DOOR WIDTH
E-1	CORRIDOR																								REFER TO ELEVATOR SPECIFICATIONS
ST-A1	STAIR A	C	1100	2350	HM	PT	FRGL	HM	PT		45MIN														MS06
ST-B1	STAIR B	E	1100	2350	HM	PT	FRGL	HM	PT		45MIN														MS01
X100A	MAIN VEST.	2x C	2000	2335	ALUM	ANOD	TGL	ALUM	ANOD	0			•			•									CW01
X100B	MAIN VEST.	2x C	2000	2335	ALUM	ANOD	TGL	ALUM	ANOD	0			•	•		•									CW01
X101A	CORRIDOR	C	1000	2350	ALUM	ANOD	TGL	ALUM	ANOD										•						CW17
X101F	CORRIDOR	C	1000	2350	ALUM	ANOD	TGL	ALUM	ANOD																CW09
X114	VESTIBULE	2x C	2000	2335	ALUM	ANOD	TGL	ALUM	ANOD	0															CW12
XC110	EX. CORRIDOR	C	1200	2350	ALUM	ANOD	TGL	ALUM	ANOD										•						
XST-A1	STAIR A	C	1100	2335	ALUM	ANOD	TGL	ALUM	ANOD										•						CW07
XST-B1	STAIR B	C	1100	2350	ALUM	ANOD	TGL	ALUM	ANOD										•						CW02
XST-C1	STAIR C	C	1100	2150	HM	PT	FRGL	HM	PT																CW06
GROUND LEVEL - UPPER																									
120	CLASSROOM	A	1000	2350	WD.1	CLEAR	TGL	ALUM	ANOD																AS21R
121	BREAKOUT	C	1000	2350	WD.1	CLEAR	TGL	ALUM	ANOD																AS22
121A	BREAKOUT	C	1000	2350	ALUM	ANOD	TGL	ALUM	ANOD																AS40
121B	BREAKOUT	D	1000	2350	ALUM	ANOD	TGL	HM	PT	150															
122	CLASSROOM	A	1000	2350	WD.1	CLEAR	TGL	ALUM	ANOD																AS21
123	IT/STORAGE	A	1000	2350	WD.1	PT	-	HM	PT	150															
124	STAFF WR	A	1000	2350	HM	PT	-	HM	PT	150															
125	STAFF BFWR	A	1000	2350	HM	PT	-	HM	PT	150			•			•									
126	STUDENT WR	A	1100	2350	WD.1	CLEAR	TGL	ALUM	ANOD				•	•		•		•						•	AS24, DOOR GRILLE REQUIRED
126A	BF STALL	A	1000	2150	HM	PT	-	HM	PT	150			•			•									DOOR UNDERCUT BY 100MM
126B	STALL	A	650	2150	HM	PT	-	HM	PT	150															DOOR UNDERCUT BY 100MM
126C	STALL	A	650	2150	HM	PT	-	HM	PT	150															DOOR UNDERCUT BY 100MM
127	CLASSROOM	A	1000	2350	WD.1	CLEAR	TGL	ALUM	ANOD																AS21
128	BREAKOUT	C	1000	2350	WD.1	CLEAR	TGL	ALUM	ANOD																AS22
128A	BREAKOUT	C	1000	2350	ALUM	ANOD	TGL	ALUM	ANOD																AS40R
128B	BREAKOUT	C	1000	2350	ALUM	ANOD	TGL	ALUM	ANOD																AS40R
129	CLASSROOM	A	1000	2350	WD.1	CLEAR	TGL	ALUM	ANOD																AS21R
E-U	ELEV																								REFER TO ELEVATOR SPECIFICATIONS
ST-AU	STAIR A	C	1100	2350	HM	PT	FRGL	HM	PT		45MIN														MS11
ST-BU	STAIR B	E	1100	2350	HM	PT	FRGL	FRGL	PT	210	45MIN														
GROUND LEVEL - MEZZ																									
130	STAFF	C	1000	2150	WD.1	CLEAR	TGL	ALUM	ANOD																AS25
E-M	MEZZ. CORRIDOR																								
ST-BM	STAIR B	E	1100	2150	HM	PT	FRGL	HM	PT	210															
SECOND LEVEL																									
200	VESTIBULE	C	1100	2350	ALUM	ANOD	TGL	ALUM	ANOD																AS27
201	CLASSROOM	A	1000	2350	WD.1	CLEAR	TGL	ALUM	ANOD																AS21R
202	BREAKOUT	C	1000	2350	WD.1	CLEAR	TGL	ALUM	ANOD																AS22
202A	BREAKOUT	C	1000	2350	ALUM	ANOD	TGL	ALUM	ANOD																AS40
202B	BREAKOUT	D	1000	2350	ALUM	ANOD	TGL	HM	PT	150															
203	CLASSROOM	A	1000	2350	WD.1	CLEAR	TGL	ALUM	ANOD																AS21
204	ELECTRICAL	A	1000	2350	HM	PT	-	HM	PT	210	45MIN														
205	STAFF WR	A	1000	2350	HM	PT	-	HM	PT	150															
206	STAFF BFWR	A	1000	2350	HM	PT	-	HM	PT	150															
207	STUDENT WR	A	1100	2350	WD.1	CLEAR	TGL	ALUM	ANOD				•	•		•		•						•	AS24, DOOR GRILLE REQUIRED
207A	BF STALL	A	1000	2150	HM	PT	-	HM	PT	150															DOOR UNDERCUT BY 100MM
207B	STALL	A	650	2150	HM	PT	-	HM	PT	150															DOOR UNDERCUT BY 100MM
207C	STALL	A	650	2150	HM	PT	-	HM	PT	150															DOOR UNDERCUT BY 100MM
208	CLASSROOM	A	1000	2350	WD.1	CLEAR	TGL	ALUM	ANOD																AS21
209	BREAKOUT	C	1000	2350	WD.1	CLEAR	TGL	ALUM	ANOD																AS22
209B	BREAKOUT	C	1000	2350	ALUM	ANOD	TGL	ALUM	ANOD																AS40R
209C	BREAKOUT	C	1000	2350	ALUM	ANOD	TGL	ALUM	ANOD																AS40R
210	CLASSROOM	A	1000	2350	WD.1	CLEAR	TGL	ALUM	ANOD																AS21R
211	JAN.	A	950	2350	WD.1	PT	-	HM	PT	150															
212	MEETING	C	1000	2150	WD.1	CLEAR	TGL	ALUM	ANOD																AS29
E-2	CORRIDOR																								REFER TO ELEVATOR SPECIFICATIONS
ST-A2	STAIR A	C	1100	2350	HM	PT	FRGL	HM	PT		45MIN														MS14
ST-B2	STAIR B	B	1100	2350	HM	PT	FRGL	HM	PT		45MIN														MS01
X200	VESTIBULE	C	1100	2335	ALUM	ANOD	TGL	ALUM	ANOD																CW29
XST-A2	STAIR A	C	1100	2335	ALUM	ANOD	TGL	ALUM	ANOD										•						CW27
UNDERSIDE OF HIGH ROOF DECK																									
X211																									

Abbreviations - Doors

Abbreviation	Description
GENERAL	
COL	COILING
DBL	DOUBLE
DR	DOOR
ELV	ELEVATOR
GTE	GATE
KNL	KENNEL
OHD	OVERHEAD
PNL	PANEL (CW)
RHD	ROOF HATCH
SGL	SINGLE
SLD	SLIDING
TRK	TRACK
HARDWARE	
ADO	AUTOMATIC DOOR OPENER
CR	CARD READER
DA	DOOR ALARM
DC	DOOR CLOSER
EL	ELECTRIC LOCK
ES	ELECTRIC STRIKE
K	KEY PAD
LBM	LATCH BOLT MONITOR
MLK	MAGNETIC LOCK
MRX	MOTION REQUEST TO EXIT
REX	REQUEST TO EXIT

DOOR TYPES

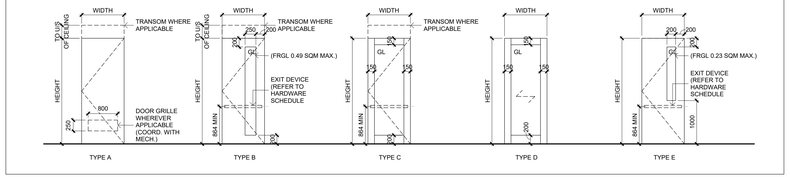

Key to Detail Location

NO. / NO. — Detail Number / Drawing Number

If this sheet is not 46 7/8" x 33 1/8" (1189 x 841 mm) it is a reduced print - Read dwg. accordingly.

Contractors must check and verify all dimensions on the job and report any discrepancies to the Architect before proceeding with the work.

All prints and specifications are the property of the Architect and must be returned at the completion of the work.

Drawings should not be scaled.

No	Date	Revision/Issued
10	2026 03 13	ISSUED FOR PERMIT
11	2026 04 10	75% CD FOR CLIENT REVIEW
14	2026 05 15	90% CD FOR CLIENT REVIEW
15	2026 07 08	ISSUED FOR TENDER
16	2026 07 17	ISSUED FOR ADDENDA 1
17	2026 07 27	ISSUED FOR ADDENDA 3

consultants

architect — CS&P Architects Inc., 2345 Yonge St., Suite 200, Toronto, ON, M4P 2E5, Phone.416.482.5002, Fax.416.482.5040

civil engineer — SCS Consulting Group Ltd., 30 Centurian Drive, Suite 100, Markham, ON, L3R 8B8, Phone.905.475.1900, Fax.905.475.8335

structural engineer — LEA Consulting Ltd., 40 University Ave, Suite 503, Toronto, ON, M5J 1T1, Phone.905.470.0015

mechanical engineer — Smith + Andersen, 4211 Yonge Street, Toronto, ON, M2P 2A9, Phone.416.487.8151

electrical engineer — Smith + Andersen, 4211 Yonge Street, Toronto, ON, M2P 2A9, Phone.416.487.8151

landscape architect — Quinn Design Associates Inc., 180 John Street, Toronto, ON, M5T 1X5, Phone.416.962.8700

CS&P Architects

THE STERLING HALL SCHOOL

99 Cartwright Avenue, Toronto, ON M6A 1V4

DOOR SCHEDULE

scale:	1 : 50
date:	03/13/26
drawn:	CS&P
checked by:	CA
project number:	21032
drawing number:	A9.00
	Revision: 17

A0

FILENAME: Autodesk Docs://21032 Sterling Hall/21032_SHS-A-MAIN-25.rvt

DRAWING LAST EDITED: 2026-07-27 4:50:46 PM

General Notes - Finishes

1	ROOM FINISHES PLAN SHALL BE READ IN CONJUNCTION WITH GENERAL NOTES, SPECIFICATIONS AND DRAWINGS. COLOUR SELECTION WILL BE MADE BY CONSULTANT AT LATER DATE.
2	REFER TO DRAWINGS FOR EXTENT OF BULKHEADS
3	HEATING UNITS, RECESSED CONVECTORS, FORCED FLOW HEATERS, FIRE EXTINGUISHER CABINETS, GRILLES, DOOR GRILLES, ACCESS PANELS, WALL FINS, EXPOSED PIPES AND HANGERS, EXPOSED SPRINKLER LINES, MISCELLANEOUS METAL, SHALL BE PAINTED TO MATCH THE SURFACE ON WHICH THEY OCCUR, UNLESS NOTED OTHERWISE. COLOUR TO BE CONFIRMED WITH CONSULTANT PRIOR TO APPLICATION.
4	CAULKING COLORS TO BE SELECTED BY CONSULTANT.
5	EXPOSED STEEL COLUMNS, STEEL CHANNELS, AND HSS TO BE PAINTED, COLOUR TO BE SELECTED BY CONSULTANT.
6	COLOURS OF ALL FLOOR TRANSITION STRIPS TO BE SELECTED BY CONSULTANT.
7	AT EXPOSED CEILINGS WHERE THERE IS DUCTWORK, SERVICE LINES, AND MISCELLANEOUS METALS, THESE ITEMS SHALL BE PAINTED DIFFERENT COLOURS (HOLD UP TO 3) TO BE SELECTED BY CONSULTANT.
8	REFER TO DRAWINGS FOR ACOUSTICAL SEPARATION CEILING DETAILS ABOVE SUSPENDED CEILINGS.
9	THE FOLLOWING WALLS SHALL RECEIVE NO BASE, UNLESS NOTED OTHERWISE:
9.1	ALL EXPOSED CONCRETE BLOCK WALLS (CMU)
9.2	ALL EXPOSED ARCHITECTURAL MASONRY
9.3	ALL EXPOSED ARCHITECTURAL CONCRETE WALLS AND COLUMNS
9.4	ALL EXPOSED EXISTING BRICK WALLS

FLOOR FINISH LEGEND

CPT.X	CARPET TILE	CT.2	TILE
CPT.1	CARPET TILE	PCONC.1	POLISHED CONCRETE
CPT.2	CARPET TILE	SCONC.1	SEALED CONCRETE
CPT.3	CARPET TILE	EX.CONC.1	EXISTING CONCRETE
CPT.4	CARPET TILE	RSF.1	RESILIENT FLOORING
CT.X	TILE	RSF.2	RESILIENT FLOORING
CT.1	TILE		

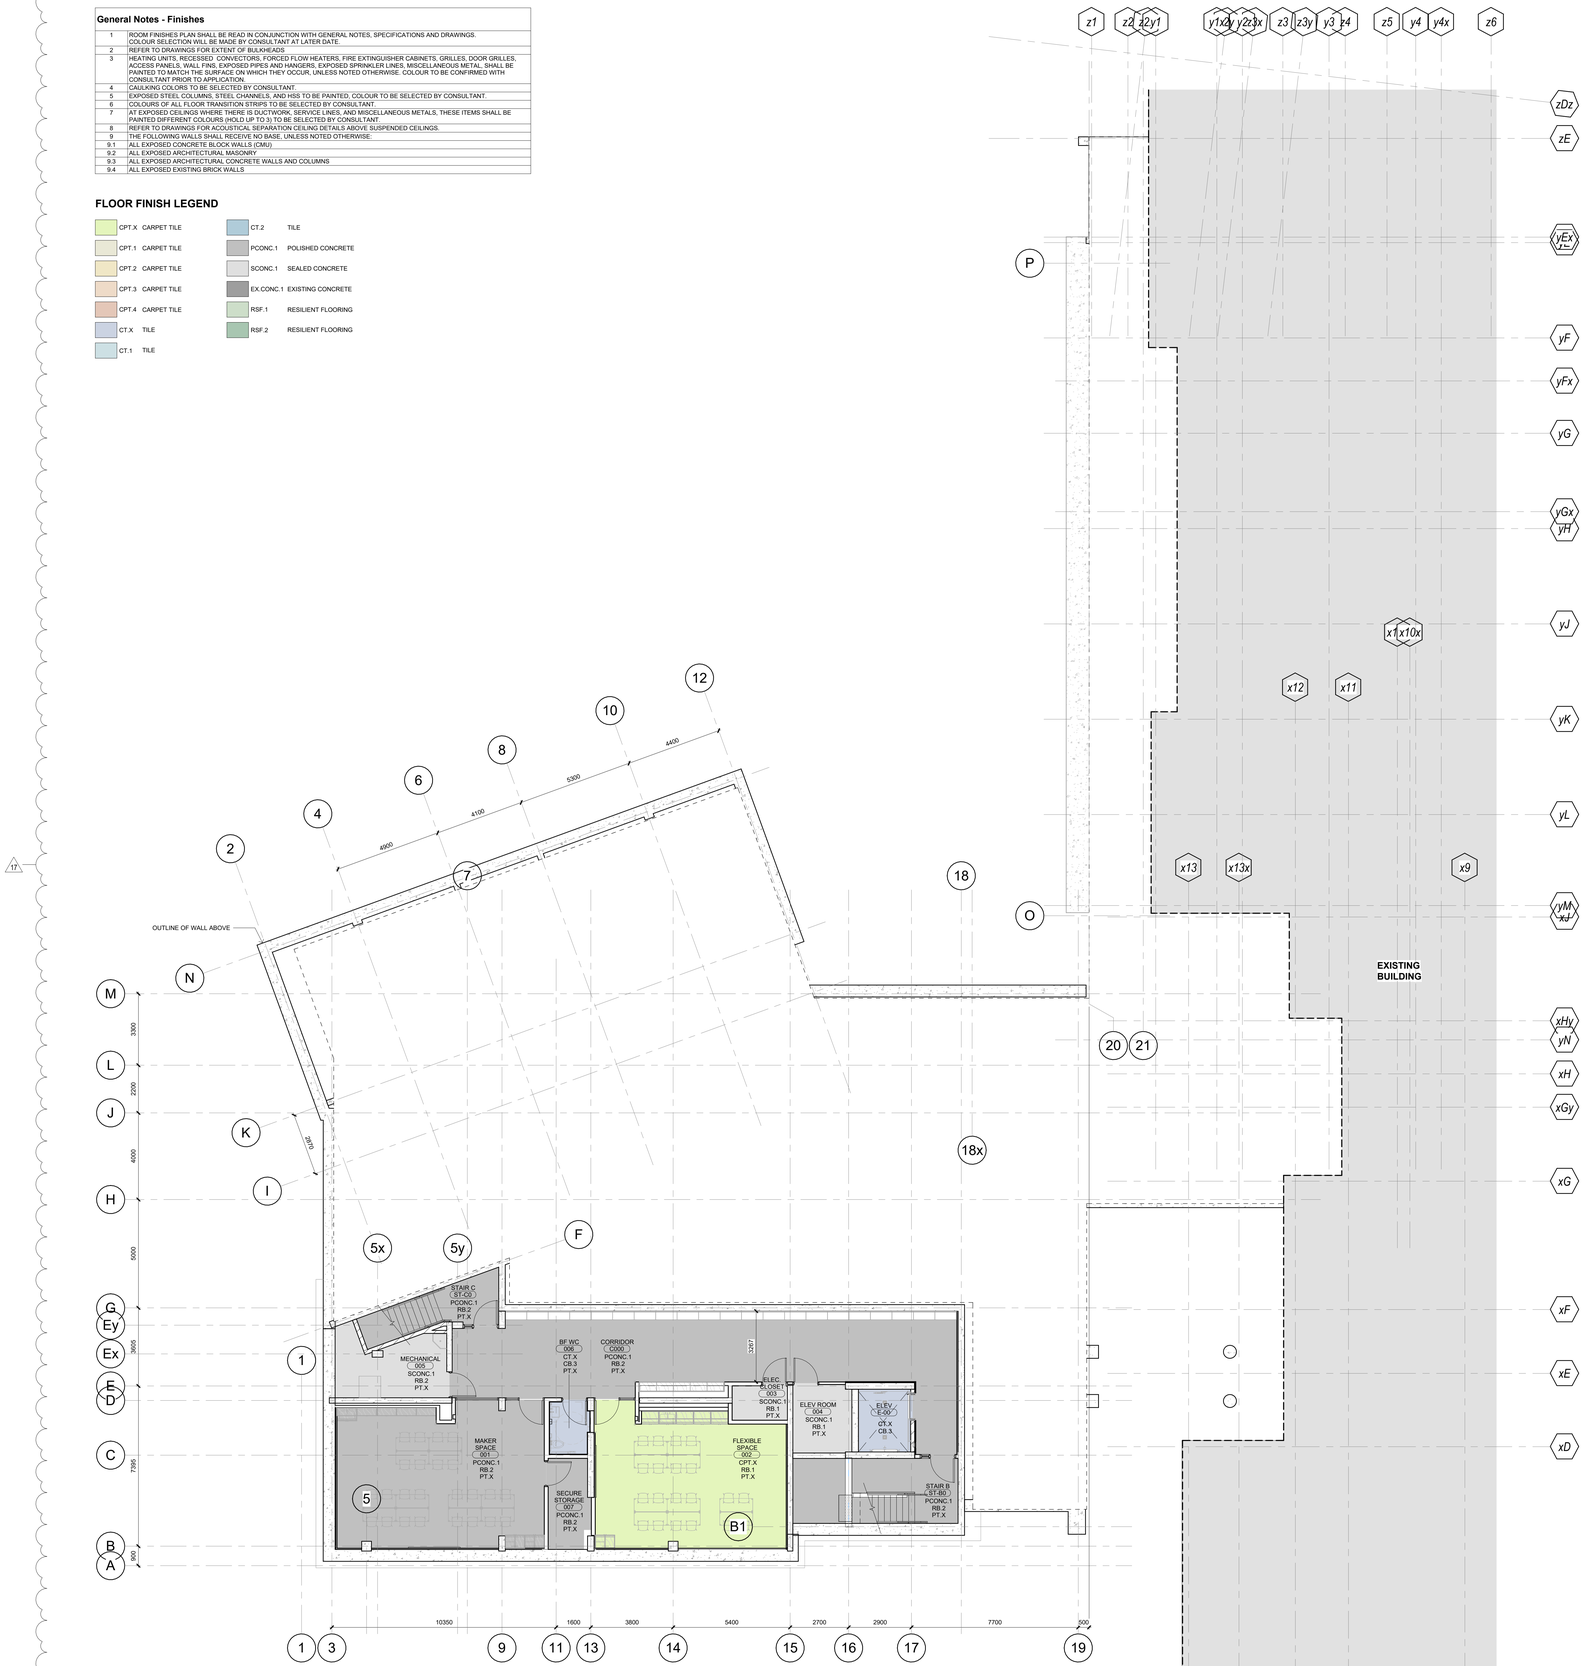

Key to Detail Location

NO. — Detail Number
NO. — Drawing Number

If this sheet is not 46 7/8" x 33 1/8" (1189 x 841 mm) it is a reduced print - Read dwg. accordingly.

Contractors must check and verify all dimensions on the job and report any discrepancies to the Architect before proceeding with the work.

All prints and specifications are the property of the Architect and must be returned at the completion of the work.

Drawings should not be scaled.

No	Date	Revision/Issued
9	2025 12 15	30% CD FOR CLIENT REVIEW
10	2026 03 13	ISSUED FOR PERMIT
11	2026 04 10	75% CD FOR CLIENT REVIEW
14	2026 05 15	90% CD FOR CLIENT REVIEW
15	2026 07 08	ISSUED FOR TENDER
17	2026 07 27	ISSUED FOR ADDENDA 3

consultants

architect — CS&P Architects Inc., 2345 Yonge St., Suite 200, Toronto, ON, M4P 2E5, Phone.416.482.5002, Fax.416.482.5040

civil engineer — SCS Consulting Group Ltd., 30 Centurian Drive, Suite 100, Markham, ON, L3R 8B8, Phone.905.475.1900, Fax.905.475.8335

structural engineer — LEA Consulting Ltd., 40 University Ave, Suite 503, Toronto, ON, M5J 1T1, Phone.905.470.0015

mechanical engineer — Smith + Andersen, 4211 Yonge Street, Toronto, ON, M2P 2A9, Phone.416.487.8151

electrical engineer — Smith + Andersen, 4211 Yonge Street, Toronto, ON, M2P 2A9, Phone.416.487.8151

landscape architect — Quinn Design Associates Inc., 180 John Street, Toronto, ON, M5T 1X5, Phone.416.962.8700

PROJECT NORTH

SHS CS&P Architects

THE STERLING HALL SCHOOL

99 Cartwright Avenue, Toronto, ON M6A 1V4

FINISHES PLAN - LOWER LEVEL & ROOM FINISH SCHEDULE

scale:	1 : 100
date:	10/16/20
drawn:	CS&P
checked by:	CA
project number:	21032
drawing number:	A9.10
	Revision: 17

A0

FILENAME: Autodesk Docs://21032 Sterling Hall/21032_SHS-A-MAIN-25.rvt

DRAWING LAST EDITED: 2026-07-27 4:50:52 PM

General Notes - Finishes

1	ROOM FINISHES PLAN SHALL BE READ IN CONJUNCTION WITH GENERAL NOTES, SPECIFICATIONS AND DRAWINGS. COLOUR SELECTION WILL BE MADE BY CONSULTANT AT LATER DATE.
2	REFER TO DRAWINGS FOR EXTENT OF BULKHEADS
3	HEATING UNITS, RECESSED CONVECTORS, FORCED FLOW HEATERS, FIRE EXTINGUISHER CABINETS, GRILLES, DOOR GRILLES, ACCESS PANELS, WALL FINS, EXPOSED PIPES AND HANGERS, EXPOSED SPRINKLER LINES, MISCELLANEOUS METAL, SHALL BE PAINTED TO MATCH THE SURFACE ON WHICH THEY OCCUR, UNLESS NOTED OTHERWISE. COLOUR TO BE CONFIRMED WITH CONSULTANT PRIOR TO APPLICATION.
4	CAULKING COLORS TO BE SELECTED BY CONSULTANT.
5	EXPOSED STEEL COLUMNS, STEEL CHANNELS, AND HSS TO BE PAINTED, COLOUR TO BE SELECTED BY CONSULTANT.
6	COLOURS OF ALL FLOOR TRANSITION STRIPS TO BE SELECTED BY CONSULTANT.
7	AT EXPOSED CEILINGS WHERE THERE IS DUCTWORK, SERVICE LINES, AND MISCELLANEOUS METALS, THESE ITEMS SHALL BE PAINTED DIFFERENT COLOURS (HOLD UP TO 3) TO BE SELECTED BY CONSULTANT.
8	REFER TO DRAWINGS FOR ACOUSTICAL SEPARATION CEILING DETAILS ABOVE SUSPENDED CEILINGS.
9	THE FOLLOWING WALLS SHALL RECEIVE NO BASE, UNLESS NOTED OTHERWISE:
9.1	ALL EXPOSED CONCRETE BLOCK WALLS (CMU)
9.2	ALL EXPOSED ARCHITECTURAL MASONRY
9.3	ALL EXPOSED ARCHITECTURAL CONCRETE WALLS AND COLUMNS
9.4	ALL EXPOSED EXISTING BRICK WALLS

FLOOR FINISH LEGEND

CPT.X	CARPET TILE	CT.2	TILE
CPT.1	CARPET TILE	PCONC.1	POLISHED CONCRETE
CPT.2	CARPET TILE	SCONC.1	SEALED CONCRETE
CPT.3	CARPET TILE	EX.CONC.1	EXISTING CONCRETE
CPT.4	CARPET TILE	RSF.1	RESILIENT FLOORING
CT.X	TILE	RSF.2	RESILIENT FLOORING
CT.1	TILE		

Key to Detail Location

NO. Detail Number
NO. Drawing Number

If this sheet is not 46 7/8" x 33 1/8" (1189 x 841 mm) it is a reduced print - Read dwg. accordingly.

Contractors must check and verify all dimensions on the job and report any discrepancies to the Architect before proceeding with the work.

All prints and specifications are the property of the Architect and must be returned at the completion of the work.

Drawings should not be scaled.

No	Date	Revision/Issued
9	2025 12 15	30% CD FOR CLIENT REVIEW
10	2026 03 13	ISSUED FOR PERMIT
11	2026 04 10	75% CD FOR CLIENT REVIEW
14	2026 05 15	90% CD FOR CLIENT REVIEW
15	2026 07 08	ISSUED FOR TENDER
17	2026 07 27	ISSUED FOR ADDENDA 3

consultants

architect
CS&P Architects Inc.
2345 Yonge St., Suite 200
Toronto, ON, M4P 2E5
Phone.416.482.5002
Fax.416.482.5040

civil engineer
SCS Consulting Group Ltd.
30 Centurian Drive, Suite 100
Markham, ON, L3R 8B8
Phone.905.475.1900
Fax.905.475.8335

structural engineer
LEA Consulting Ltd.
40 University Ave, Suite 503
Toronto, ON, M5J 1T1
Phone.905.470.0015

mechanical engineer
Smith + Andersen
4211 Yonge Street
Toronto, ON, M2P 2A9
Phone.416.487.8151

electrical engineer
Smith + Andersen
4211 Yonge Street
Toronto, ON, M2P 2A9
Phone.416.487.8151

landscape architect
Quinn Design Associates Inc.
180 John Street
Toronto, ON, M5T 1X5
Phone.416.962.8700

PROJECT NORTH

SHS CS&P Architects

THE STERLING HALL SCHOOL

99 Cartwright Avenue, Toronto, ON M6A 1V4

FINISHES PLAN - GROUND LEVEL

scale:	1 : 100
date:	10/09/25
drawn:	CS&P
checked by:	CA
project number:	21032
drawing number:	A9.11
	Revision: 17

A0

FILENAME: Autodesk Docs://21032 Sterling Hall/21032_SHS-A-MAIN-25.rvt

DRAWING LAST EDITED: 2026-07-27 4:50:56 PM

General Notes - Finishes

1	ROOM FINISHES PLAN SHALL BE READ IN CONJUNCTION WITH GENERAL NOTES, SPECIFICATIONS AND DRAWINGS. COLOUR SELECTION WILL BE MADE BY CONSULTANT AT LATER DATE.
2	REFER TO DRAWINGS FOR EXTENT OF BULKHEADS
3	HEATING UNITS, RECESSED CONVECTORS, FORCED FLOW HEATERS, FIRE EXTINGUISHER CABINETS, GRILLES, DOOR GRILLES, ACCESS PANELS, WALL FINS, EXPOSED PIPES AND HANGERS, EXPOSED SPRINKLER LINES, MISCELLANEOUS METAL, SHALL BE PAINTED TO MATCH THE SURFACE ON WHICH THEY OCCUR, UNLESS NOTED OTHERWISE. COLOUR TO BE CONFIRMED WITH CONSULTANT PRIOR TO APPLICATION.
4	CAULKING COLORS TO BE SELECTED BY CONSULTANT.
5	EXPOSED STEEL COLUMNS, STEEL CHANNELS, AND HSS TO BE PAINTED, COLOUR TO BE SELECTED BY CONSULTANT.
6	COLOURS OF ALL FLOOR TRANSITION STRIPS TO BE SELECTED BY CONSULTANT.
7	AT EXPOSED CEILINGS WHERE THERE IS DUCTWORK, SERVICE LINES, AND MISCELLANEOUS METALS, THESE ITEMS SHALL BE PAINTED DIFFERENT COLOURS (HOLD UP TO 3) TO BE SELECTED BY CONSULTANT.
8	REFER TO DRAWINGS FOR ACOUSTICAL SEPARATION CEILING DETAILS ABOVE SUSPENDED CEILINGS.
9	THE FOLLOWING WALLS SHALL RECEIVE NO BASE, UNLESS NOTED OTHERWISE:
9.1	ALL EXPOSED CONCRETE BLOCK WALLS (CMU)
9.2	ALL EXPOSED ARCHITECTURAL MASONRY
9.3	ALL EXPOSED ARCHITECTURAL CONCRETE WALLS AND COLUMNS
9.4	ALL EXPOSED EXISTING BRICK WALLS

FLOOR FINISH LEGEND

CPT.X	CARPET TILE	CT.2	TILE
CPT.1	CARPET TILE	PCONC.1	POLISHED CONCRETE
CPT.2	CARPET TILE	SCONC.1	SEALED CONCRETE
CPT.3	CARPET TILE	EX.CONC.1	EXISTING CONCRETE
CPT.4	CARPET TILE	RSF.1	RESILIENT FLOORING
CT.X	TILE	RSF.2	RESILIENT FLOORING
CT.1	TILE		

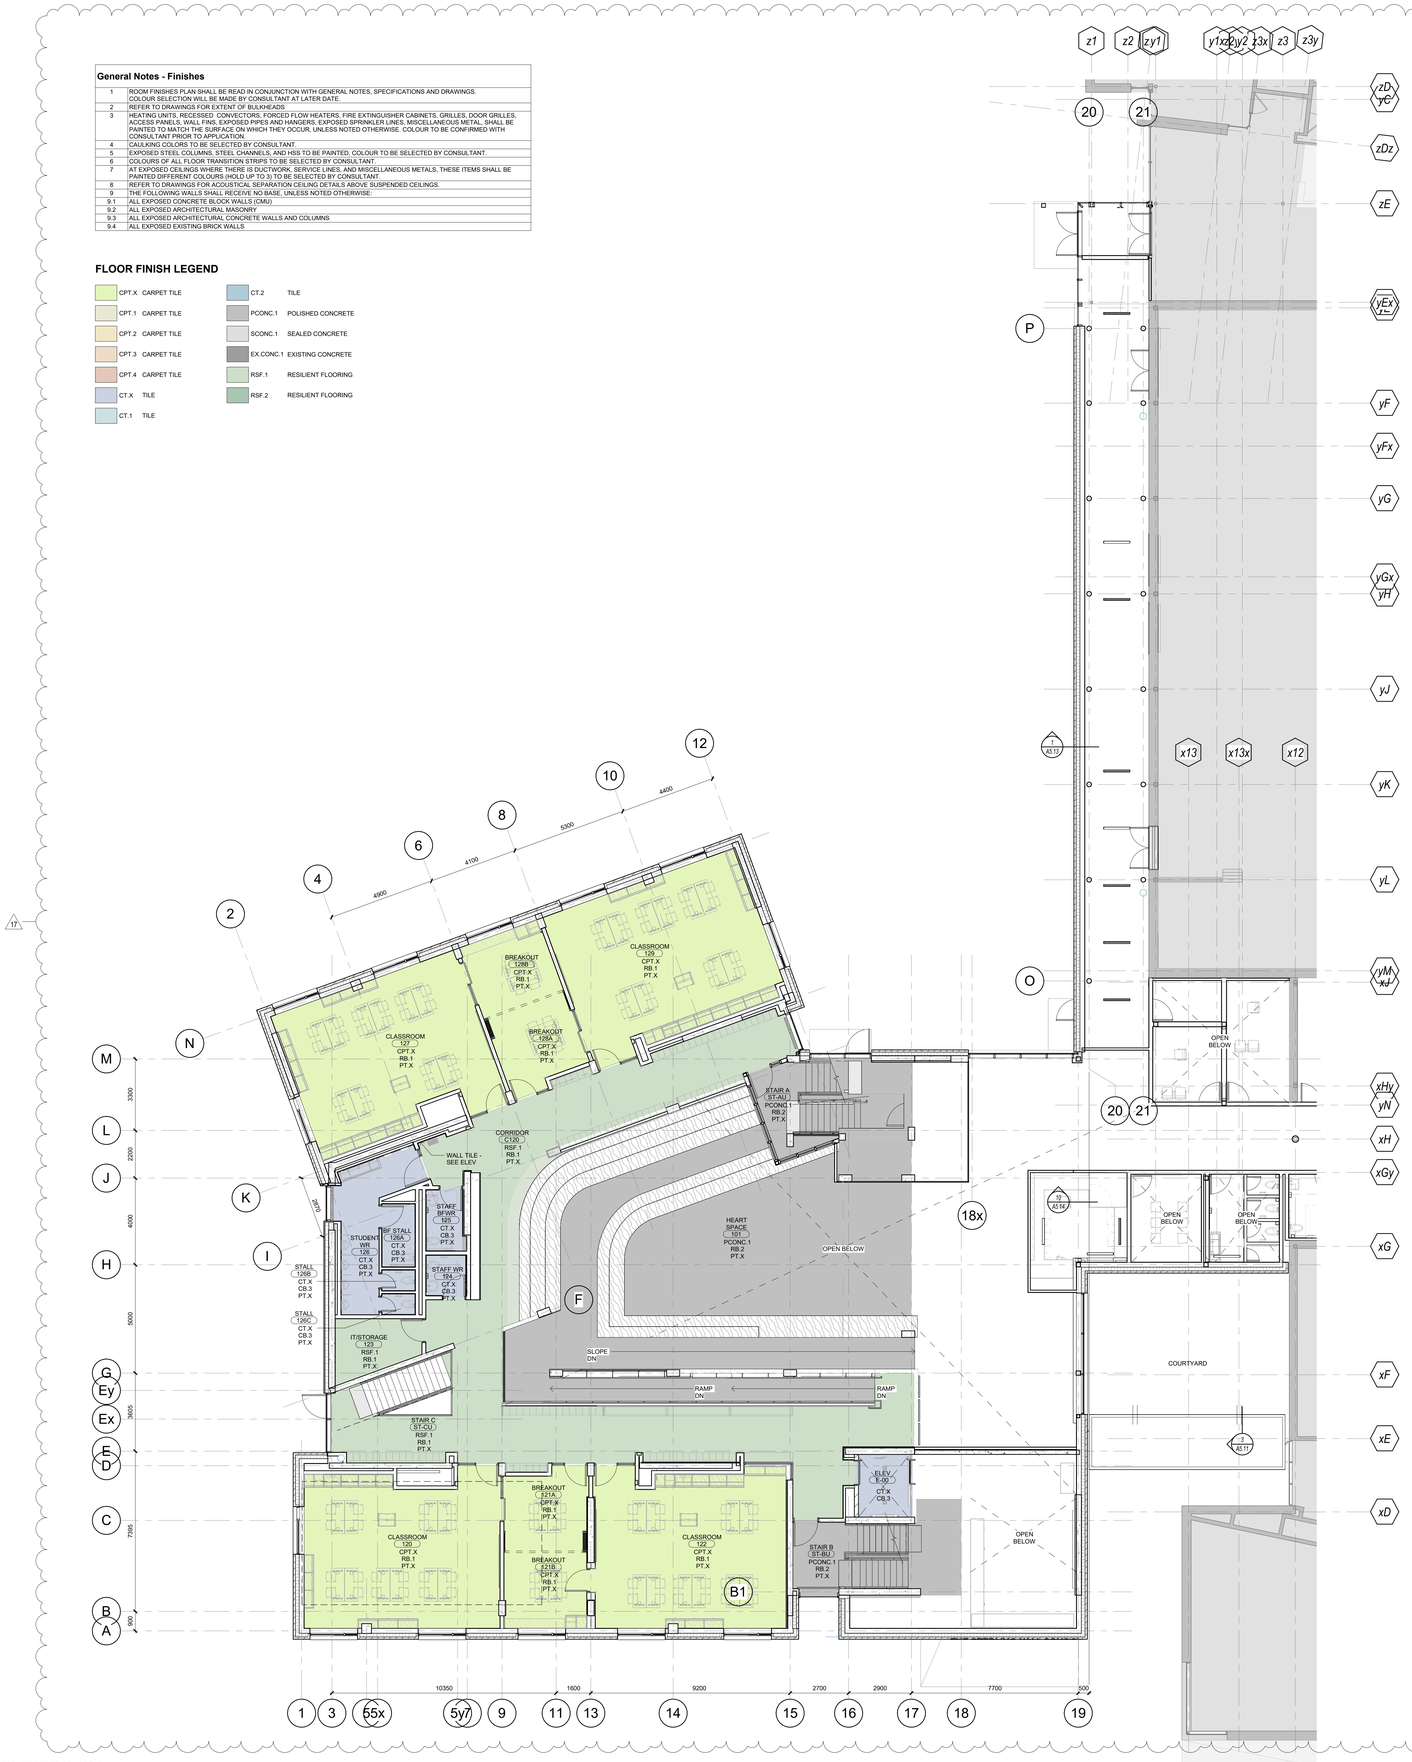

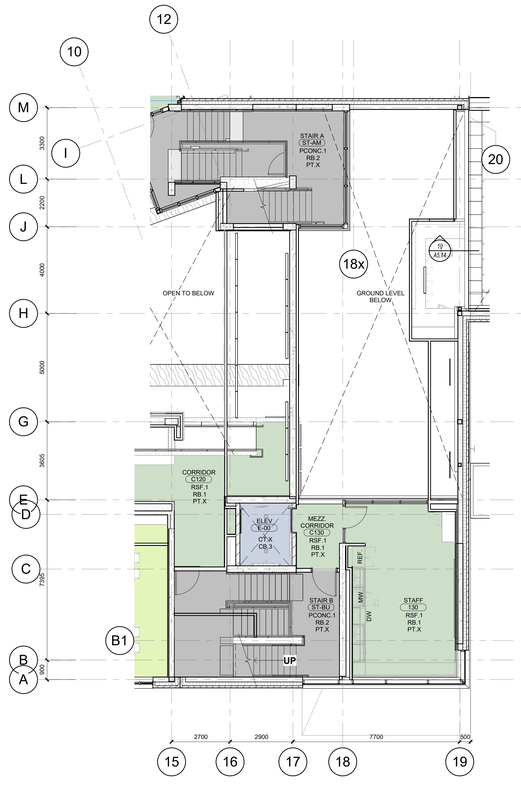

Key to Detail Location

NO. Detail Number
NO. Drawing Number

If this sheet is not 46 7/8" x 33 1/8" (1189 x 841 mm) it is a reduced print - Read dwg. accordingly.

Contractors must check and verify all dimensions on the job and report any discrepancies to the Architect before proceeding with the work.

All prints and specifications are the property of the Architect and must be returned at the completion of the work.

Drawings should not be scaled.

No	Date	Revision/Issued
9	2025 12 15	30% CD FOR CLIENT REVIEW
10	2026 03 13	ISSUED FOR PERMIT
11	2026 04 10	75% CD FOR CLIENT REVIEW
14	2026 05 15	90% CD FOR CLIENT REVIEW
15	2026 07 08	ISSUED FOR TENDER
17	2026 07 27	ISSUED FOR ADDENDA 3

consultants

architect
CS&P Architects Inc.
2345 Yonge St., Suite 200
Toronto, ON, M4P 2E5
Phone.416.482.5002
Fax.416.482.5040

civil engineer
SCS Consulting Group Ltd.
30 Centurian Drive, Suite 100
Markham, ON, L3R 8B8
Phone.905.475.1900
Fax.905.475.8335

structural engineer
LEA Consulting Ltd.
40 University Ave, Suite 503
Toronto, ON, M5J 1T1
Phone.905.470.0015

mechanical engineer
Smith + Andersen
4211 Yonge Street
Toronto, ON, M2P 2A9
Phone.416.487.8151

electrical engineer
Smith + Andersen
4211 Yonge Street
Toronto, ON, M2P 2A9
Phone.416.487.8151

landscape architect
Quinn Design Associates Inc.
180 John Street
Toronto, ON, M5T 1X5
Phone.416.962.8700

PROJECT NORTH

SHS CS&P Architects

THE STERLING HALL SCHOOL

99 Cartwright Avenue, Toronto, ON M6A 1V4

FINISHES PLAN - UPPER GROUND & MEZZANINE LEVEL

scale:	1 : 100
date:	10/09/25
drawn:	CS&P
checked by:	CA
project number:	21032
drawing number:	A9.12
	Revision:17

A0

FILENAME: Autodesk Docs://21032 Sterling Hall/21032_SHS-A-MAIN-25.rvt

_DRAWING LAST EDITED: 2026-07-27 4:51:02 PM

General Notes - Finishes

1	ROOM FINISHES PLAN SHALL BE READ IN CONJUNCTION WITH GENERAL NOTES, SPECIFICATIONS AND DRAWINGS. COLOUR SELECTION WILL BE MADE BY CONSULTANT AT LATER DATE.
2	REFER TO DRAWINGS FOR EXTENT OF BULKHEADS
3	HEATING UNITS, RECESSED CONVECTORS, FORCED FLOW HEATERS, FIRE EXTINGUISHER CABINETS, GRILLES, DOOR GRILLES, ACCESS PANELS, WALL FINS, EXPOSED PIPES AND HANGERS, EXPOSED SPRINKLER LINES, MISCELLANEOUS METAL, SHALL BE PAINTED TO MATCH THE SURFACE ON WHICH THEY OCCUR, UNLESS NOTED OTHERWISE. COLOUR TO BE CONFIRMED WITH CONSULTANT PRIOR TO APPLICATION.
4	CAULKING COLORS TO BE SELECTED BY CONSULTANT.
5	EXPOSED STEEL COLUMNS, STEEL CHANNELS, AND HSS TO BE PAINTED, COLOUR TO BE SELECTED BY CONSULTANT.
6	COLOURS OF ALL FLOOR TRANSITION STRIPS TO BE SELECTED BY CONSULTANT.
7	AT EXPOSED CEILINGS WHERE THERE IS DUCTWORK, SERVICE LINES, AND MISCELLANEOUS METALS, THESE ITEMS SHALL BE PAINTED DIFFERENT COLOURS (HOLD UP TO 3) TO BE SELECTED BY CONSULTANT.
8	REFER TO DRAWINGS FOR ACOUSTICAL SEPARATION CEILING DETAILS ABOVE SUSPENDED CEILINGS.
9	THE FOLLOWING WALLS SHALL RECEIVE NO BASE, UNLESS NOTED OTHERWISE:
9.1	ALL EXPOSED CONCRETE BLOCK WALLS (CMU)
9.2	ALL EXPOSED ARCHITECTURAL MASONRY
9.3	ALL EXPOSED ARCHITECTURAL CONCRETE WALLS AND COLUMNS
9.4	ALL EXPOSED EXISTING BRICK WALLS

FLOOR FINISH LEGEND

CPT.X	CARPET TILE	CT.2	TILE
CPT.1	CARPET TILE	PCONC.1	POLISHED CONCRETE
CPT.2	CARPET TILE	SCONC.1	SEALED CONCRETE
CPT.3	CARPET TILE	EX.CONC.1	EXISTING CONCRETE
CPT.4	CARPET TILE	RSF.1	RESILIENT FLOORING
CT.X	TILE	RSF.2	RESILIENT FLOORING
CT.1	TILE		

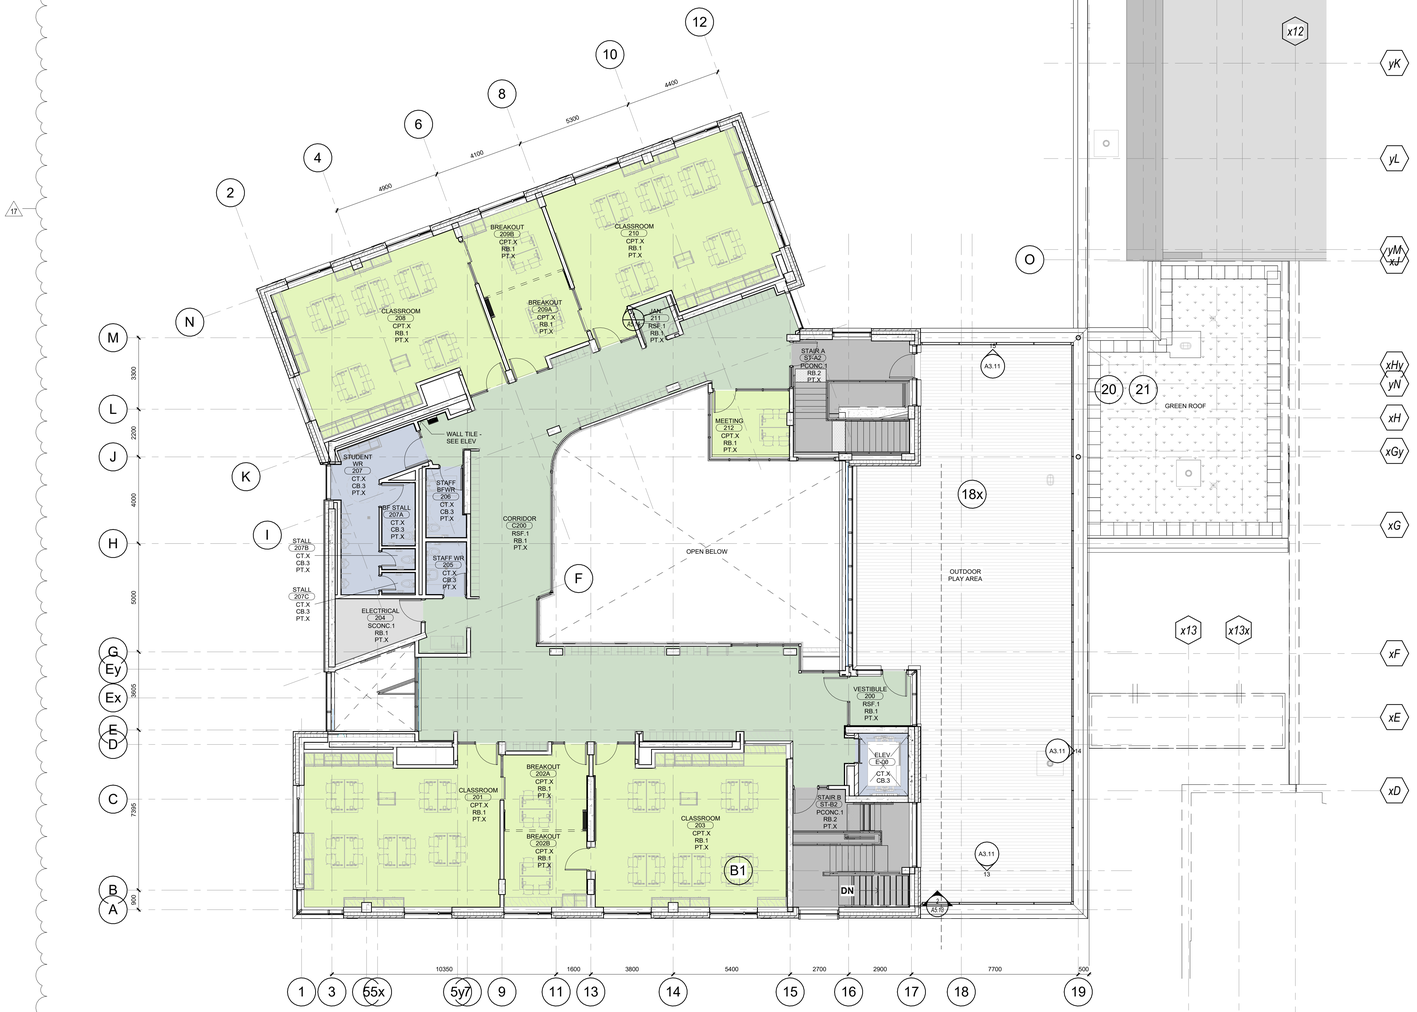

Key to Detail Location

NO. — Detail Number
NO. — Drawing Number

If this sheet is not 46 7/8" x 33 1/8" (1189 x 841 mm) it is a reduced print - Read dwg. accordingly.

Contractors must check and verify all dimensions on the job and report any discrepancies to the Architect before proceeding with the work.

All prints and specifications are the property of the Architect and must be returned at the completion of the work.

Drawings should not be scaled.

No	Date	Revision/Issued
9	2025 12 15	30% CD FOR CLIENT REVIEW
10	2026 03 13	ISSUED FOR PERMIT
11	2026 04 10	75% CD FOR CLIENT REVIEW
14	2026 05 15	90% CD FOR CLIENT REVIEW
15	2026 07 08	ISSUED FOR TENDER
17	2026 07 27	ISSUED FOR ADDENDA 3

consultants

architect — CS&P Architects Inc.
2345 Yonge St., Suite 200
Toronto, ON, M4P 2E5
Phone.416.482.5002
Fax.416.482.5040

civil engineer — SCS Consulting Group Ltd.
30 Centurian Drive, Suite 100
Markham, ON, L3R 8B8
Phone.905.475.1900
Fax.905.475.8335

structural engineer — LEA Consulting Ltd.
40 University Ave, Suite 503
Toronto, ON, M5J 1T1
Phone.905.470.0015

mechanical engineer — Smith + Andersen
4211 Yonge Street
Toronto, ON, M2P 2A9
Phone.416.487.8151

electrical engineer — Smith + Andersen
4211 Yonge Street
Toronto, ON, M2P 2A9
Phone.416.487.8151

landscape architect — Quinn Design Associates Inc.
180 John Street
Toronto, ON, M5T 1X5
Phone.416.962.8700

PROJECT NORTH — N

SHS CS&P Architects

THE STERLING HALL SCHOOL

99 Cartwright Avenue, Toronto, ON M6A 1V4

FINISHES PLAN - SECOND LEVEL

scale:	1 : 100
date:	10/09/25
drawn:	CS&P
checked by:	CA
project number:	21032
drawing number:	A9.13
	Revision: 17

A0

FILENAME: Autodesk Docs://21032 Sterling Hall/21032_SHS-A-MAIN-25.rvt

DRAWING LAST EDITED: 2026-07-27 4:51:08 PM